
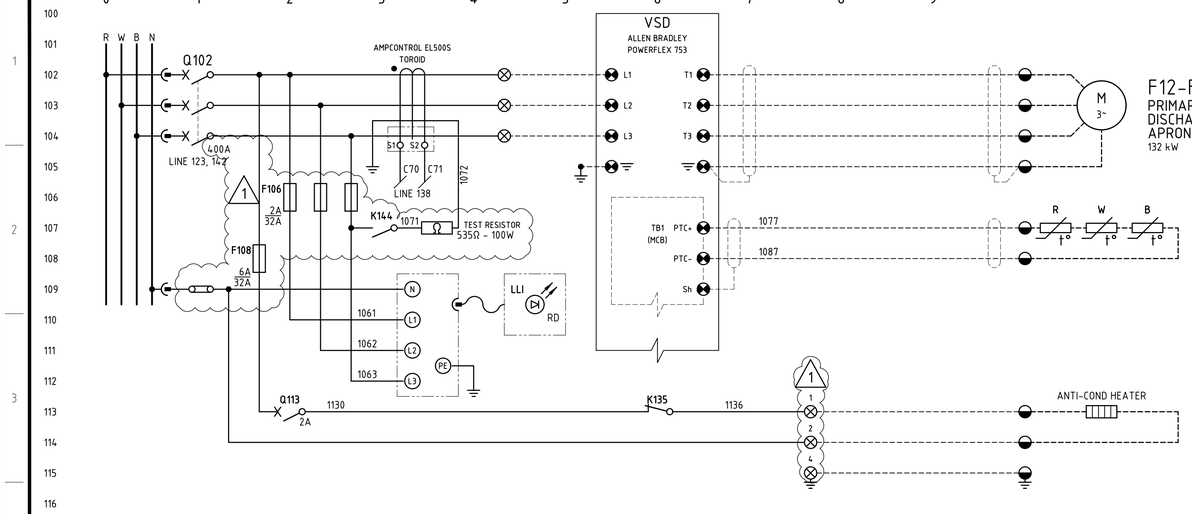


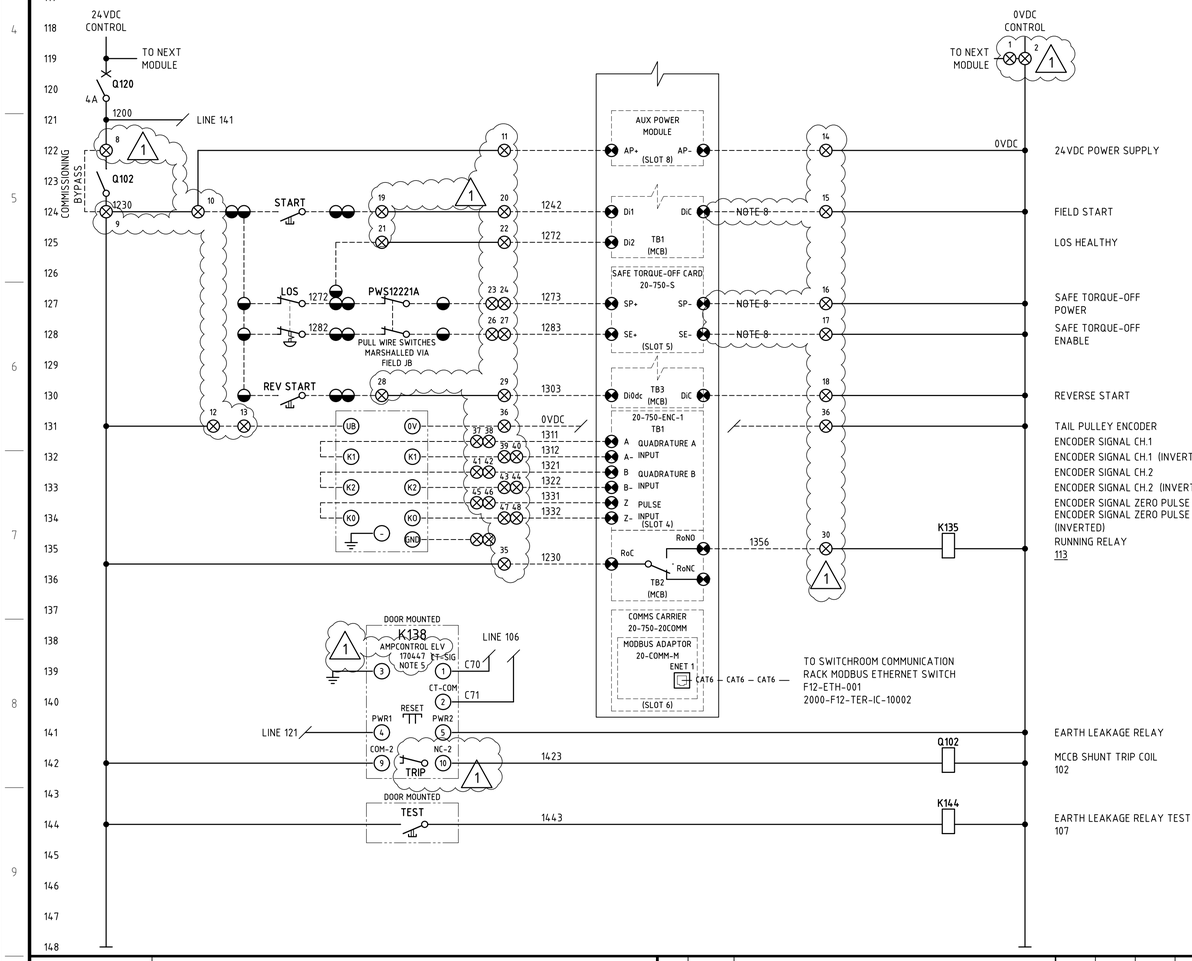

240VAC TERMINALS

1		F12FA401-1136	RD
2		F12FA401-240VN	BK
3			
4	⏚	EARTH	GNYE

NOTE 2, 7

CABLE ZONE
24VDC TERMINALS

24VDC LOOPED POWER
NEXT MODULE PREV MODULE

Q120	4A	F12SW001-2680	
1		F12SW001-2690	
2		F12SW001-2690	
3			
4			
5			
6			
7			
8		F12FA401-1200	
9		F12FA401-1230	COMMISSIONING BYPASS
10		F12FA401-1230	
11		F12FA401-1230	1WH
12		F12FA401-1230	12
13		F12FA401-1230	
14		F12FA401-0VDC	2
15		F12FA401-0VDC	4
16		F12FA401-0VDC	6
17		F12FA401-0VDC	8
18		F12FA401-0VDC	11
19		F12FA401-1242	1BK
20		F12FA401-1242	3
21		F12FA401-1272	2WH
22		F12FA401-1272	9
23		F12FA401-1273	3WH
24		F12FA401-1273	5
25			
26		F12FA401-1283	3BK
27		F12FA401-1283	7
28		F12FA401-1303	2BK
29		F12FA401-1303	10
30		F12FA401-1356	13
31		SPARE	14
32		SPARE	15
33		SPARE	
34		SPARE	
35		ZE12222-1230	4WH
36		ZE12222-0VDC	4BK
37		ZE12222-1311	5WH
38		ZE12222-1311	1WH
39		ZE12222-1312	5BK
40		ZE12222-1312	1BK
41		ZE12222-1321	6WH
42		ZE12222-1321	2WH
43		ZE12222-1322	6BK
44		ZE12222-1322	2BK
45		ZE12222-1331	7WH
46		ZE12222-1331	3WH
47		ZE12222-1332	7BK
48		ZE12222-1332	3BK
49	⏚		
50	⏚	EARTH	GNYE
51	⏚	EARTH	
52	⏚	SCREEN	
53	⏚	SCREEN	

NOTE 2

VSD
CONTROL TERMINALS

AUX POWER

AP+	F12FA401-1230	1
AP-	F12FA401-0VDC	2

MAIN CONTROL BOARD I/O CARD

⏚		
TB1-PTC+	F12FA401-1077	WH
TB1-PTC-	F12FA401-1087	BK
TB1-DiC	F12FA401-0VDC	4
TB1-Di1	F12FA401-1242	3
TB1-Di2	F12FA401-1272	9
TB2-RoNO	F12FA401-1356	13
TB2-RoC	F12FA401-1230	12
TB2-RoNC		
TB3-Di0dc	F12FA401-1303	10
TB3-DiC	F12FA401-0VDC	11
TB3-Di0ac		

ENCODER CARD

A	ZE12222-1311	1WH
A-	ZE12222-1312	1BK
B	ZE12222-1321	2WH
B-	ZE12222-1322	2BK
Z	ZE12222-1331	3WH
Z-	ZE12222-1332	3BK
Sd	SCREEN	

SAFE TORQUE-OFF CARD

SP+	F12FA401-1273	5
SE+	F12FA401-1283	7
SP-	F12FA401-0VDC	6
SE-	F12FA401-0VDC	8

NOTE 6

F12FA401
MOTOR TERMINAL BOX

F12FA401-I1
1.5 mm² 1 Pair O/S
THERMISTORS

F12FA401-P3
2.5 mm² 2C+E
ANTI-COND HEATER

F12FA401VS-C1
1.5 mm² 15C+E

F12FA401VS-C2
1.5 mm² 4 Pair O/S

F12FA401-JB JUNCTION BOX
2000-ME004-D02-10001

F12FA401JB-I2
1.5 mm² 10 Pair I/O/S

3WH	3	
3BK	5	
1WH	28	1
1BK	29	2
2WH	30	3
	32	4
2BK	33	5
	34	GNYE
4WH	45	1WH
4BK	46	1BK
5WH	47	2WH
5BK	48	2BK
6WH	49	3WH
6BK	50	3BK
7WH	51	4WH
7BK	52	4BK

F12FA401-LCS
LOCAL CONTROL STATION

FWR
REV
LOS
GNYE

MULTIPLE PULL WIRE SWITCHES
CABLED TO THIS FIELD JB
PWS12221A, PWS12221B
ZE12222, F12FA401-LCS

F12FA401LCS-C1
1.5mm² 6C+E

ZE12222
CONVEYOR ENCODER

ZE12222-I1
1.5 mm² 4 Pair O/S

NOTES

1. TERMINALS ON TERMINAL STRIPS ABOVE 50VAC SHALL HAVE A SEPARATE PERSPEX SHROUD AND SHALL BE LABELLED "DANGER xxxVAC".
2. WIRE NUMBER FERRULES ON TERMINAL STRIP SHALL BE PREFIXED WITH EQUIPMENT NUMBER e.g. F12FA401-1200, UNLESS OTHERWISE NOTED. (1)
3. EACH WIRE SHALL BE IDENTIFIED AT BOTH ENDS WITH FERRULES.
4. AMPCONTROL 101656 100/1A TOROID. (1)
5. EARTH LEAKAGE RELAY (ELV) USER INTERFACE TO BE MOUNTED ON MCC MODULE DOOR. RELAY ENERGISED (NORMALLY CLOSED CONTACT OPEN) IN NORMAL OPERATION.
6. VSD SHALL BE FRAME SIZE 5 AND ABOVE.
7. 240VAC TERMINALS FOR THE HEATER CIRCUITS SHALL BE LOCATED IN THE MCC DRIVE MODULE.
8. SITE TO MARK UP 0VDC LINKING IN THE VSD AS THE SWITCHROOM MANUFACTURER HAS NOT PROVIDE THIS WIRING DETAIL. (1)

LEGEND

- 00/01/00 — DCS DIGITAL INPUT
- 00/02/00 — DCS DIGITAL OUTPUT
- MCC TERMINAL
- VSD TERMINAL
- FIELD TERMINAL
- DCS OR I/O TERMINAL
- MARSHALLING TERMINAL
- DEVICE TERMINAL
- INDICATION LAMP cc = COLOUR

(1)

TERMINATION LEGEND

Q120	4A	F12SW001-2xxx	
1		F12SW001-2xxx	
2		F12SW001-2xxx	
3		F12FA401-1096	RD
4		F12FA401-1106	BK
5		F12FA401-1116	GNYE
6	⏚	EARTH	

- CORE COLOUR/ IDENTIFIER
- BARRIER
- FERRULE
- JUMPER/DISCONNECT/ FUSE/EARTH
- TERMINAL No.
- DESTINATION

REV	DATE	DESCRIPTION	DRAW	CHECK	DESIGN	TECH APP	PROJ APP
1	17JUL25	FAT REDLINES INCORPORATED					
0	16SEP24	APPROVED FOR CONSTRUCTION					

DRG No.	REFERENCES
2000-F12-SLD-EL-10201	F12-SW-001 415V MCC SINGLE LINE DIAGRAM SHEET 1
2000-F00-STD-EL-10001	GENERAL NOTES AND STANDARD DRAWINGS INDEX

NORTHERN STAR RESOURCES LIMITED

PRIMERO
primero.com.au | DESIGN | CONSTRUCT | OPERATE

PRIMERO PROJECT NUMBER: 23517

INFORMATION AND REPRESENTATIONS ON THIS DRAWING ARE THE INTELLECTUAL PROPERTY OF PRIMERO UNLESS SPECIFICALLY IDENTIFIED OTHERWISE. ALL RIGHTS INCLUDING USE RESERVED

PROJECT: NORTHERN STAR RESOURCES LTD
KCGM GROWTH PROJECT

TITLE: PRIMARY CRUSHING - F12-SW-001
F12-FA-401 PRIMARY CRUSHER 2 DISCHARGE APRON FE
SCHEMATIC AND TERMINATION DIAGRAM

SHEET	SCALE	DRG No.	REVISION
A1	NONE	2000-F12-SCM-EL-10213	1

O:\CAD PROJECTS\23S NORTHERN STAR RESOURCES LTD\23517 KCGM GROWTH PROJECT\03 DELIVERABLES\ELV\F12 - PRIMARY CRUSHING\2000-F12-SCM-EL-10213.DWG 13AUG25 11:33AM HOTSEAT04