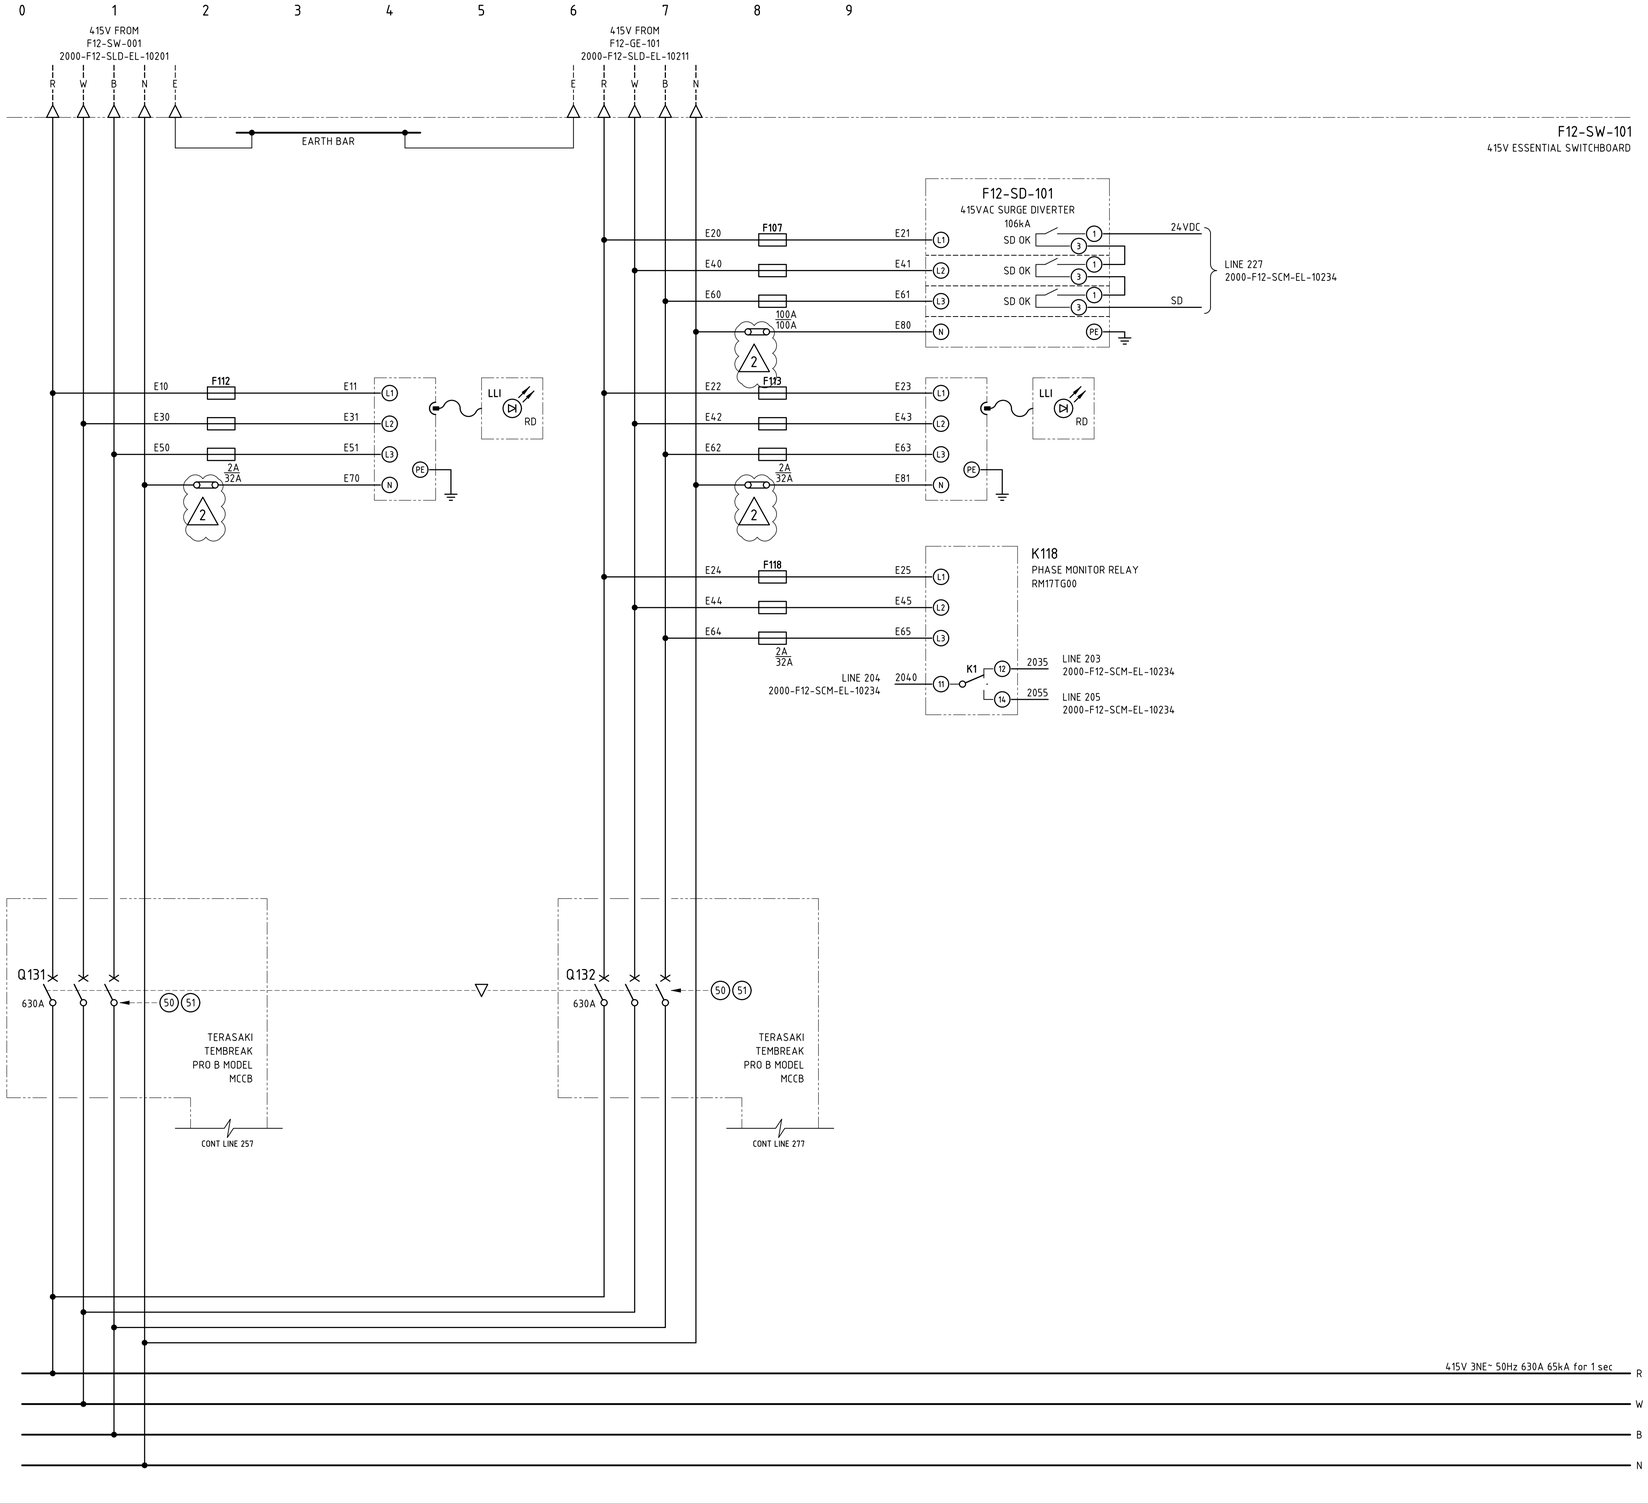



## NOTES

1. SURGE DIVERTERS SHALL PROVIDE FEEDBACK TO DCS VIA VOLT-FREE CONTACTS. SURGE DIVERTER FUSES SHALL BE SIZED BY VENDOR TO SUIT DUTY.
2. MINIATURE CIRCUIT BREAKERS SHALL BE SIZED AND RATED TO SUIT ACB AND INCOMER REQUIREMENTS.
3. ALL TERMINATIONS ABOVE 50VAC SHALL BE TO IP2x OR ABOVE, IF NOT, TO HAVE A SEPARATE PERSPEX SHROUD FITTED AND SHALL BE LABELLED "DANGER xxxVAC".
4. WIRE NUMBER FERRULES ON TERMINAL STRIP SHALL BE PREFIXED WITH EQUIPMENT NUMBER e.g. F12SW101-0600, UNLESS OTHERWISE NOTED.
5. EACH WIRE SHALL BE IDENTIFIED AT BOTH ENDS WITH FERRULES.

## LEGEND

- 00/01/00 — DCS DIGITAL INPUT
- 00/02/00 — DCS DIGITAL OUTPUT
- MCC TERMINAL
- VSD TERMINAL
- FIELD TERMINAL
- DCS OR I/O TERMINAL
- MARSHALLING TERMINAL
- DEVICE TERMINAL
- INDICATION LAMP cc = COLOUR

| DRG No. | REFERENCES |
|---|---|
| 2000-F12-SCM-EL-10234 | F12-SW-101 415V ESSENTIAL SWITCHBOARD SCHEMATIC DIAGRAM SHEET 2 |
| 2000-F12-SLD-EL-10211 | F12-SW-101 415V ESSENTIAL SWITCHBOARD SINGLE LINE DIAGRAM SHEET 1 |
| 2000-F12-SLD-EL-10201 | F12-SW-101 415V MCC SINGLE LINE DIAGRAM SHEET 1 |
| 2000-F00-DRG-EL-10001 | GENERAL NOTES AND STANDARD DRAWINGS INDEX |

| REV | DATE | DESCRIPTION | DRAW | CHECK | DESIGN | TECH APP | PROJ APP |
|---|---|---|---|---|---|---|---|
| 2 | 15JUL25 | FAT REDLINES INCORPORATED | | | | | |
| 1 | 07APR25 | GENERATOR INCOMER ELR SHUNT TRIP ADDED | | | | | |
| 0 | 16SEP24 | APPROVED FOR CONSTRUCTION | | | | | |

NORTHERN STAR RESOURCES LIMITED

INFORMATION AND REPRESENTATIONS ON THIS DRAWING ARE THE INTELLECTUAL PROPERTY OF PRIMERO UNLESS SPECIFICALLY IDENTIFIED OTHERWISE. ALL RIGHTS INCLUDING USE RESERVED

PRIMERO
primero.com.au | DESIGN | CONSTRUCT | OPERATE

PRIMERO PROJECT NUMBER: 23517

PROJECT: NORTHERN STAR RESOURCES LTD
KCGM GROWTH PROJECT

TITLE: PRIMARY CRUSHING - F12-SW-101
F12-SW-101 415V ESSENTIAL SWITCHBOARD INCOMER
SCHEMATIC DIAGRAM SHEET 1

| SHEET | SCALE | DRG No. | REVISION |
|---|---|---|---|
| A1 | NONE | 2000-F12-SCM-EL-10233 | 2 |

O:\CAD PROJECTS\235 NORTHERN STAR RESOURCES LTD\23517 KCGM GROWTH PROJECT\03 DELIVERABLES\E\F12 - PRIMARY CRUSHING\2000-F12-SCM-EL-10233.DWG 13AUG25 11:43AM HOTSEAT04