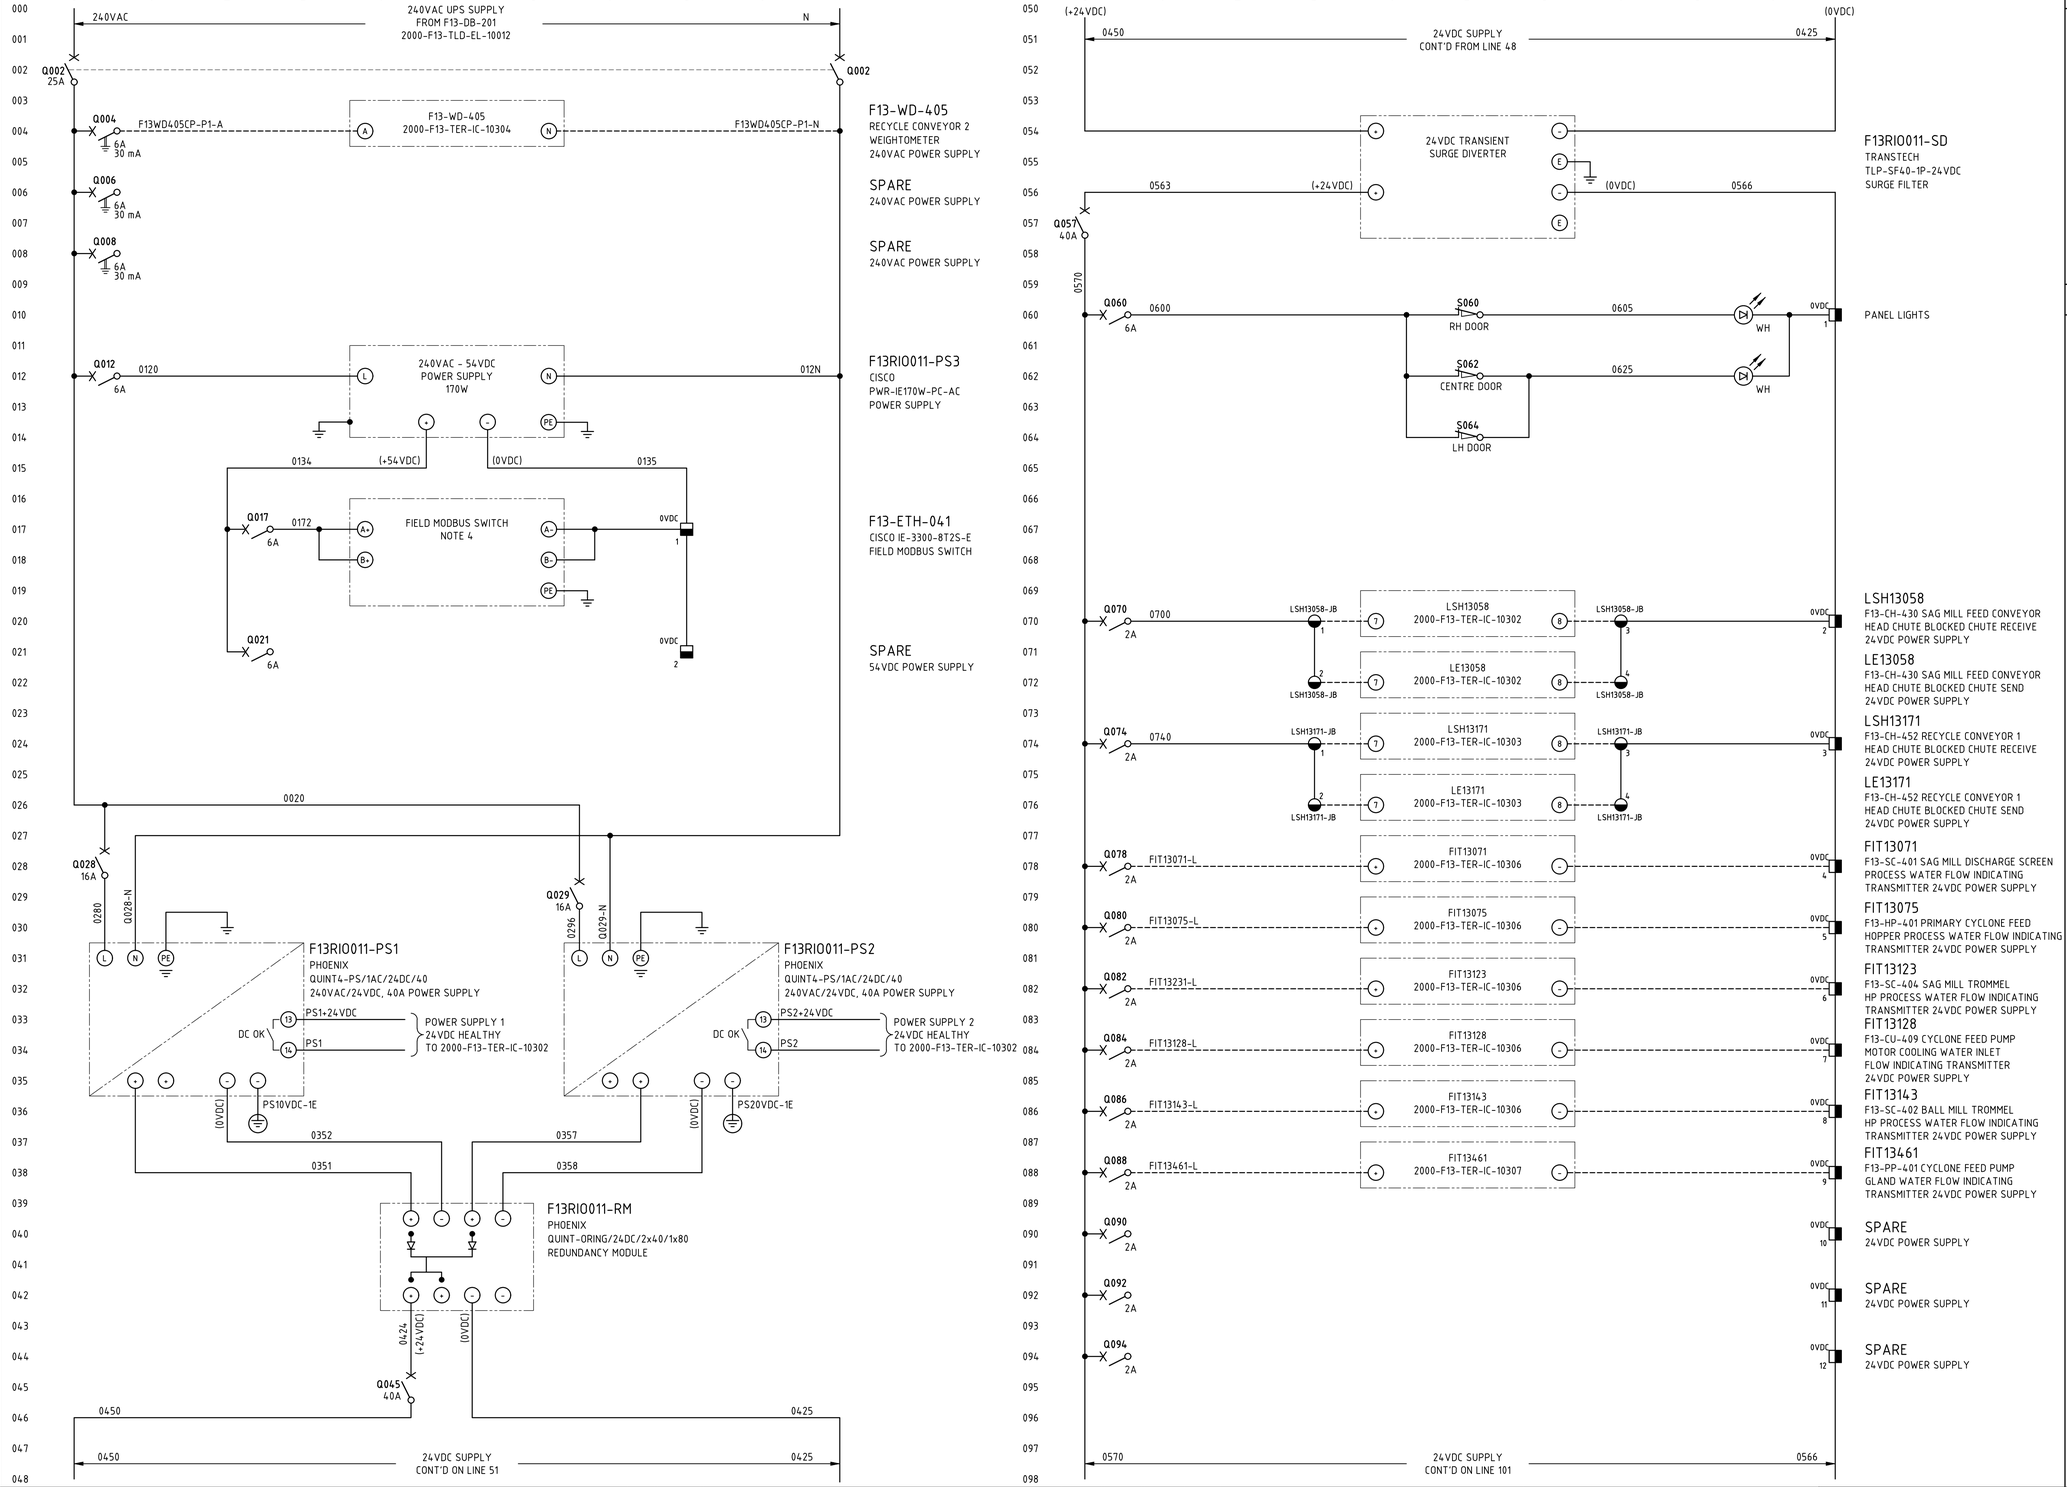



## NOTES

1. TERMINALS ON TERMINAL STRIPS ABOVE 50VAC SHALL HAVE A SEPARATE PERSPEX SHROUD AND SHALL BE LABELLED "DANGER xxxVAC".
2. WIRE NUMBER FERRULES ON TERMINAL STRIP SHALL BE PREFIXED WITH EQUIPMENT NUMBER e.g. F13RI0011-xxxx.
3. EACH WIRE SHALL BE IDENTIFIED AT BOTH ENDS WITH FERRULES.
4. FOR NETWORK CONNECTION & BUS CABLING DETAILS REFER TO DCS OR RIO PANEL COMMUNICATIONS TERMINATION DIAGRAMS.
5. INSTRUMENT EARTH BAR TO BE BONDED TO MAIN EARTH BAR WITH SOLID COPPER LINK.

## LEGEND

- FIELD TERMINAL
- DCS OR I/O TERMINAL
- 0VDC TERMINAL FOR 24VDC
- 0VDC TERMINAL FOR 54VDC
- DEVICE TERMINAL
- INDICATION LAMP (cc = COLOUR)
- EARTH BAR
- INSTRUMENT EARTH BAR

| DRG No. | REFERENCES |
|---|---|
| 2000-F13-TLD-EL-10012 | F13-DB-201 SAG MILL LV SWITCHROOM 240VAC UPS DB THREE LINE DIAGRAM |
| 2000-F13-DRG-IC-10301 | F13-RIO-011 FIELD N-IO PANEL GENERAL ARRANGEMENT |
| 2000-F13-SCM-IC-10302 | F13-RIO-011 FIELD N-IO PANEL SCHEMATIC DIAGRAM SHEET 2 |
| 2000-F13-TER-IC-10300 | F13-RIO-011 FIELD N-IO PANEL COMMS TERMINATION DIAGRAM SHEET 1 (TO SHEET 2 -10301) |
| 2000-F13-TER-IC-10302 | F13-RIO-011 FIELD N-IO PANEL TERMINATION DIAGRAM SHEET 1 (TO SHEET 8 -10309) |
| 2000-F00-STD-EL-10001 | GENERAL NOTES AND STANDARD DRAWINGS INDEX |

| REV | DATE | DESCRIPTION | DRAW | CHECK | DESIGN | TECH APP | PROJ APP |
|---|---|---|---|---|---|---|---|
| 2 | 18SEP26 | KCGM GROWTH PROJECT - SP1 AS-BUILT | | | | | |
| 1 | 28JAN25 | LIGHT & SIGNAL ADDED | | | | | |
| 0 | 06NOV24 | APPROVED FOR CONSTRUCTION | | | | | |

NORTHERN STAR RESOURCES LIMITED

PRIMERO
primero.com.au | DESIGN | CONSTRUCT | OPERATE

PRIMERO PROJECT NUMBER: 23517

INFORMATION AND REPRESENTATIONS ON THIS DRAWING ARE THE INTELLECTUAL PROPERTY OF PRIMERO UNLESS SPECIFICALLY IDENTIFIED OTHERWISE. ALL RIGHTS INCLUDING USE RESERVED

PROJECT: NORTHERN STAR RESOURCES LTD
KCGM GROWTH PROJECT

TITLE: MILLING & CLASSIFICATION
F13-RIO-011 MILLING & CLASSIFICATION FIELD N-IO PANEL
SCHEMATIC DIAGRAM SHEET 1

| SHEET | SCALE | DRG No. | REVISION |
|---|---|---|---|
| A1 | NONE | 2000-F13-SCM-IC-10301 | 2 |

O:\CAD PROJECTS\235 NORTHERN STAR RESOURCES LTD\23517 KCGM GROWTH PROJECT\03 DELIVERABLES\IC\F13 - MILLING & CLASSIFICATION\2000-F13-SCM-IC-10301.DWG 15SEP26 11:00AM GRENVILLE.DEASY