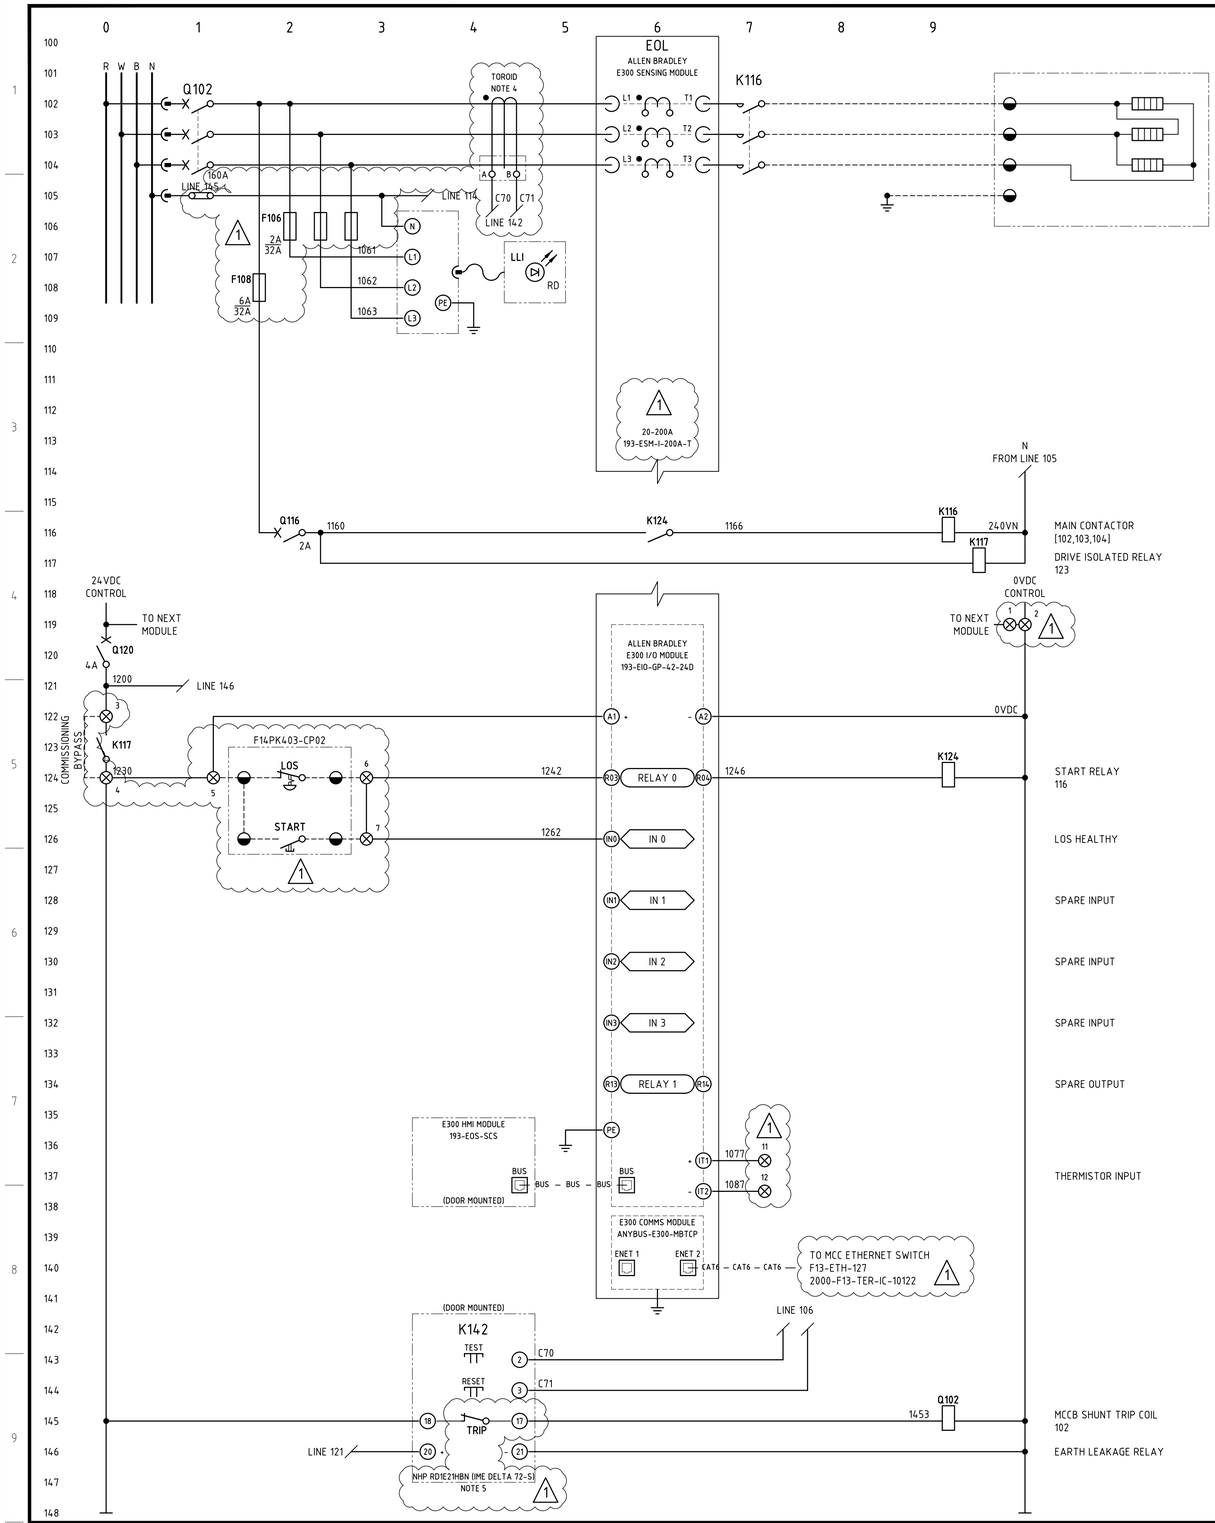


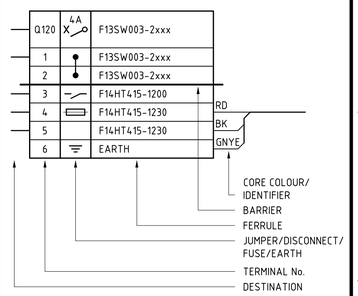

## NOTES

1. TERMINALS ON TERMINAL STRIPS ABOVE 50VAC SHALL HAVE A SEPARATE PERSPEX SHROUD AND SHALL BE LABELLED "DANGER xxxVAC".
2. WIRE NUMBER FERRULES ON TERMINAL STRIP SHALL BE PREFIXED WITH EQUIPMENT NUMBER e.g. F14HT415-1200, UNLESS OTHERWISE NOTED.
3. EACH WIRE SHALL BE IDENTIFIED AT BOTH ENDS WITH FERRULES.
4. NHP TDGH2
   IN:90A IΔN MIN:0.03A TOROID TO SUIT CABLE DIAMETER.
5. EARTH LEAKAGE RELAY (ELV) USER INTERFACE TO BE MOUNTED ON MCC MODULE DOOR. RELAY ENERGISED (NORMALLY CLOSED CONTACT OPEN) IN NORMAL OPERATION.

## LEGEND

- 00/01/00 — DCS DIGITAL INPUT
- 00/02/00 — DCS DIGITAL OUTPUT
- ⊗ — MCC TERMINAL
- ◕ — VSD TERMINAL
- ◒ — FIELD TERMINAL
- ◑ — DCS OR I/O TERMINAL
- ◧ — MARSHALLING TERMINAL
- (x) — DEVICE TERMINAL
- ⊗cc — INDICATION LAMP, cc = COLOUR

## TERMINATION LEGEND




| REV | DATE | DESCRIPTION | DRAW | CHECK | DESIGN | TECH APP | PROJ APP |
|---|---|---|---|---|---|---|---|
| 1 | 02SEP25 | FAT REDLINES INCORPORATED | | | | | |
| 0 | 07AUG24 | APPROVED FOR CONSTRUCTION | | | | | |

| DRG No. | REFERENCES |
|---|---|
| 2000-F13-SLD-EL-10901 | F13-SW-003 415V MCC SINGLE LINE DIAGRAM SHEET 1 |
| 2000-F00-STD-EL-10001 | GENERAL NOTES AND STANDARD DRAWINGS INDEX |

NORTHERN STAR RESOURCES LIMITED

PRIMERO
primero.com.au | DESIGN | CONSTRUCT | OPERATE

PRIMERO PROJECT NUMBER: 23517

INFORMATION AND REPRESENTATIONS ON THIS DRAWING ARE THE INTELLECTUAL PROPERTY OF PRIMERO UNLESS SPECIFICALLY IDENTIFIED OTHERWISE. ALL RIGHTS INCLUDING USE RESERVED

PROJECT: NORTHERN STAR RESOURCES LTD
KCGM GROWTH PROJECT

TITLE: GRAVITY CIRCUIT & INTENSIVE LEACHING - F13-SW-003
F14-HT-415 INT CYANIDE LEACH REACT SOLN TANK HTR 2
SCHEMATIC AND TERMINATION DIAGRAM

| SHEET | SCALE | DRG No. | REVISION |
|---|---|---|---|
| A1 | NONE | 2000-F14-SCM-EL-10208 | 1 |

O:\CAD PROJECTS\235 NORTHERN STAR RESOURCES LTD\23517 KCGM GROWTH PROJECT\03 DELIVERABLES\ELV\F14 - GRAVITY CIRCUIT & INTENSIVE LEACHING\2000-F14-SCM-EL-10208.DWG 25SEP25 12:53PM HOTSEAT04