
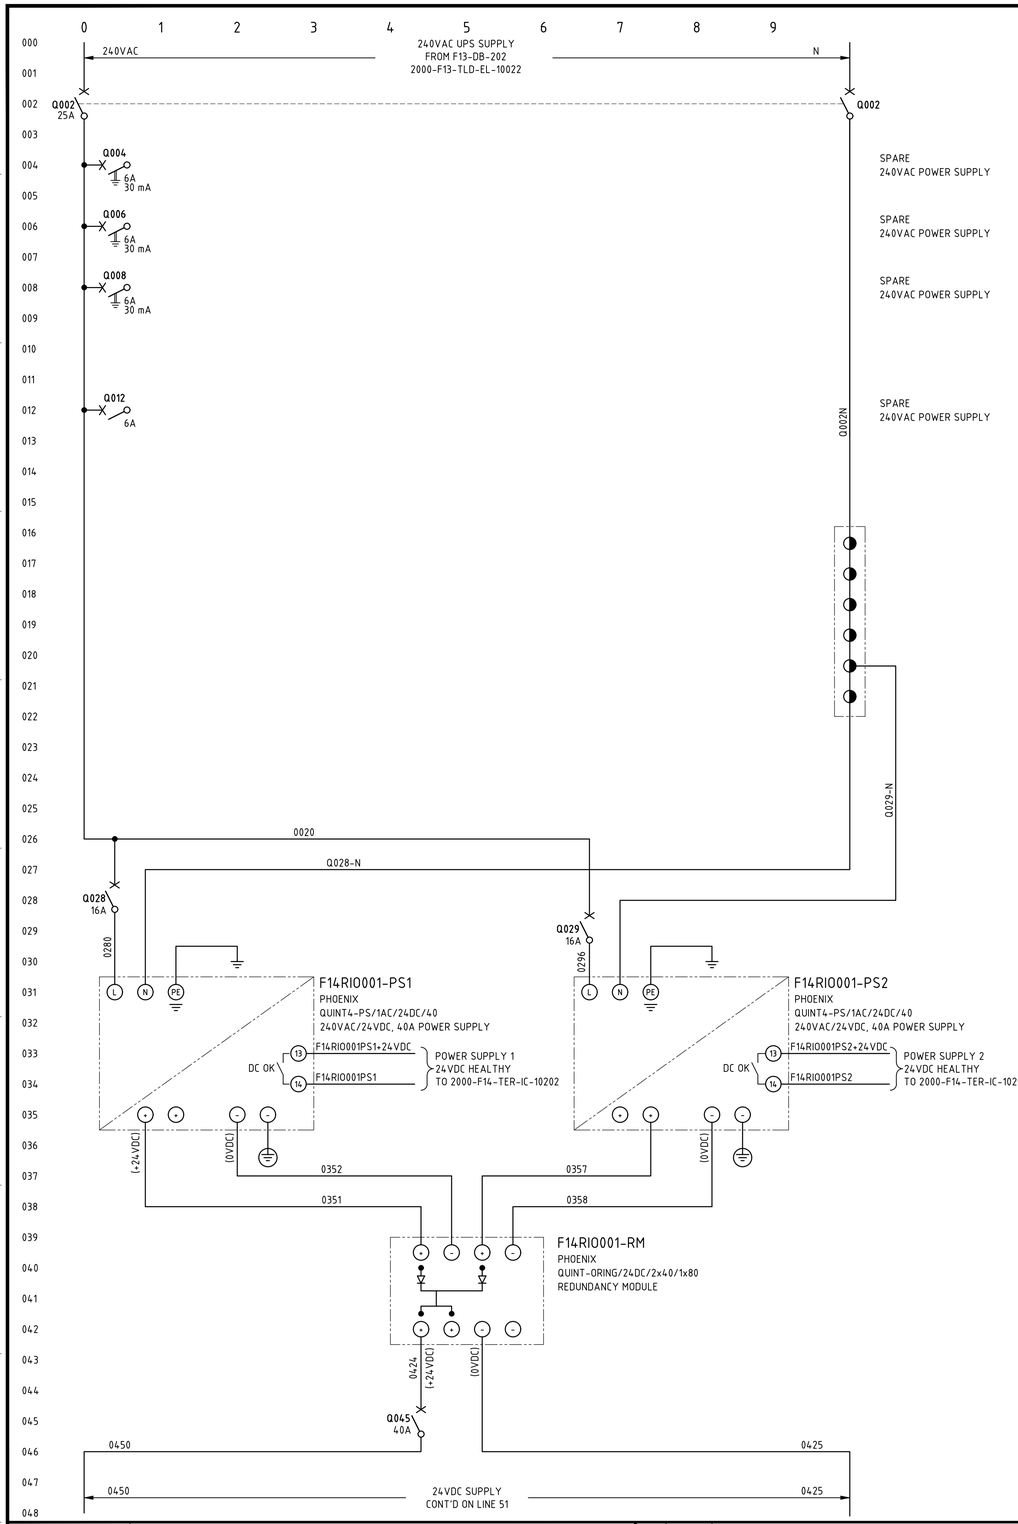


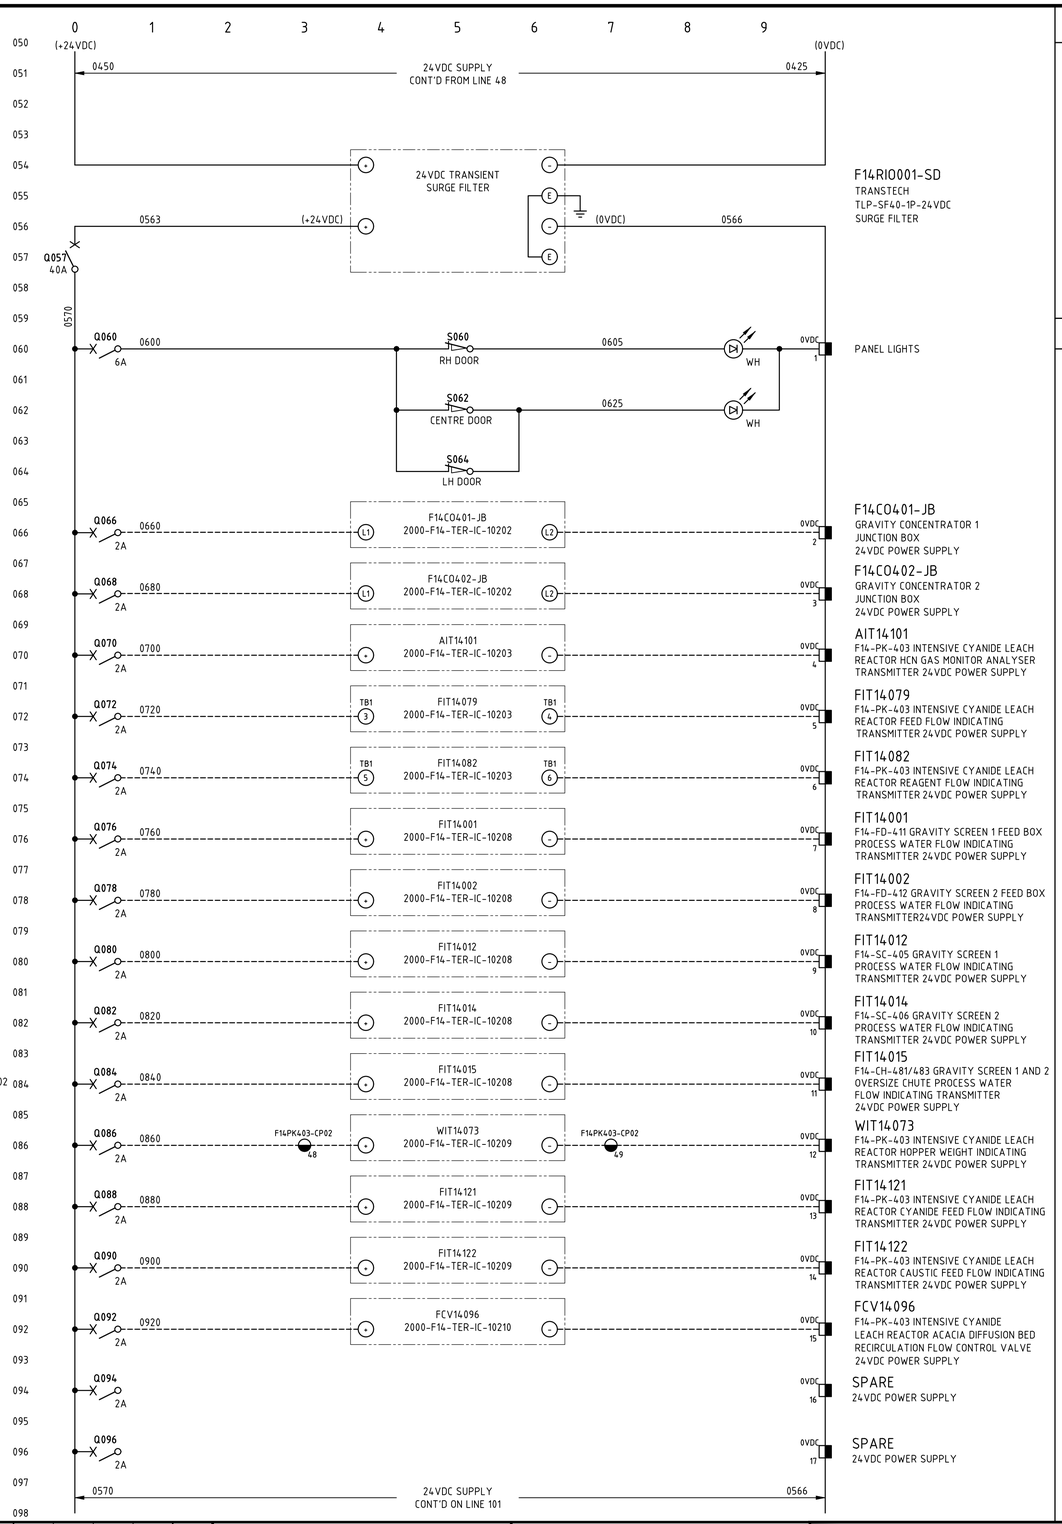

NOTES

1. TERMINALS ON TERMINAL STRIPS ABOVE 50VAC SHALL HAVE A SEPARATE PERSPEX SHROUD AND SHALL BE LABELLED "DANGER xxxVAC".
2. WIRE NUMBER FERRULES ON TERMINAL STRIP SHALL BE PREFIXED WITH EQUIPMENT NUMBER e.g. F14RIO001-xxxx.
3. EACH WIRE SHALL BE IDENTIFIED AT BOTH ENDS WITH FERRULES.
4. FOR NETWORK CONNECTION & BUS CABLING DETAILS REFER TO RIO PANEL COMMUNICATIONS TERMINATION DIAGRAMS.
5. INSTRUMENT EARTH BAR TO BE BONDED TO MAIN EARTH BAR WITH SOLID COPPER LINK.

LEGEND

- FIELD TERMINAL
- DCS OR I/O TERMINAL
- 0VDC TERMINAL FOR 24VDC
- 0VDC TERMINAL FOR 54VDC
- DEVICE TERMINAL
- INDICATION LAMP (cc = COLOUR)
- EARTH BAR
- INSTRUMENT EARTH BAR

DRG No.	REFERENCES
2000-F13-TLD-EL-10022	F13-DB-202 LV SWITCHROOM 240V UPS DB THREE LINE DIAGRAM
2000-F14-DRG-IC-10201	F14-RIO-001 FIELD N-IO PANEL GENERAL ARRANGEMENT
2000-F14-SCM-IC-10202	F14-RIO-001 FIELD N-IO PANEL SCHEMATIC DIAGRAM SHEET 2
2000-F14-TER-IC-10200	F14-RIO-001 FIELD N-IO PANEL COMMUNICATIONS TERMINATION DIAGRAM SHEET 1 (TO SHEET 2 -10201)
2000-F14-TER-IC-10202	F14-RIO-001 FIELD N-IO PANEL TERMINATION DIAGRAM SHEET 1 (TO SHEET 9 -10210)
2000-F00-STD-EL-10001	GENERAL NOTES AND STANDARD DRAWINGS INDEX

REV	DATE	DESCRIPTION	DRAW	CHECK	DESIGN	TECH APP	PROJ APP
2	02OCT26	KCGM GROWTH PROJECT - SP1 AS-BUILT					
1	02APR25	FAT REDLINES INCORPORATED					
0	18NOV24	APPROVED FOR CONSTRUCTION					

NORTHERN STAR RESOURCES LIMITED

PRIMERO
primero.com.au | DESIGN | CONSTRUCT | OPERATE

PRIMERO PROJECT NUMBER: 23517

INFORMATION AND REPRESENTATIONS ON THIS DRAWING ARE THE INTELLECTUAL PROPERTY OF PRIMERO UNLESS SPECIFICALLY IDENTIFIED OTHERWISE. ALL RIGHTS INCLUDING USE RESERVED

PROJECT: NORTHERN STAR RESOURCES LTD
KCGM GROWTH PROJECT

TITLE: GRAVITY CIRCUIT & INTENSIVE LEACHING
F14-RIO-001 GRAVITY & ILR FIELD N-IO PANEL
SCHEMATIC DIAGRAM SHEET 1

SHEET	SCALE	DRG No.	REVISION
A1	NONE	2000-F14-SCM-IC-10201	2

O:\CAD PROJECTS\235 NORTHERN STAR RESOURCES LTD\23517 KCGM GROWTH PROJECT\03 DELIVERABLES\IC\F14 - GRAVITY CIRCUIT & INTENSIVE LEACHING\2000-F14-SCM-IC-10201.DWG 25SEP26 10:58AM ROBIN.LAW