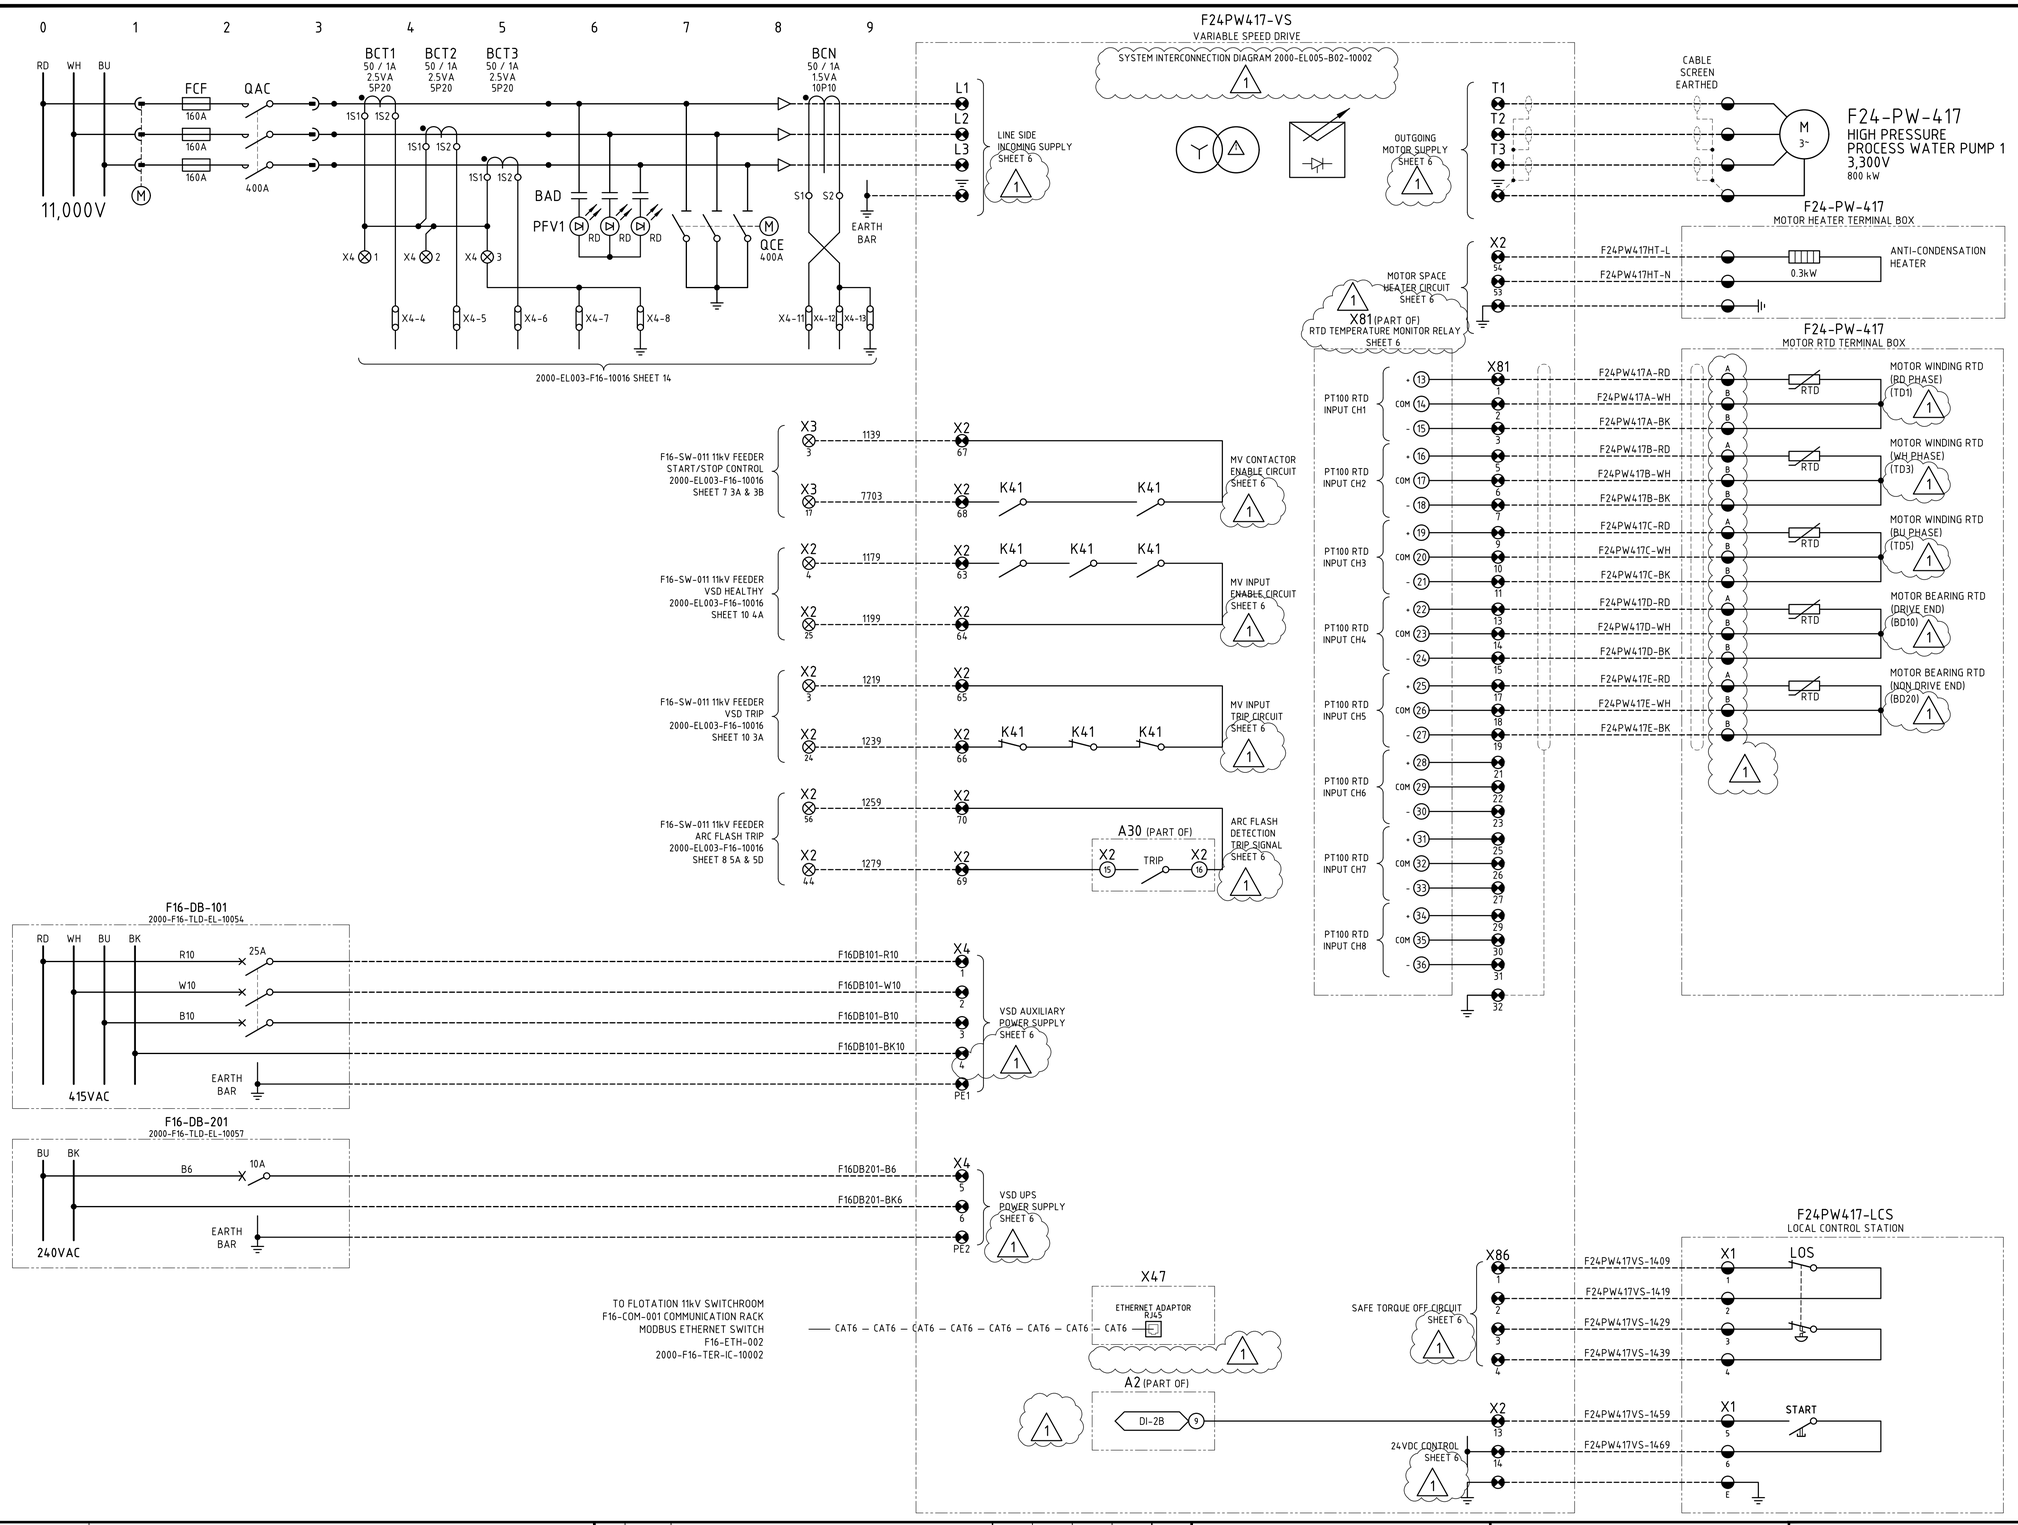


NOTES

1. WIRE NUMBER FERRULES ON TERMINAL STRIP SHALL BE PREFIXED WITH EQUIPMENT NUMBER e.g. F24PW417-1200, UNLESS OTHERWISE NOTED.
2. EACH WIRE SHALL BE IDENTIFIED AT BOTH ENDS WITH FERRULES.

LEGEND

- 11kV SWITCHBOARD TERMINAL
- VSD TERMINAL
- FIELD TERMINAL
- DCS OR I/O TERMINAL
- MARSHALLING TERMINAL
- DEVICE TERMINAL

PANEL A16

DRG No.	REFERENCES
2000-F16-SCM-EL-10177	11kV SWITCHBOARD REMOTE SWITCHING PANEL SCHEMATIC DIAGRAM SHEET 7
2000-EL005-D02-10002	F24PW417-VS SIEMENS VSD SCHEMATIC DIAGRAMS
2000-EL003-F16-10011	F16-SW-011 A16 ABB SCHEMATIC DIAGRAM
2000-F16-TER-EL-10131	F16-SW-011 11kV SWITCHBOARD – PANEL A18 (F24PW417-VS) TERMINATION DIAGRAM SHEET 1
2000-F16-SLD-EL-10003	F16-SW-011 11kV SWITCHBOARD SINGLE LINE DIAGRAM SHEET 3
2000-F00-STD-EL-10001	GENERAL NOTES AND STANDARD DRAWINGS INDEX

REV	DATE	DESCRIPTION	DRAW	CHECK	DESIGN	TECH APP	PROJ APP
1	29AUG25	FAT REDLINES INCORPORATED					
0	15JAN25	APPROVED FOR CONSTRUCTION					

NORTHERN STAR RESOURCES LIMITED

INFORMATION AND REPRESENTATIONS ON THIS DRAWING ARE THE INTELLECTUAL PROPERTY OF PRIMERO UNLESS SPECIFICALLY IDENTIFIED OTHERWISE. ALL RIGHTS INCLUDING USE RESERVED

PRIMERO
primero.com.au | DESIGN | CONSTRUCT | OPERATE

PRIMERO PROJECT NUMBER: 23517

PROJECT: NORTHERN STAR RESOURCES LTD
KCGM GROWTH PROJECT

TITLE: ROUGHER & SCAVENGER FLOTATION – F16-SW-011
F24-PW-417 HP PROCESS WATER PUMP 1 VSD FEEDER
SCHEMATIC DIAGRAM

SHEET	SCALE	DRG No.	REVISION
A1	NONE	2000-F16-SCM-EL-10131	1

D:\CAD PROJECTS\235 NORTHERN STAR RESOURCES LTD\23517 KCGM GROWTH PROJECT\03 DELIVERABLES\E\LVF16 - ROUGHER & SCAVENGER FLOTATION\2000-F16-SCM-EL-10131DWG 09SEP25 6:43AM HOTSEAT04