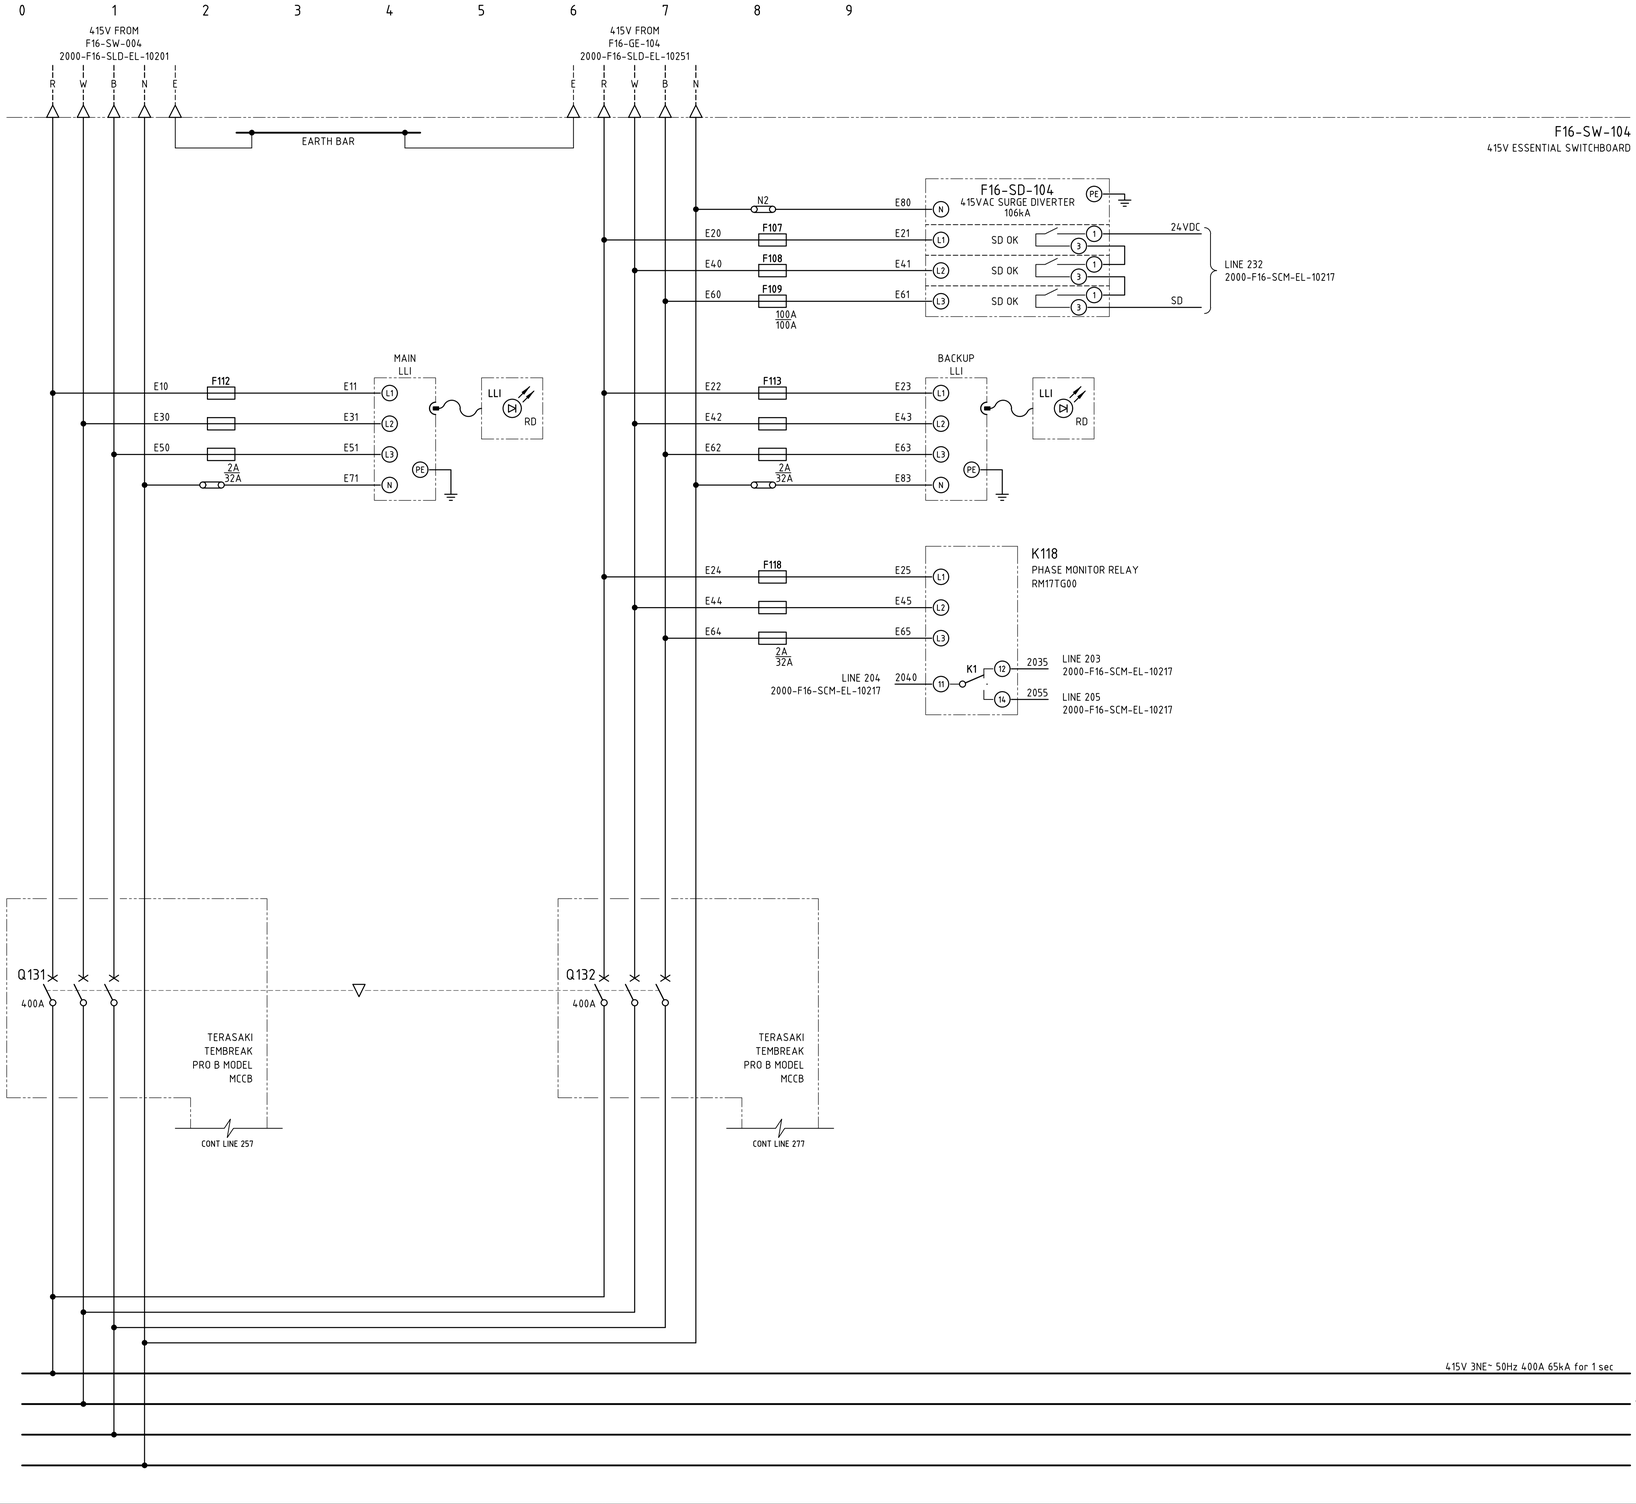


NOTES

1. SURGE DIVERTERS SHALL PROVIDE FEEDBACK TO DCS VIA VOLT-FREE CONTACTS. SURGE DIVERTER FUSES SHALL BE SIZED BY VENDOR TO SUIT DUTY.
2. MINIATURE CIRCUIT BREAKERS SHALL BE SIZED AND RATED TO SUIT ACB AND INCOMER REQUIREMENTS.
3. ALL TERMINATIONS ABOVE 50VAC SHALL BE TO IP2x OR ABOVE, IF NOT, TO HAVE A SEPARATE PERSPEX SHROUD FITTED AND SHALL BE LABELLED "DANGER xxxVAC".
4. WIRE NUMBER FERRULES ON TERMINAL STRIP SHALL BE PREFIXED WITH EQUIPMENT NUMBER e.g. F16SW103-0600, UNLESS OTHERWISE NOTED.
5. EACH WIRE SHALL BE IDENTIFIED AT BOTH ENDS WITH FERRULES.

LEGEND

00/01/00	DCS DIGITAL INPUT
00/02/00	DCS DIGITAL OUTPUT
⊗	MCC TERMINAL
⊗	VSD TERMINAL
◒	FIELD TERMINAL
◑	DCS OR I/O TERMINAL
◨	MARSHALLING TERMINAL
(x)	DEVICE TERMINAL
⊗ cc	INDICATION LAMP cc = COLOUR

DRG No.	REFERENCES
2000-F16-SCM-EL-10217	F16-SW-104 415V ESSENTIAL SWITCHBOARD SCHEMATIC DIAGRAM SHEET 2
2000-F16-SLD-EL-10251	F16-SW-104 415V ESSENTIAL SWITCHBOARD SINGLE LINE DIAGRAM
2000-F16-SLD-EL-10201	F16-SW-004 415V MCC SINGLE LINE DIAGRAM SHEET 1
2000-F00-STD-EL-10001	GENERAL NOTES AND STANDARD DRAWINGS INDEX

REV	DATE	DESCRIPTION	DRAW	CHECK	DESIGN	TECH APP	PROJ APP
3	07SEP26	KCGM GROWTH PROJECT - SP1 AS-BUILT					
2	26AUG25	FAT REDLINES INCORPORATED					
1	10JUN25	GENERATOR INCOMER ELR SHUNT TRIP ADDED, FAT REDLINES INCORP.					
0	30AUG24	APPROVED FOR CONSTRUCTION					

NORTHERN STAR RESOURCES LIMITED

PRIMERO
primero.com.au | DESIGN | CONSTRUCT | OPERATE

PRIMERO PROJECT NUMBER: 23517

INFORMATION AND REPRESENTATIONS ON THIS DRAWING ARE THE INTELLECTUAL PROPERTY OF PRIMERO UNLESS SPECIFICALLY IDENTIFIED OTHERWISE. ALL RIGHTS INCLUDING USE RESERVED

PROJECT: NORTHERN STAR RESOURCES LTD
KCGM GROWTH PROJECT

TITLE: ROUGHER & SCAVENGER FLOTATION - F16-SW-104
F16-SW-104 415V ESSENTIAL SWITCHBOARD INCOMER SCHEMATIC DIAGRAM SHEET 1

SHEET	SCALE	DRG No.	REVISION
A1	NONE	2000-F16-SCM-EL-10216	3

O:\CAD PROJECTS\235 NORTHERN STAR RESOURCES LTD\23517 KCGM GROWTH PROJECT\03 DELIVERABLES\ELVF16 - ROUGHER & SCAVENGER FLOTATION\2000-F16-SCM-EL-10216.DWG 04SEP26 3:30PM GRENVILLE.DEASY