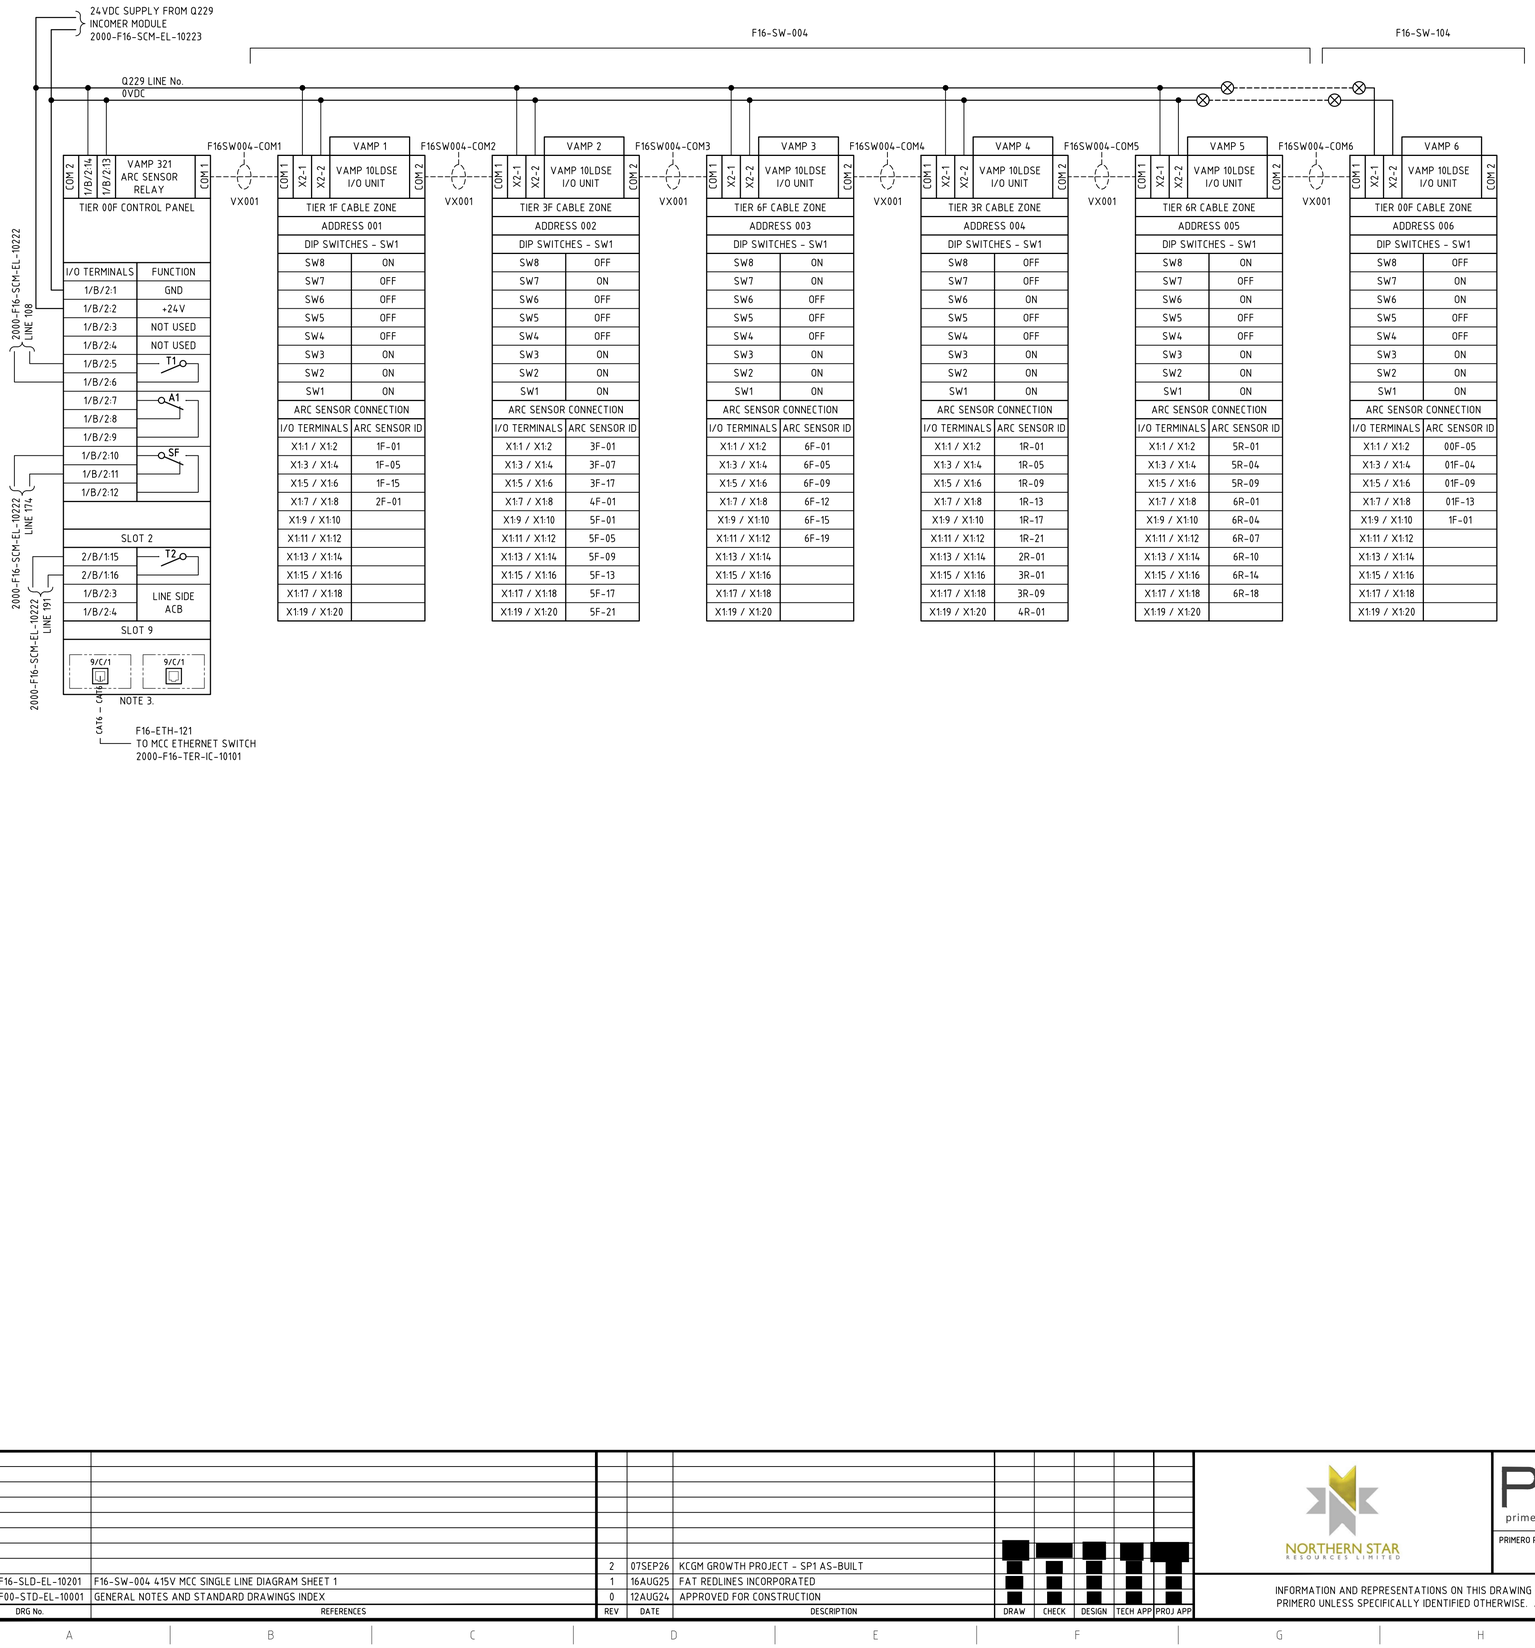


NOTES

1. CABLE NUMBER FOR ARC FLASH SENSOR VA1DA SHALL BE THE EQUIPMENT NUMBER FOLLOWED BY COM FOR COMMUNICATION AND A SEQUENTIAL NUMBER e.g. F16SW004-COMx.
2. EACH CABLE SHALL BE IDENTIFIED AT BOTH ENDS WITH CABLE NUMBER.
3. VAMP 321 ARC FAULT PROTECTION RELAY SHALL BE MOUNTED TO THE DOOR OF THE PANEL INCOMER CONTROL CUBICLE.
4. VAM 10LDSE INTERFACE SHALL BE MOUNTED ON THE CABLE ZONE DOOR.
5. MAXIMUM 16 VAM10LDSE I/O UNITS IN SERIES.
6. MAXIMUM LENGTH OF VX001 CABLE BETWEEN 2 UNITS (I/O UNITS OR VAMP321 UNIT) IS 30m & TOTAL LENGTH OF THE BUS CABLE FROM THE START TO THE END OF 100m SHALL NOT BE EXCEEDED.

LEGEND

F16SW004-COMx

CABLE MARKER LABEL

24VDC SUPPLY CABLE

COMMUNICATION CABLE

DIP SWITCHES KEY VAMP 10LDSE		
	ON	OFF
SW8	1	0
SW7	2	0
SW6	4	0
SW5	8	0
SW4	16	0
SW3	L>	L> + I>
SW2	LATCH	NON LATCHING
SW1	L> INT	L> EXT

L = LIGHT / I = CURRENT

DRG No.	REFERENCES
2000-F16-SLD-EL-10201	F16-SW-004 415V MCC SINGLE LINE DIAGRAM SHEET 1
2000-F00-STD-EL-10001	GENERAL NOTES AND STANDARD DRAWINGS INDEX

REV	DATE	DESCRIPTION	DRAW	CHECK	DESIGN	TECH APP	PROJ APP
2	07SEP26	KCGM GROWTH PROJECT - SP1 AS-BUILT					
1	16AUG25	FAT REDLINES INCORPORATED					
0	12AUG24	APPROVED FOR CONSTRUCTION					

NORTHERN STAR RESOURCES LIMITED

PRIMERO
primero.com.au | DESIGN | CONSTRUCT | OPERATE

PRIMERO PROJECT NUMBER: 23517

INFORMATION AND REPRESENTATIONS ON THIS DRAWING ARE THE INTELLECTUAL PROPERTY OF PRIMERO UNLESS SPECIFICALLY IDENTIFIED OTHERWISE. ALL RIGHTS INCLUDING USE RESERVED

PROJECT: NORTHERN STAR RESOURCES LTD
KCGM GROWTH PROJECT

TITLE: ROUGHER & SCAVENGER FLOTATION - F16-SW-004
F16-SW-004 ARC FLASH SYSTEM
SCHEMATIC DIAGRAM

SHEET	SCALE	DRG No.	REVISION
A1	NONE	2000-F16-SCM-EL-10224	2

O:\CAD PROJECTS\235 NORTHERN STAR RESOURCES LTD\23517 KCGM GROWTH PROJECT\03 DELIVERABLES\ELV\F16 - ROUGHER & SCAVENGER FLOTATION\2000-F16-SCM-EL-10224.DWG 04SEP26 3:49PM GRENVILLE.DEASY