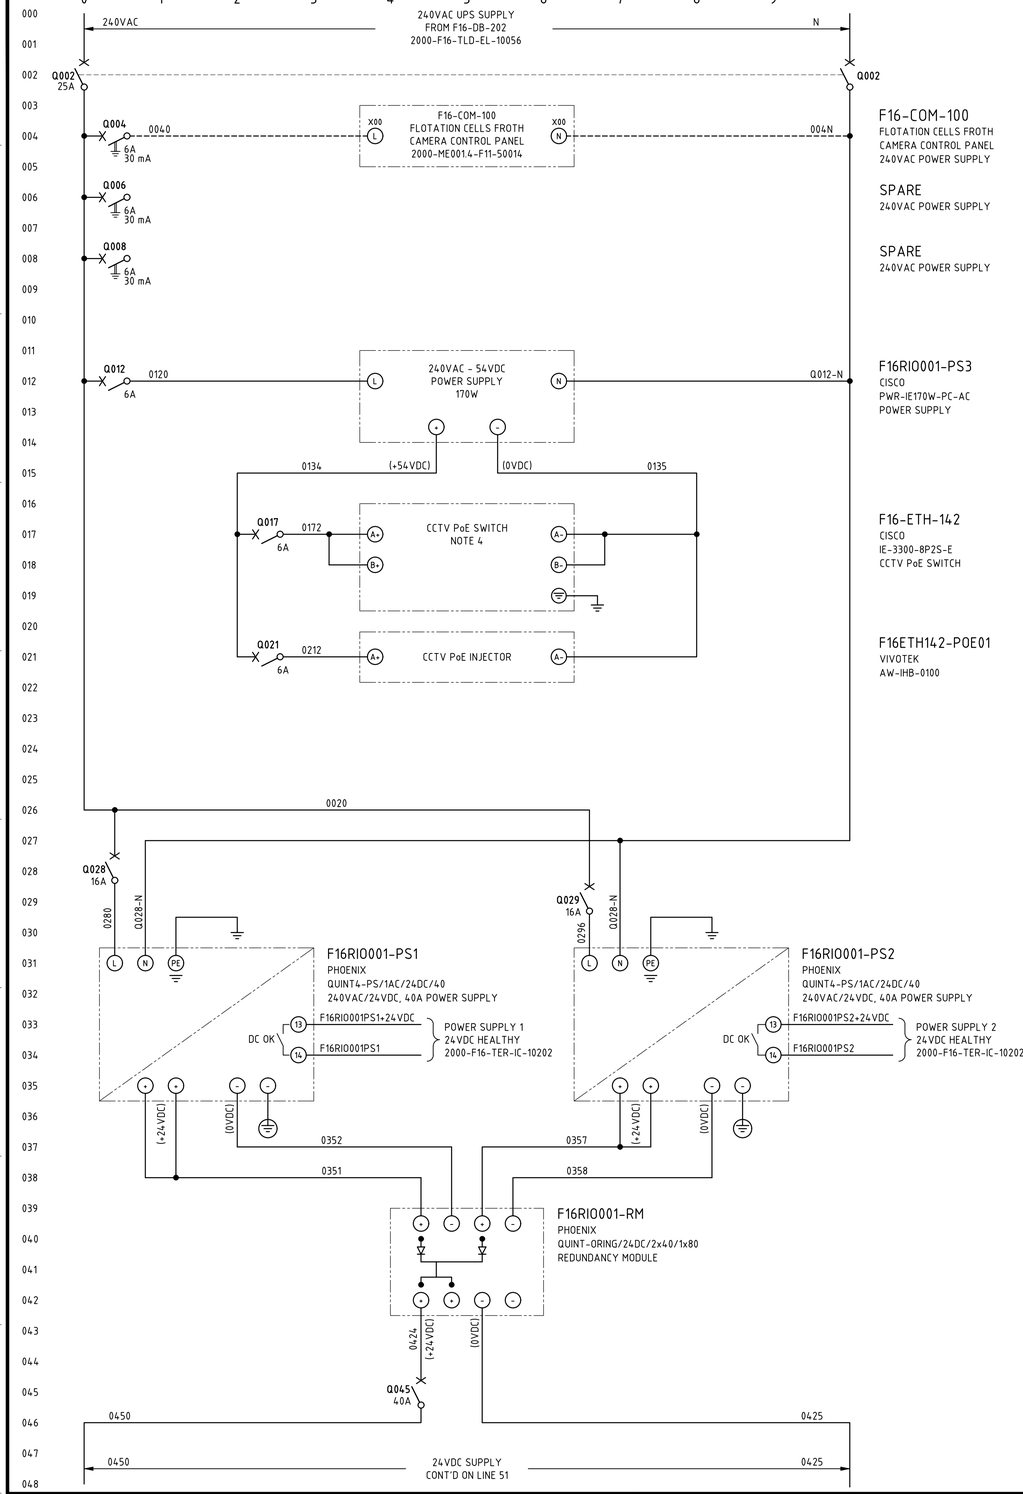
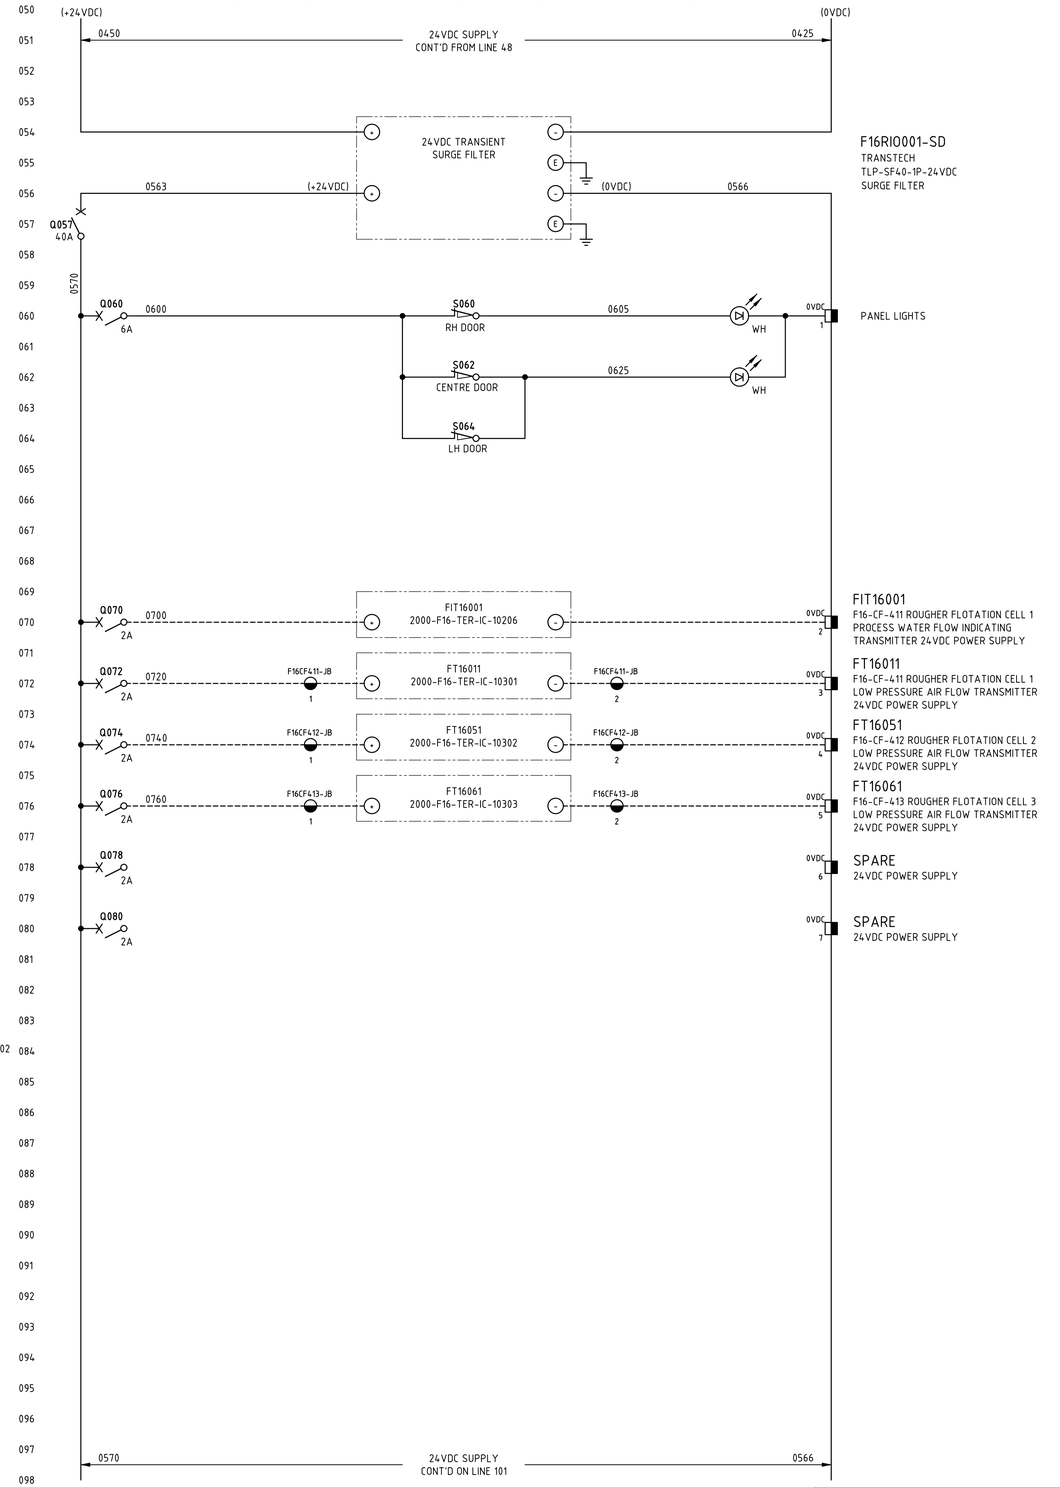



## NOTES

1. TERMINALS ON TERMINAL STRIPS ABOVE 50VAC SHALL HAVE A SEPARATE PERSPEX SHROUD AND SHALL BE LABELLED "DANGER xxxVAC".
2. WIRE NUMBER FERRULES ON TERMINAL STRIP SHALL BE PREFIXED WITH EQUIPMENT NUMBER e.g. F16RIO001-xxxx.
3. EACH WIRE SHALL BE IDENTIFIED AT BOTH ENDS WITH FERRULES.
4. FOR NETWORK CONNECTION & BUS CABLING DETAILS REFER TO RIO PANEL COMMUNICATIONS TERMINATION DIAGRAMS.
5. INSTRUMENT EARTH BAR TO BE BONDED TO MAIN EARTH BAR WITH SOLID COPPER LINK.

## LEGEND

- FIELD TERMINAL
- DCS OR I/O TERMINAL
- MARSHALLING TERMINAL
- DEVICE TERMINAL
- INDICATION LAMP (cc = COLOUR)
- EARTH BAR
- INSTRUMENT EARTH BAR

| DRG No. | REFERENCES |
|---|---|
| 2000-F16-TLD-IC-10056 | F16-DB-202 SWITCHROOM 240V UPS DB THREE LINE DIAGRAM |
| 2000-F16-DRG-IC-10201 | F16-RIO-001 FIELD N-IO PANEL GENERAL ARRANGEMENT |
| 2000-F16-SCM-IC-10202 | F16-RIO-001 FIELD N-IO PANEL SCHEMATIC DIAGRAM SHEET 2 |
| 2000-F16-TER-IC-10200 | F16-RIO-001 FIELD N-IO PANEL COMMUNICATIONS TERMINATION DIAGRAM SHEET 1 (TO SHEET 2 - 10201) |
| 2000-F16-TER-IC-10202 | F16-RIO-001 FIELD N-IO PANEL TERMINATION DIAGRAM SHEET 1 (TO SHEET 9 - 10210) |
| 2000-F00-STD-EL-10001 | GENERAL NOTES AND STANDARD DRAWINGS INDEX |

| REV | DATE | DESCRIPTION |
|---|---|---|
| 1 | 10SEP26 | KCGM GROWTH PROJECT - SP1 AS-BUILT |
| 0 | 19FEB25 | APPROVED FOR CONSTRUCTION |

DRAW | CHECK | DESIGN | TECH APP | PROJ APP

NORTHERN STAR RESOURCES LIMITED

PRIMERO
primero.com.au | DESIGN | CONSTRUCT | OPERATE

PRIMERO PROJECT NUMBER: 23517

INFORMATION AND REPRESENTATIONS ON THIS DRAWING ARE THE INTELLECTUAL PROPERTY OF PRIMERO UNLESS SPECIFICALLY IDENTIFIED OTHERWISE. ALL RIGHTS INCLUDING USE RESERVED

PROJECT: NORTHERN STAR RESOURCES LTD
KCGM GROWTH PROJECT

TITLE: ROUGHER & SCAVENGER FLOTATION
F16-RIO-001 ROUGHER & SCAVENGER FLOT FIELD N-IO PANEL
SCHEMATIC DIAGRAM SHEET 1

| SHEET | SCALE | DRG No. | REVISION |
|---|---|---|---|
| A1 | NONE | 2000-F16-SCM-IC-10201 | 1 |

O:\CAD PROJECTS\235 NORTHERN STAR RESOURCES LTD\23517 KCGM GROWTH PROJECT\03 DELIVERABLES\IC\F16 - ROUGHER & SCAVENGER FLOTATION\2000-F16-SCM-IC-10201.DWG 08SEP26 1:42PM GRENVILLE.DEASY