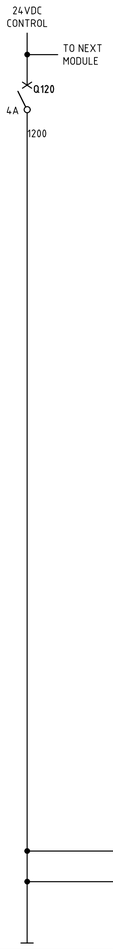
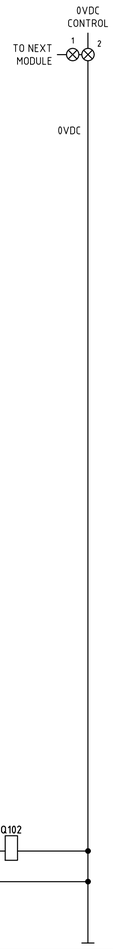
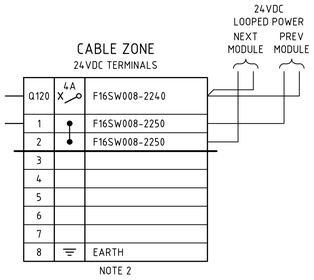
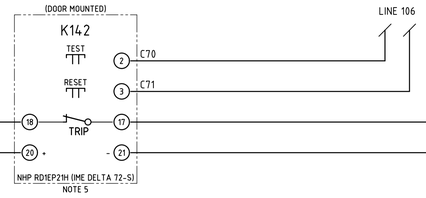



F17-HT-539
FLOTATION TAILINGS THICKENER
RAKE DRIVE
OIL TANK HEATER
1.5 kW



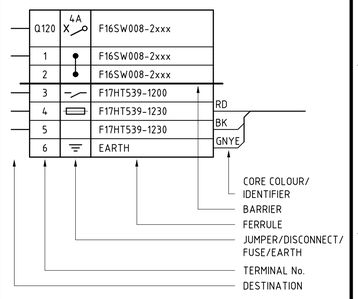

## NOTES

1. TERMINALS ON TERMINAL STRIPS ABOVE 50VAC SHALL HAVE A SEPARATE PERSPEX SHROUD AND SHALL BE LABELLED "DANGER xxxVAC".
2. WIRE NUMBER FERRULES ON TERMINAL STRIP SHALL BE PREFIXED WITH EQUIPMENT NUMBER e.g. F17HT539-1200, UNLESS OTHERWISE NOTED.
3. EACH WIRE SHALL BE IDENTIFIED AT BOTH ENDS WITH FERRULES.
4. NHP TDGB2
   IN:90A IΔN MIN:0.03A TOROID TO SUIT CABLE DIAMETER.
5. EARTH LEAKAGE RELAY (ELV) USER INTERFACE TO BE MOUNTED ON MCC MODULE DOOR. RELAY ENERGISED (NORMALLY CLOSED CONTACT OPEN) IN NORMAL OPERATION.

## LEGEND

| | |
|---|---|
| 00/01/00 | DCS DIGITAL INPUT |
| 00/02/00 | DCS DIGITAL OUTPUT |
| ⊗ | MCC TERMINAL |
| ◓ | VSD TERMINAL |
| ◒ | FIELD TERMINAL |
| ◑ | DCS OR I/O TERMINAL |
| ◧ | MARSHALLING TERMINAL |
| ⓧ | DEVICE TERMINAL |
| ⊗ cc | INDICATION LAMP cc = COLOUR |

## TERMINATION LEGEND




| DRG No. | REFERENCES |
|---|---|
| 2000-F16-SLD-EL-10221 | F16-SW-008 415V EMERGENCY MCC SINGLE LINE DIAGRAM SHEET 1 |
| 2000-F00-STD-EL-10001 | GENERAL NOTES AND STANDARD DRAWINGS INDEX |

| REV | DATE | DESCRIPTION | DRAW | CHECK | DESIGN | TECH APP | PROJ APP |
|---|---|---|---|---|---|---|---|
| 2 | 07SEP26 | KCGM GROWTH PROJECT - SP1 AS-BUILT | | | | | |
| 1 | 26AUG25 | FAT REDLINES INCORPORATED, F17TH401-CP MODS | | | | | |
| 0 | 06SPE24 | APPROVED FOR CONSTRUCTION | | | | | |

NORTHERN STAR RESOURCES LIMITED

PRIMERO
primero.com.au | DESIGN | CONSTRUCT | OPERATE

PRIMERO PROJECT NUMBER: 23517

INFORMATION AND REPRESENTATIONS ON THIS DRAWING ARE THE INTELLECTUAL PROPERTY OF PRIMERO UNLESS SPECIFICALLY IDENTIFIED OTHERWISE. ALL RIGHTS INCLUDING USE RESERVED

PROJECT: NORTHERN STAR RESOURCES LTD
KCGM GROWTH PROJECT

TITLE: FLOTATION TAILINGS THICKENING - F16-SW-008
F17-HT-539 FLOT TAILS THICK RAKE DRIVE OIL TANK HTR
SCHEMATIC AND TERMINATION DIAGRAM

| SHEET | SCALE | DRG No. | REVISION |
|---|---|---|---|
| A1 | NONE | 2000-F17-SCM-EL-10206 | 2 |

O:\CAD PROJECTS\235 NORTHERN STAR RESOURCES LTD\23517 KCGM GROWTH PROJECT\03 DELIVERABLES\EL\F17 - FLOTATION TAILINGS PRE-LEACH THICKENING\2000-F17-SCM-EL-10206.DWG 04-SEP26 9:54AM ROBINLAW