
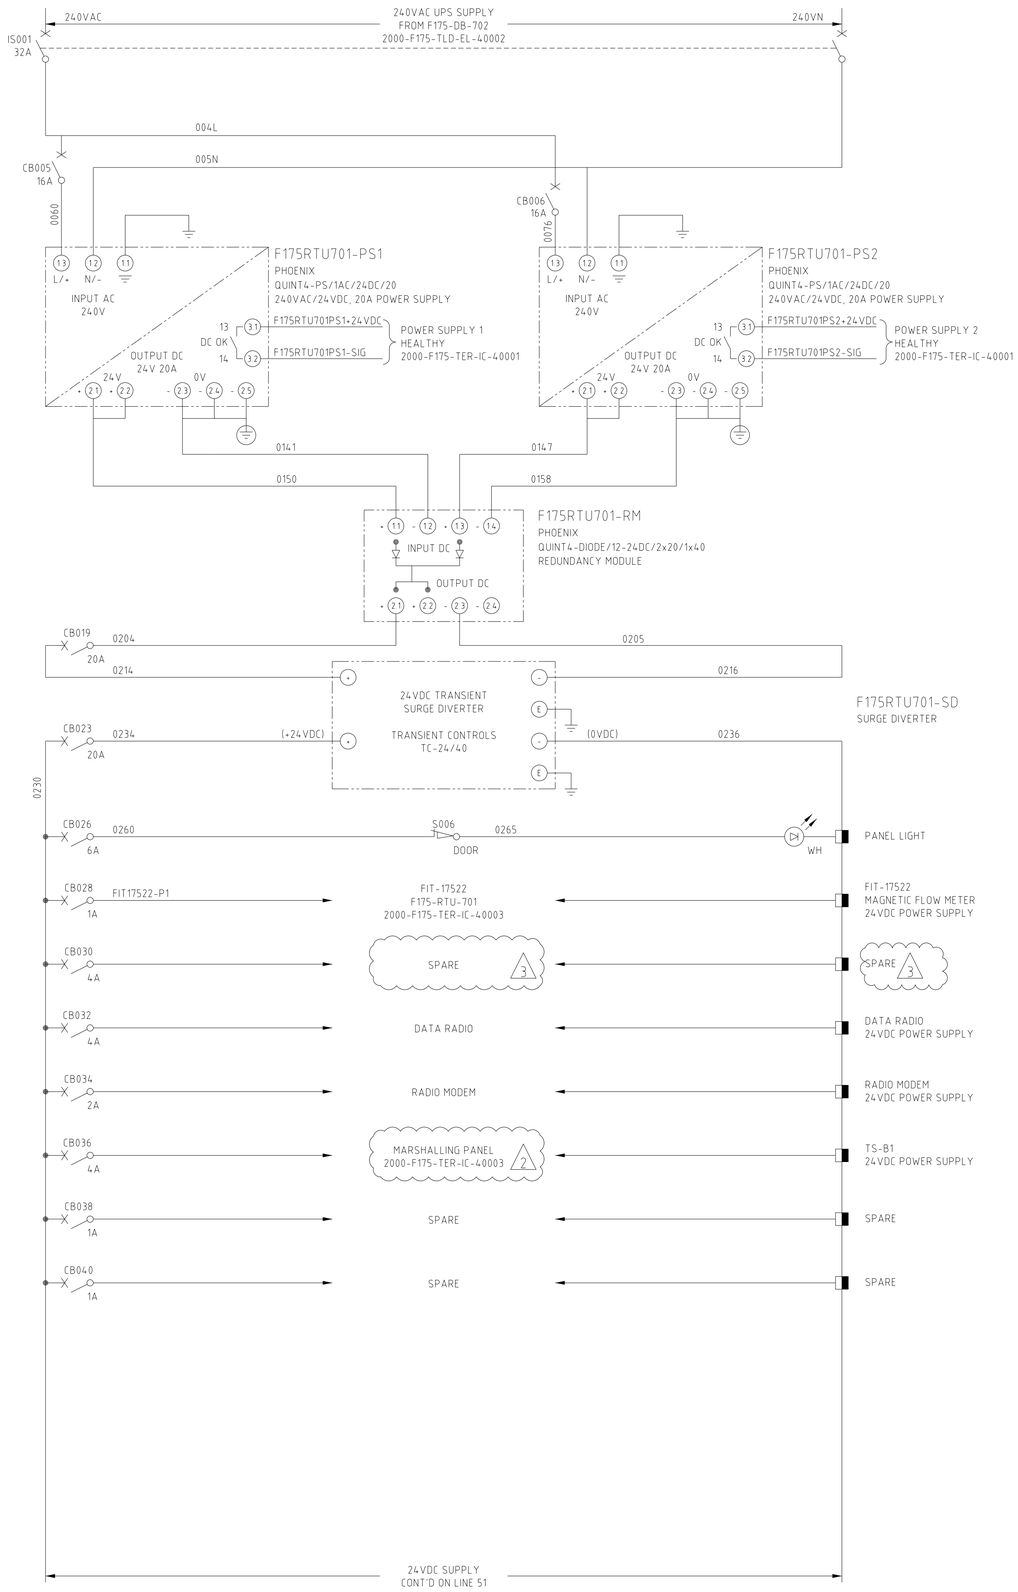


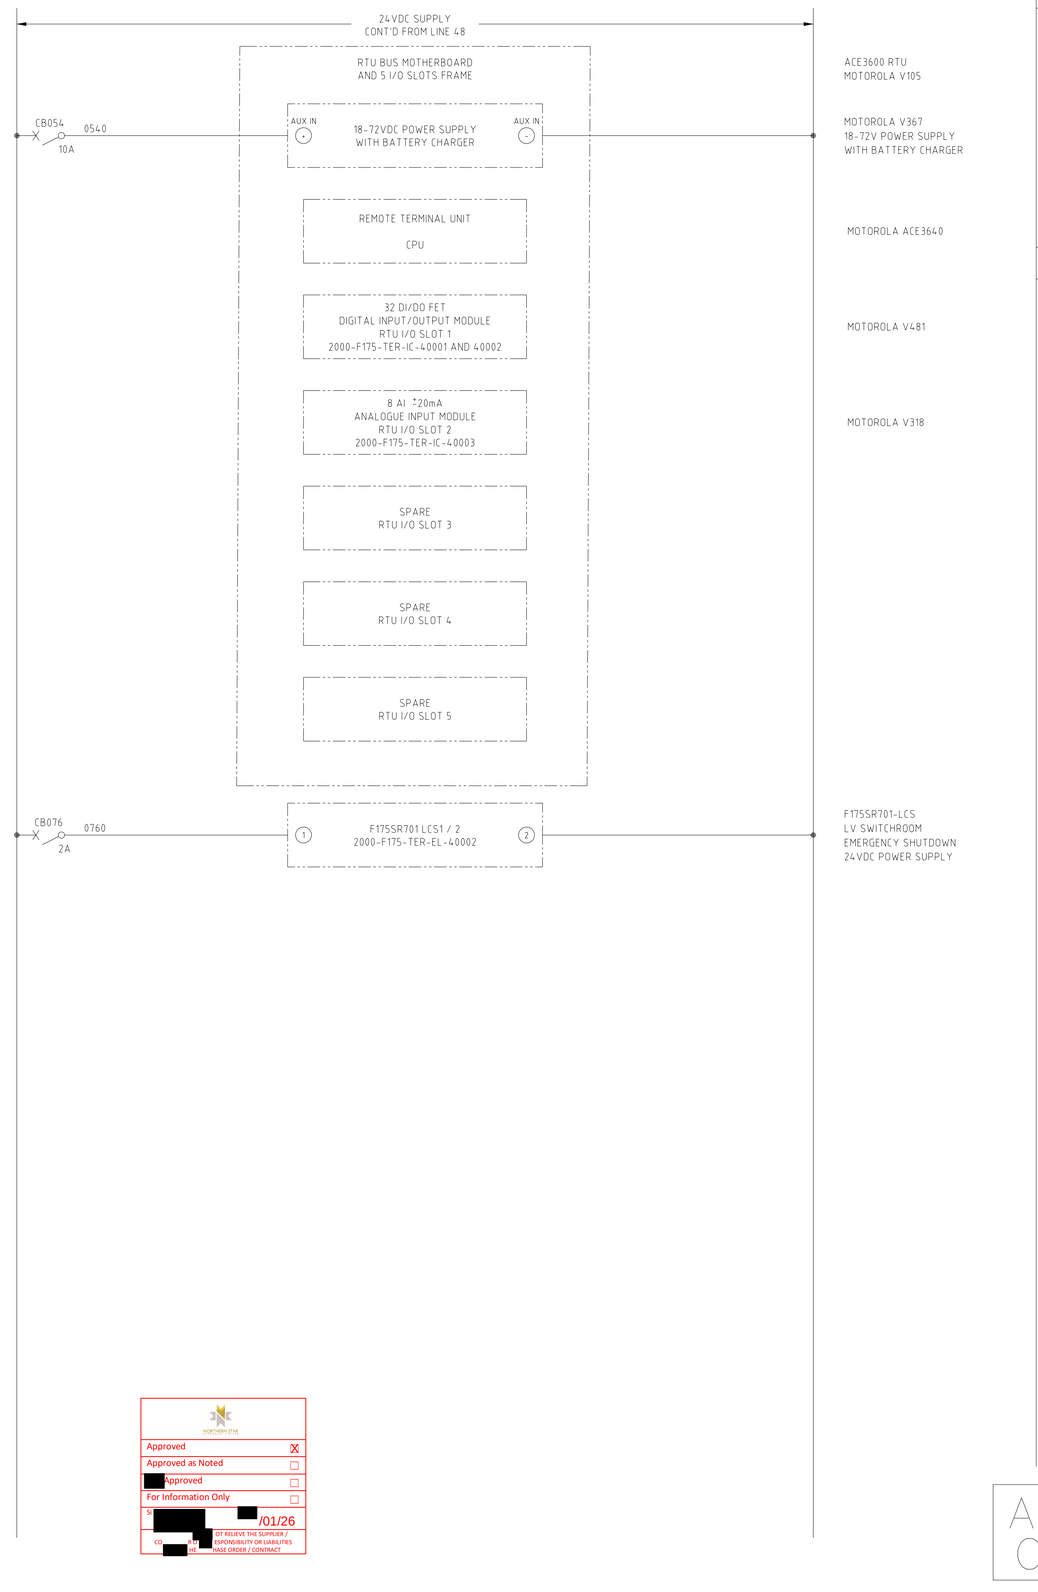

NOTES

1. TERMINALS ON TERMINAL STRIPS ABOVE 50VAC SHALL HAVE A SEPARATE PERSPEX SHROUD AND SHALL BE LABELLED "DANGER xxxVAC".
2. WIRE NUMBER FERRULES ON TERMINAL STRIP SHALL BE PREFIXED WITH EQUIPMENT NUMBER e.g. FxxPPxxx-1200.
3. EACH WIRE SHALL BE IDENTIFIED AT BOTH ENDS WITH FERRULES.
4. FOR NETWORK CONNECTION DETAILS REFER TO: F175-SR-701 SWITCHROOM COMMUNICATIONS BLOCK DIAGRAM 2000-F175-BLK-IC-40001

LEGEND

- FIELD TERMINAL
- DCS OR I/O TERMINAL
- MARSHALLING TERMINAL
- DEVICE TERMINAL
- INDICATION LAMP (cc = COLOUR)
- EARTH BAR
- IEB — INSTRUMENT EARTH BAR

Approved [X]
Approved as Noted [ ]
[redacted] Approved [ ]
For Information Only [ ]
[redacted] /01/26
[redacted] DOES NOT RELIEVE THE SUPPLIER / CONTRACTOR OF ANY RESPONSIBILITY OR LIABILITIES UNDER THE PURCHASE ORDER / CONTRACT

APPROVED FOR CONSTRUCTION

REFERENCES	DWG No	REV	DATE	REVISION
F175-RTU-701 – SOUTHLAKES BOOSTER STATION RTU CABINET GENERAL ARRANGEMENT	2000-F175-DRG-IC-40002	2	09.OCT.25	RE-APPROVED FOR CONSTRUCTION
F175-DB-702 – SOUTHLAKES BOOSTER STATION LV SWITCHROOM 240VAC UPS DB THREE LINE DIAGRAM	2000-F175-TLD-EL-40002	1	14.JUL.25	RE-APPROVED FOR CONSTRUCTION
GENERAL NOTES AND STANDARD DRAWINGS INDEX	2000-F00-STD-EL-10001	0	21.MAY.25	APPROVED FOR CONSTRUCTION

	DRN	CHK	TECH APP	APP
Initial	[redacted]	[redacted]	[redacted]	DS

NORTHERN STAR RESOURCES LIMITED

DRA PACIFIC (PTY) LIMITED

[redacted]	[redacted]	18.MAR.2025
CHECKED	[redacted]	14.APR.2025
DESIGNED	[redacted]	14.APR.2025
TECH APP	[redacted]	14.APR.2025
[redacted] APP	[redacted]	21.MAY.2025
CLIENT APP		

PROJECT: KCGM
FIM TSF PROJECT

TITLE: SOUTHLAKES BOOSTER STATION
F175-RTU-701 – RTU CABINET
SCHEMATIC DIAGRAM

A1 | SCALE NTS | DRG No. 2000-F175-SCM-IC-40002 | REV. 3