
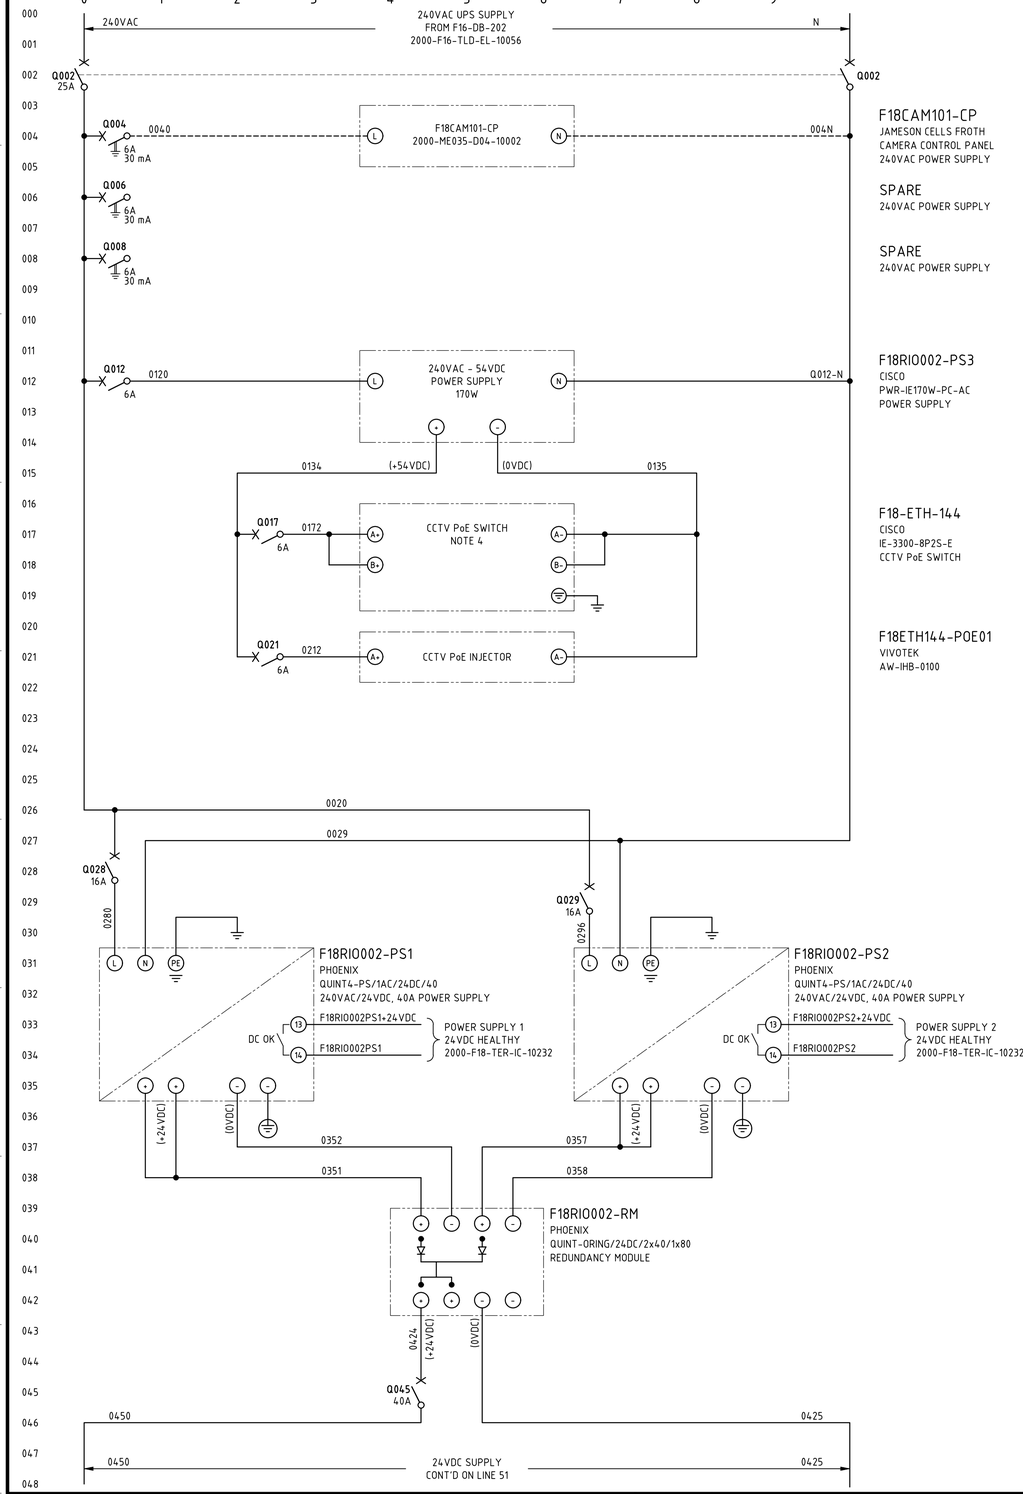


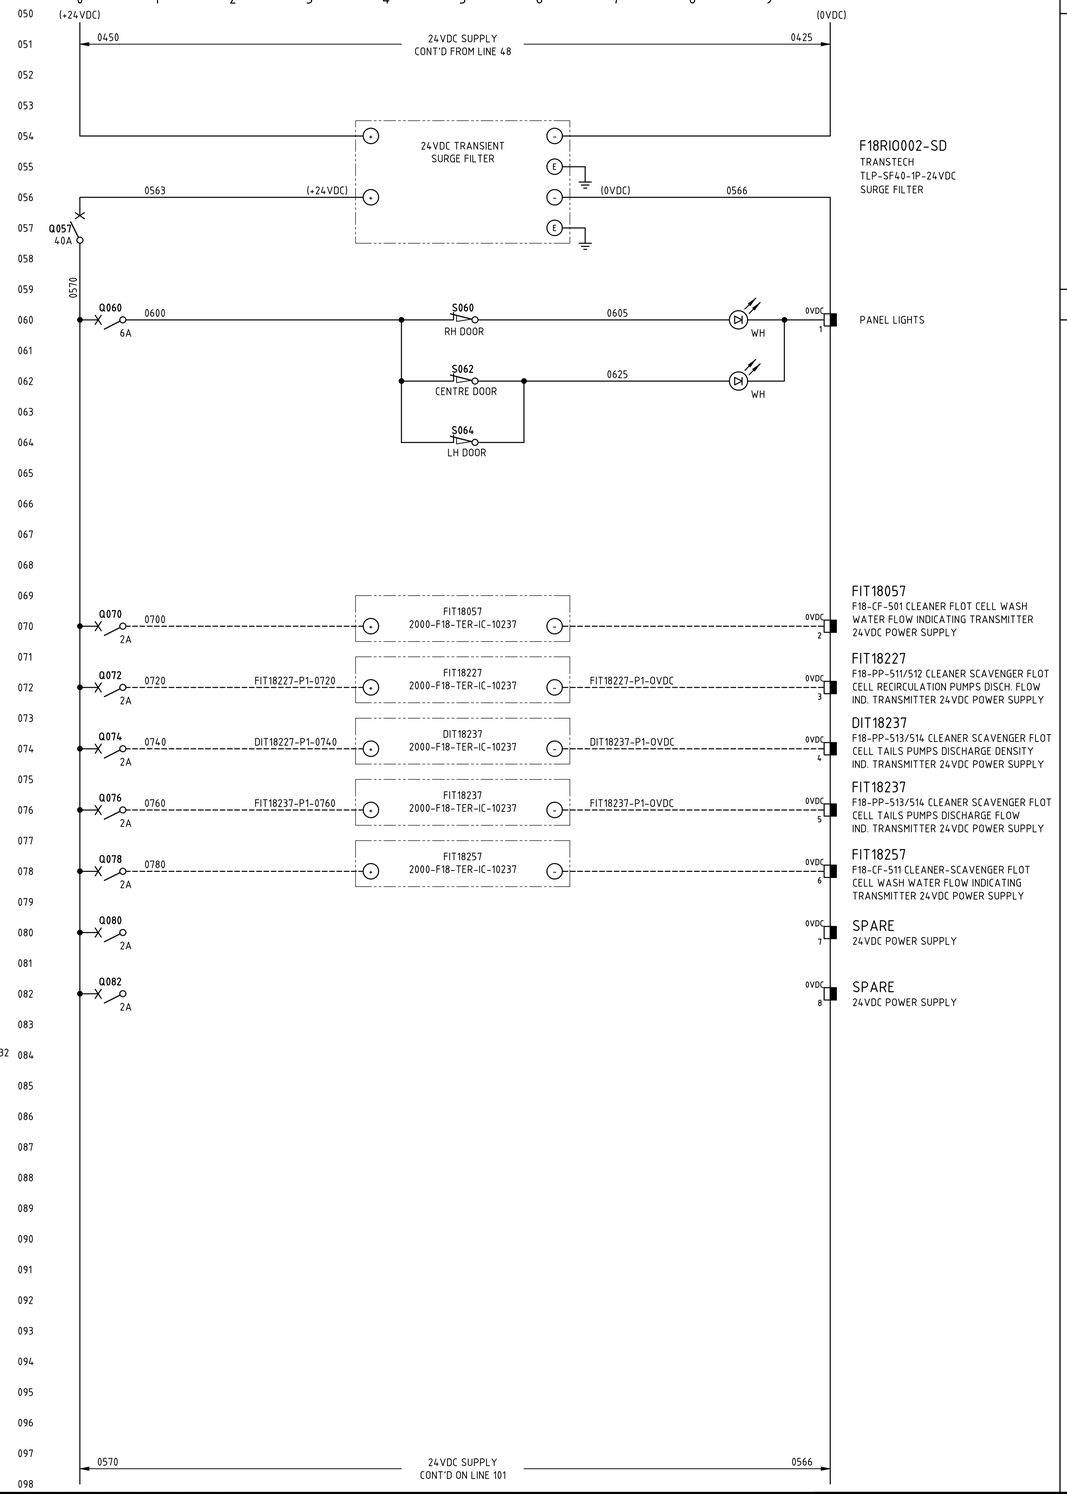

NOTES

1. TERMINALS ON TERMINAL STRIPS ABOVE 50VAC SHALL HAVE A SEPARATE PERSPEX SHROUD AND SHALL BE LABELLED "DANGER xxxVAC".
2. WIRE NUMBER FERRULES ON TERMINAL STRIP SHALL BE PREFIXED WITH EQUIPMENT NUMBER e.g. F18RIO002-xxxx.
3. EACH WIRE SHALL BE IDENTIFIED AT BOTH ENDS WITH FERRULES.
4. FOR NETWORK CONNECTION & BUS CABLING DETAILS REFER TO RIO PANEL COMMUNICATIONS TERMINATION DIAGRAMS.
5. INSTRUMENT EARTH BAR TO BE BONDED TO MAIN EARTH BAR WITH SOLID COPPER LINK.

LEGEND

- FIELD TERMINAL
- DCS OR I/O TERMINAL
- MARSHALLING TERMINAL
- DEVICE TERMINAL
- INDICATION LAMP (cc = COLOUR)
- EARTH BAR
- INSTRUMENT EARTH BAR

DRG No.	REFERENCES
2000-F16-TLD-IC-10056	F16-DB-202 SWITCHROOM 240V UPS DB THREE LINE DIAGRAM
2000-F18-DRG-IC-10231	F18-RIO-002 FIELD N-IO PANEL GENERAL ARRANGEMENT
2000-F18-SCM-IC-10232	F18-RIO-002 FIELD N-IO PANEL SCHEMATIC DIAGRAM SHEET 2
2000-F18-TER-IC-10230	F18-RIO-002 FIELD N-IO PANEL COMMUNICATIONS TERMINATION DIAGRAM SHEET 1 (TO SHEET 2 - 10231)
2000-F18-TER-IC-10232	F18-RIO-002 FIELD N-IO PANEL TERMINATION DIAGRAM SHEET 1 (TO SHEET 10 - 10241)
2000-F00-STD-EL-10001	GENERAL NOTES AND STANDARD DRAWINGS INDEX

REV	DATE	DESCRIPTION
1	19SEP26	KCGM GROWTH PROJECT - SP1 AS-BUILT
0	19FEB25	APPROVED FOR CONSTRUCTION

	DRAW	CHECK	DESIGN	TECH APP	PROJ APP
	[redacted]	[redacted]	[redacted]	[redacted]	[redacted]
	[redacted]	[redacted]	[redacted]	[redacted]	[redacted]
	[redacted]	[redacted]	[redacted]	[redacted]	[redacted]

NORTHERN STAR RESOURCES LIMITED

PRIMERO
primero.com.au | DESIGN | CONSTRUCT | OPERATE

PRIMERO PROJECT NUMBER: 23517

INFORMATION AND REPRESENTATIONS ON THIS DRAWING ARE THE INTELLECTUAL PROPERTY OF PRIMERO UNLESS SPECIFICALLY IDENTIFIED OTHERWISE. ALL RIGHTS INCLUDING USE RESERVED

PROJECT: NORTHERN STAR RESOURCES LTD
KCGM GROWTH PROJECT

TITLE: CLEANER & CLEANER SCAVENGER FLOTATION
F18-RIO-002 CLEANER FLOTATION FIELD N-IO PANEL
SCHEMATIC DIAGRAM SHEET 1

SHEET	SCALE	DRG No.	REVISION
A1	NONE	2000-F18-SCM-IC-10231	1

O:\CAD PROJECTS\235 NORTHERN STAR RESOURCES LTD\23517 KCGM GROWTH PROJECT\03 DELIVERABLES\IC\F18 - CLEANER SCAVENGER FLOTATION\2000-F18-SCM-IC-10231.DWG 08SEP26 1:42PM GRENVILLE.DEASY