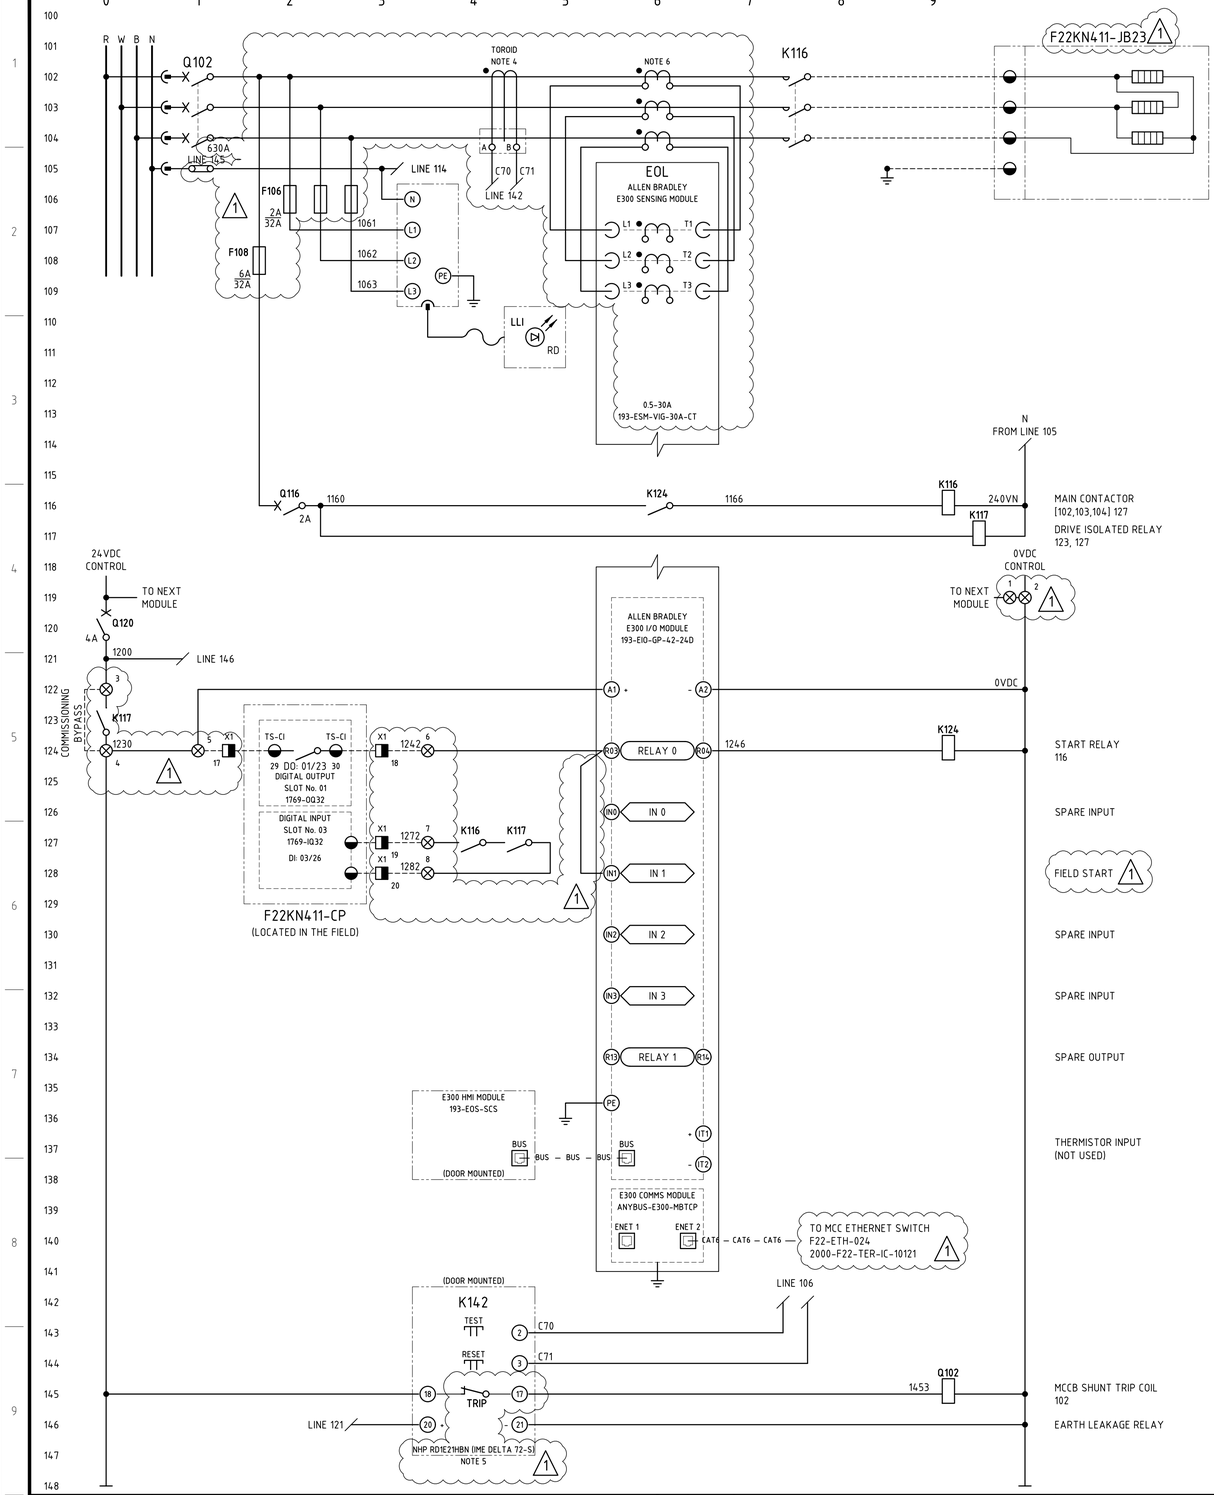


F22-KN-411K
CIL4 CARBON REGEN KILN
HEATERS
ZONE 2 BANK 3
168 kW


NOTES

1. TERMINALS ON TERMINAL STRIPS ABOVE 50VAC SHALL HAVE A SEPARATE PERSPEX SHROUD AND SHALL BE LABELLED "DANGER xxxVAC".
2. WIRE NUMBER FERRULES ON TERMINAL STRIP SHALL BE PREFIXED WITH EQUIPMENT NUMBER e.g. F22KN411K-1200, UNLESS OTHERWISE NOTED.
3. EACH WIRE SHALL BE IDENTIFIED AT BOTH ENDS WITH FERRULES.
4. NHP TDGE2
   IN:250A IΔN MIN:0.3A TOROID TO SUIT CABLE DIAMETER.
5. EARTH LEAKAGE RELAY (ELV) USER INTERFACE TO BE MOUNTED ON MCC MODULE DOOR. RELAY ENERGISED (NORMALLY CLOSED CONTACT OPEN) IN NORMAL OPERATION.
6. EXTERNAL CURRENT TRANSFORMER RATIO
   RED PHASE: 400/5A
   WHITE PHASE: 400/5A
   BLUE PHASE: 400/5A
7. F22KN411-CP FIELD CABLE MARSHALLING TERMINAL BLOCK IS DENOTED BY MARSHALLING TERMINALS LABELLED X1.

LEGEND

- 00/01/00 — DCS DIGITAL INPUT
- 00/02/00 — DCS DIGITAL OUTPUT
- MCC TERMINAL
- VSD TERMINAL
- FIELD TERMINAL
- DCS OR I/O TERMINAL
- MARSHALLING TERMINAL
- DEVICE TERMINAL
- INDICATION LAMP (cc = COLOUR)

TERMINATION LEGEND

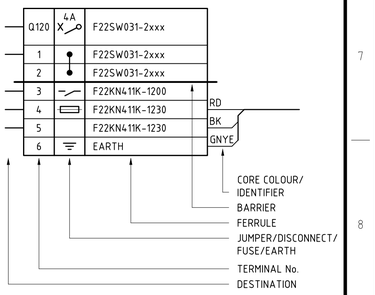

DRG No.	REFERENCES	REV	DATE	DESCRIPTION
2000-F22-SLD-EL-10251	F22-SW-031 415V MCC SINGLE LINE DIAGRAM SHEET 1	1	24NOV25	FAT REDLINES INCORPORATED
2000-F00-STD-EL-10001	GENERAL NOTES AND STANDARD DRAWINGS INDEX	0	15JAN25	APPROVED FOR CONSTRUCTION

DRAW | CHECK | DESIGN | TECH APP | PROJ APP

NORTHERN STAR RESOURCES LIMITED

PRIMERO
primero.com.au | DESIGN | CONSTRUCT | OPERATE

PRIMERO PROJECT NUMBER: 23517

INFORMATION AND REPRESENTATIONS ON THIS DRAWING ARE THE INTELLECTUAL PROPERTY OF PRIMERO UNLESS SPECIFICALLY IDENTIFIED OTHERWISE. ALL RIGHTS INCLUDING USE RESERVED

PROJECT: NORTHERN STAR RESOURCES LTD
KCGM GROWTH PROJECT

TITLE: CIL 4 - CARBON TREATMENT & ELUTION - F22-SW-031
F22-KN-411K CARBON REGEN KILN HTRS ZONE 2 BANK 3
SCHEMATIC AND TERMINATION DIAGRAM

SHEET	SCALE	DRG No.	REVISION
A1	NONE	2000-F22-SCM-EL-10262	1

O:\CAD PROJECTS\235 NORTHERN STAR RESOURCES LTD\23517 KCGM GROWTH PROJECT\03 DELIVERABLES\ELV\F22 - CIL4 CARBON TREAMENT & ELUTION\2000-F22-SCM-EL-10262.DWG 18DEC25 12:13PM HOTSEAT04