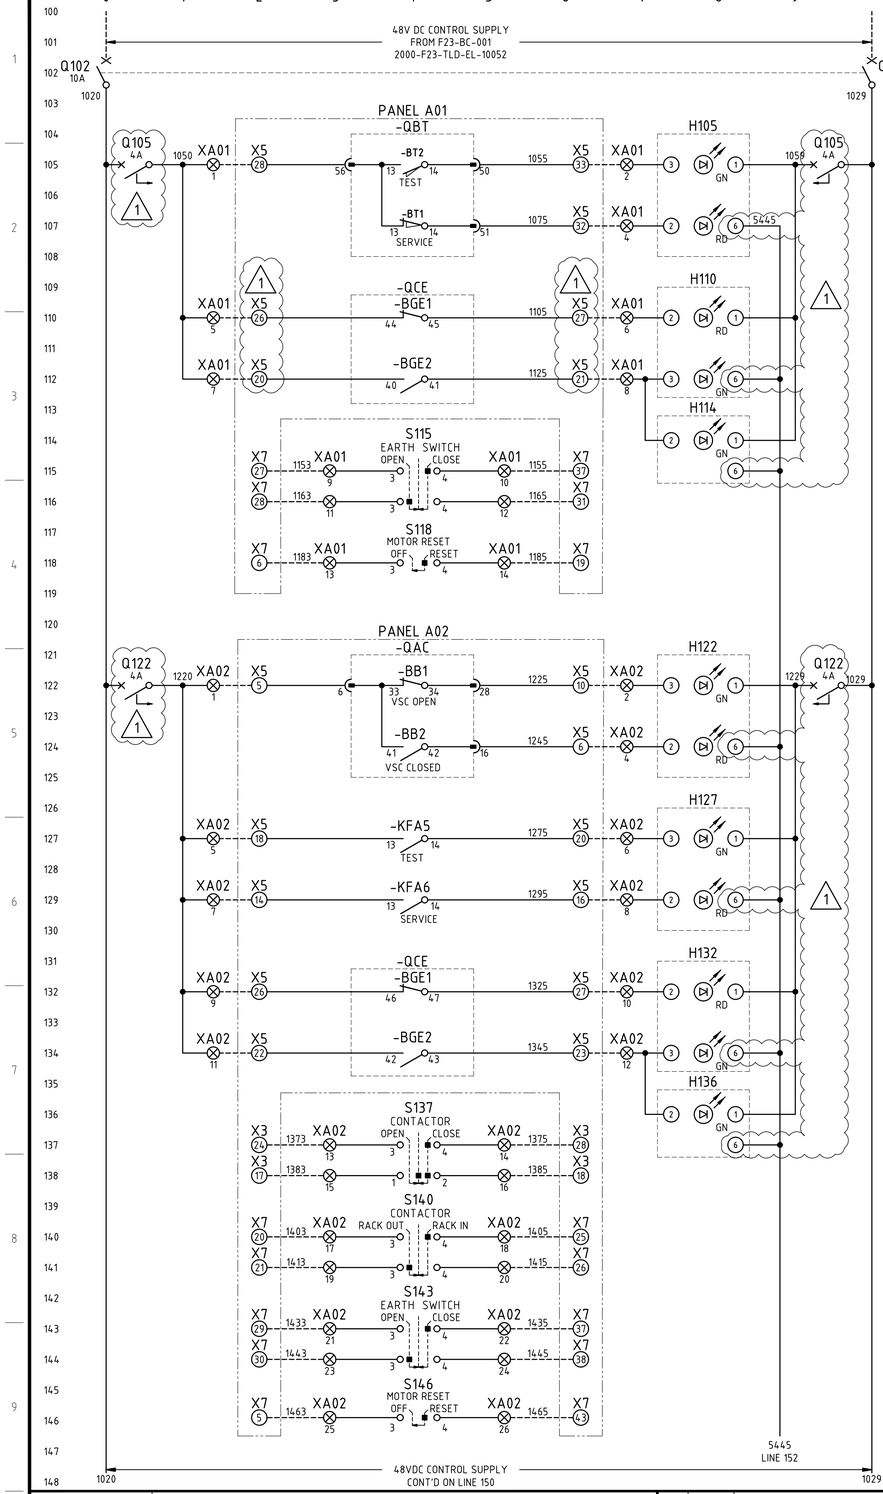


NOTES

1. WIRE NUMBER FERRULES ON TERMINAL STRIP SHALL BE PREFIXED WITH EQUIPMENT NUMBER e.g. FxxPPxxx-1200, UNLESS OTHERWISE NOTED.
2. EACH WIRE SHALL BE IDENTIFIED AT BOTH ENDS WITH FERRULES.

LEGEND

- RSP TERMINAL
- HV SWITCHBOARD TERMINAL
- DEVICE TERMINAL

DRG No.	REFERENCES
2000-EL001-D04-10080	F23SW016-LCS FINAL TAILINGS & STORAGE 11kV SWBD REMOTE SWITCHING PANEL GENERAL ARRANGEMENT
2000-F23-TER-EL-10171	F23SW016-LCS FINAL TAILINGS & STORAGE 11kV SWBD REMOTE SWITCHING PANEL TERMINATION DIAG. SH 1-2
2000-F23-SCM-EL-10171	F23SW016-LCS FINAL TAILINGS & STORAGE 11kV SWBD REMOTE SWITCHING PANEL SCHEMATIC DIAG. SH 1-5
2000-F23-SLD-EL-10001	F23-SW-016 FINAL TAILINGS & STORAGE 11kV SWBD SINGLE LINE DIAGRAM SHEET 1-2
2000-F00-STD-EL-10001	GENERAL NOTES AND STANDARD DRAWINGS INDEX

REV	DATE	DESCRIPTION	DRAW	CHECK	DESIGN	TECH APP	PROJ APP
1	17SEP25	FAT REDLINES INCORPORATED					
0	03DEC24	APPROVED FOR CONSTRUCTION					

NORTHERN STAR RESOURCES LIMITED

PRIMERO
primero.com.au | DESIGN | CONSTRUCT | OPERATE

PRIMERO PROJECT NUMBER: 23517

INFORMATION AND REPRESENTATIONS ON THIS DRAWING ARE THE INTELLECTUAL PROPERTY OF PRIMERO UNLESS SPECIFICALLY IDENTIFIED OTHERWISE. ALL RIGHTS INCLUDING USE RESERVED

PROJECT: NORTHERN STAR RESOURCES LTD
KCGM GROWTH PROJECT

TITLE: FINAL TAILINGS HANDLING & STORAGE - F23SW016-LCS
11kV SWITCHBOARD REMOTE SWITCHING PANEL
SCHEMATIC DIAGRAM SHEET 1

SHEET	SCALE	DRG No.	REVISION
A1	NONE	2000-F23-SCM-EL-10171	1

O:\CAD PROJECTS\235 NORTHERN STAR RESOURCES LTD\23517 KCGM GROWTH PROJECT\03 DELIVERABLES\EL\F23 - FINAL TAILINGS HANDLING & STORAGE\2000-F23-SCM-EL-10171.DWG 02OCT25 9:03AM HOTSEAT04