

Docusign Envelope ID: D3EAC8FF-146A-4610-AFF4-26203B4BB02C

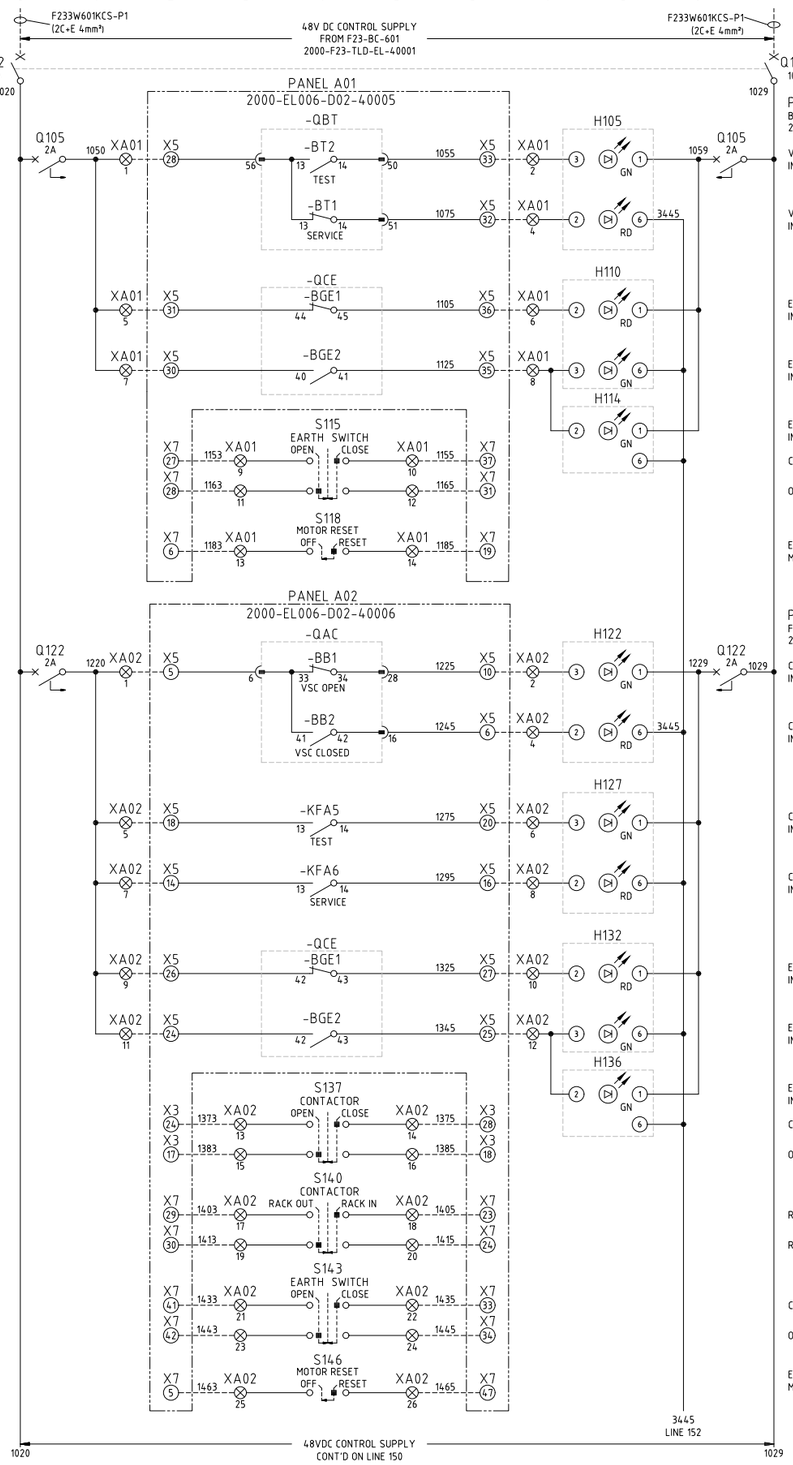

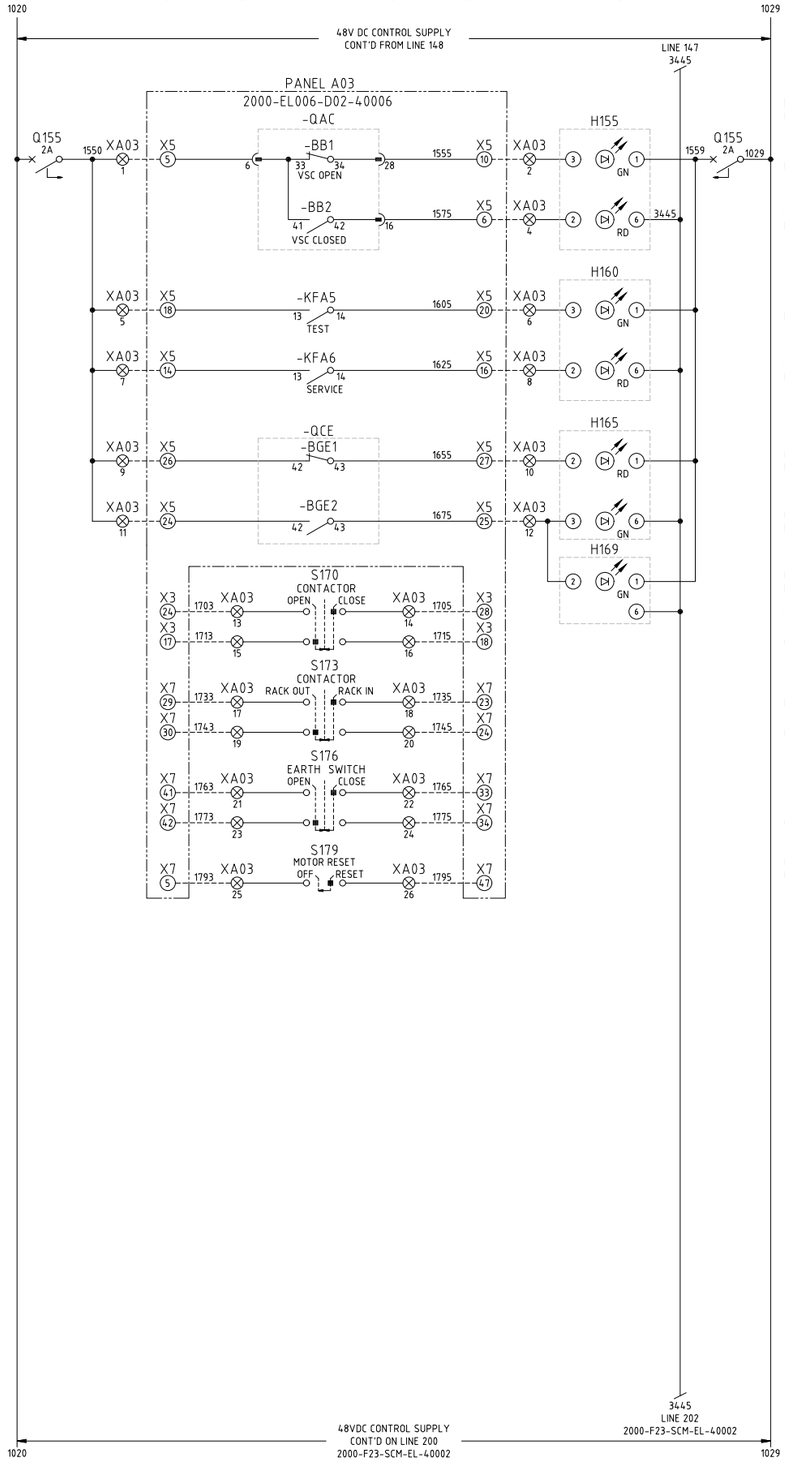

NOTES

1. WIRE NUMBER FERRULES ON TERMINAL STRIP SHALL BE PREFIXED WITH EQUIPMENT NUMBER e.g. FxxPPxxx-1200.
2. EACH WIRE SHALL BE IDENTIFIED AT BOTH ENDS WITH FERRULES.

LEGEND

- ⊗ RSP TERMINAL
- Xx (xx) HV SWITCHBOARD TERMINAL
- (x) DEVICE TERMINAL

AS BUILT

REFERENCES	DWG No	REV	DATE	REVISION	DRN	CHK	TECH APP	APP
F23-SW-601 HV SWITCHBOARD REMOTE SWITCHING PANEL GENERAL ARRANGEMENT	2000-F23-DRG-EL-40002				MZ	[redacted]	[redacted]	
F23-SW-601 HV SWITCHBOARD REMOTE SWITCHING PANEL TERMINATION DIAGRAM	2000-F23-TER-EL-40001							
F23-SW-601 HV SWITCHBOARD SINGLE LINE DIAGRAM	2000-F23-SLD-EL-40001	2	13.MAR.26	AS BUILT FOR FIM III TSF	MZ	[redacted]		
F23-SW-601 HV SWITCHBOARD REMOTE SWITCHING PANEL SCHEMATIC DIAGRAM SHT 3	2000-F23-SCM-EL-40003	1	29.OCT.25	RE-ISSUED FOR CONSTRUCTION	ET			TH
F23-SW-601 HV SWITCHBOARD REMOTE SWITCHING PANEL SCHEMATIC DIAGRAM SHT 2	2000-F23-SCM-EL-40002	0	14.MAR.25	APPROVED FOR CONSTRUCTION	PM	[redacted]		TH

NORTHERN STAR RESOURCES LIMITED

DRA PACIFIC (PTY) LIMITED

[redacted]	[redacted]	17.JAN.2025
CHECKED	[redacted]	17.JAN.2025
DESIGNED	[redacted]	17.JAN.2025
TECH APP	[redacted]	12.FEB.2025
[redacted] APP	[redacted]	21.MAR.2025
CLIENT APP		

PROJECT: KCGM FIM TSF PROJECT

TITLE: FIM III BOOSTER STATION F23-SW-601 HV SWITCHBOARD REMOTE SWITCHING PANEL SCHEMATIC DIAGRAM SHEET 1

[redacted] SCALE NTS DRG No. 2000-F23-SCM-EL-40001 REV 2