

Docusign Envelope ID: 2E3DD104-80EB-4954-A6BB-3A98DFF9A8E1

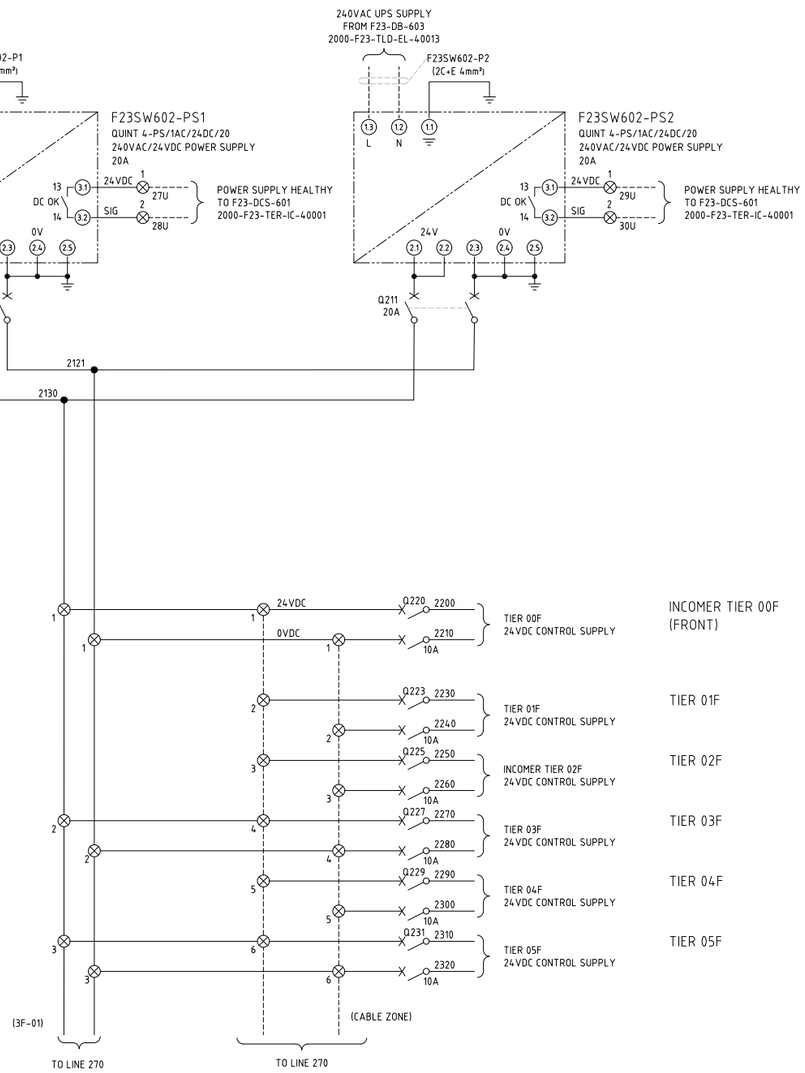

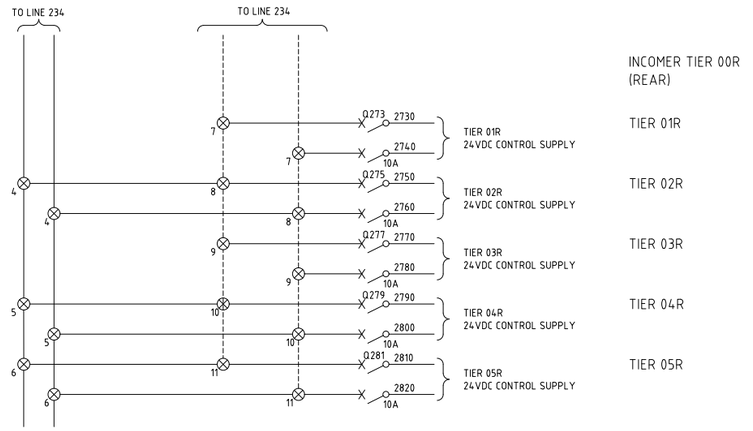


NOTES

1. TERMINALS ON TERMINAL STRIPS ABOVE 50VAC SHALL HAVE A SEPARATE PERSPEX SHROUD AND SHALL BE LABELLED "DANGER xxxVAC".
2. WIRE NUMBER FERRULES ON TERMINAL STRIP SHALL BE PREFIXED WITH EQUIPMENT NUMBER e.g. F23SW602-1200.
3. EACH WIRE SHALL BE IDENTIFIED AT BOTH ENDS WITH FERRULES.

LEGEND

- 00/01/00 — DCS DIGITAL INPUT
- 00/02/00 — DCS DIGITAL OUTPUT
- MCC TERMINAL
- VSD TERMINAL
- FIELD TERMINAL
- DCS OR I/O TERMINAL
- MARSHALLING TERMINAL
- DEVICE TERMINAL
- INDICATION LAMP (cc = COLOUR)

TERMINATION LEGEND

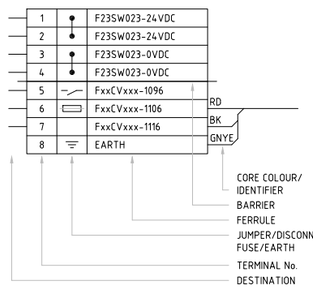

MCC CELL LOCATION 3F-01

AS BUILT

REFERENCES	DWG No	REV	DATE	REVISION	DRN	CHK	TECH APP	PROJ APP
					MZ	EA	MC	MBB
		3	13.MAR.26	AS BUILT FOR FIM III TSF	MZ	EA	MC	MBB
		2	07.JAN.26	RE-APPROVED FOR CONSTRUCTION	ET	MC	KV	TH
F23-DB-603 240VAC UPS DB THREE LINE DIAGRAM	2000-F23-TLD-EL-40013	1	07.JUL.25	RE-APPROVED FOR CONSTRUCTION	TG	KVN	KVN	TH
F23-SW-602 LV MOTOR CONTROL CENTRE INCOMER SCHEMATIC DIAGRAM SHEET 2	2000-F23-SCM-EL-40012	0	24.MAR.25	APPROVED FOR CONSTRUCTION	PM	KVN	DK	TH

NORTHERN STAR RESOURCES LIMITED

DRA PACIFIC (PTY) LIMITED

[redacted]	[redacted]	11.NOV.2024
CHECKED	J.Y.WEE	11.NOV.2024
DESIGNED	[redacted]	11.NOV.2024
TECH APP	[redacted]	09.DEC.2024
[redacted]APP	[redacted]	21.MAR.2025
CLIENT APP		

PROJECT: KCGM
FIM TSF PROJECT

TITLE: FIM III BOOSTER STATION
F23-SW-602 24VDC DISTRIBUTION
SCHEMATIC DIAGRAM

[redacted] | SCALE NTS | DRG No. 2000-F23-SCM-EL-40014 | REV 3