


Docusign Envelope ID: D3EAC8FF-146A-4610-AFF4-26203B4BB02C

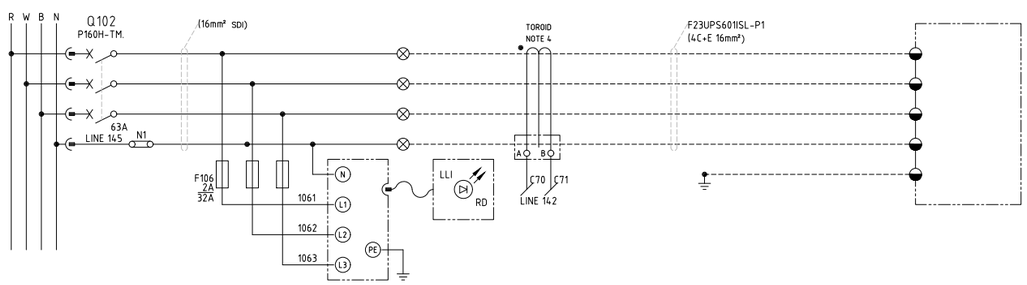

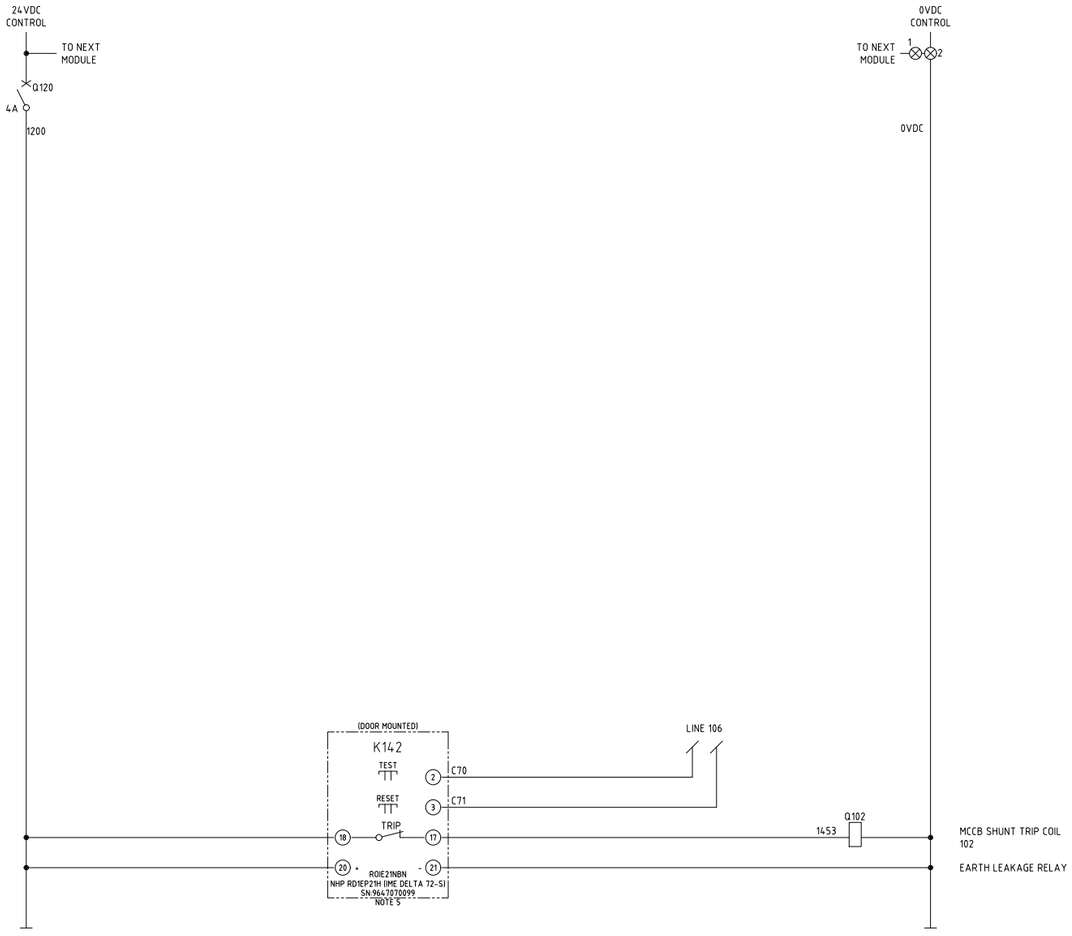

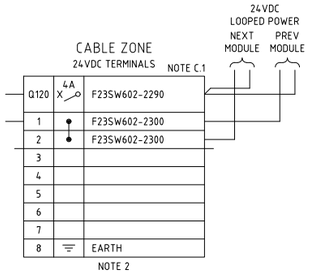


NOTES

1. TERMINALS ON TERMINAL STRIPS ABOVE 50VAC SHALL HAVE A SEPARATE PERSPEX SHROUD AND SHALL BE LABELLED "DANGER xxxVAC".
2. WIRE NUMBER FERRULES ON TERMINAL STRIP SHALL BE PREFIXED WITH EQUIPMENT NUMBER e.g. F23UPS601-1200.
3. EACH WIRE SHALL BE IDENTIFIED AT BOTH ENDS WITH FERRULES.
4. NHP TDG×2 TOROID TO SUIT CABLE DIAMETER (TOROID MIN. 30mA).
   TOROID DETAILS
   TOGB2
   SN:0461520027
   IN:70A
5. EARTH LEAKAGE RELAY USER INTERFACE TO BE MOUNTED ON MCC MODULE DOOR.
   RELAY SETTINGS SET TO:
   IΔn ="1A".
   DELAY = "100ms".
   RANGES = "x1".
   FAILSAFE MODE = "Ne".
   RESET = "MAN".
6. REFER TO CABLE SCHEDULE 2000-F23-LST-EL-40003.

LEGEND

- 00/01/00 — DCS DIGITAL INPUT
- 00/02/00 — DCS DIGITAL OUTPUT
- ⊗ — MCC TERMINAL
- ◓ — VSD TERMINAL
- ◒ — FIELD TERMINAL
- ◑ — DCS OR I/O TERMINAL
- ◧ — MARSHALLING TERMINAL
- (x) — DEVICE TERMINAL
- ⊗ cc — INDICATION LAMP, cc = COLOUR

TERMINATION LEGEND

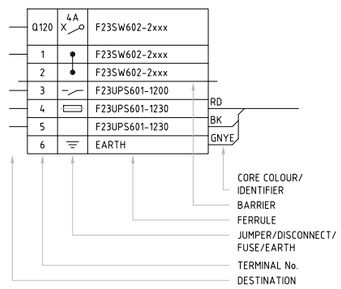

MCC CELL LOCATION 4F-14

AS BUILT

REFERENCES	DWG No	REV	DATE	REVISION	DRN	CHK	TECH APP	APP
F23-DB-603 HV/LV SWITCHROOM 240VAC UPS DB THREE-LINE DIAGRAM	2000-F23-TLD-EL-40013	2	13.MAR.26	AS BUILT FOR FIM III TSF	[redacted]	EA	[redacted]	[redacted]
F23-SW-602 LV MOTOR CONTROL CENTRE SINGLE LINE DIAGRAM SHT 1 OF 2	2000-F23-SLD-EL-40011	1	07.JUL.25	RE-APPROVED FOR CONSTRUCTION	TG	KVN		
GENERAL NOTES AND STANDARD DRAWINGS INDEX	2000-F00-STD-EL-10001	0	17.JAN.25	ISSUED FOR CONSTRUCTION	TG	[redacted]	KVN	

NORTHERN STAR RESOURCES LIMITED

DRA PACIFIC (PTY) LIMITED

[redacted]	[redacted]	02.[redacted].2024
CHECKED	K.VAN NAMEN	19.DEC.2024
DESIGNED	[redacted]	20.[redacted].2024
TECH APP	[redacted]	20.DEC.2024
[redacted] APP	[redacted]	17.JAN.2025

PROJECT: KCGM
FIM TSF PROJECT

TITLE: FIM III BOOSTER STATION
F23UPS601-ISL 240VAC UPS MAINT. BYPASS SWITCH
CONTROL SCHEMATIC DIAGRAM

A1 | SCALE NTS | DRG No. 2000-F23-SCM-EL-40017 | REV 2