


Docusign Envelope ID: D3EAC8FF-146A-4610-AFF4-26203B4BB02C

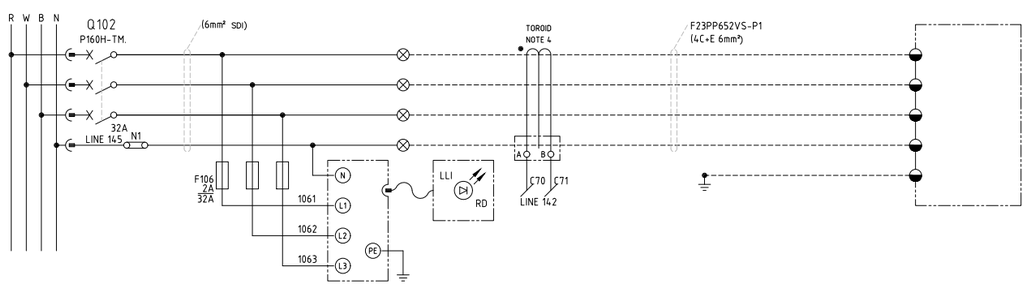

F23PP652-VS
FIM III BOOSTER PUMP 2
VARIABLE SPEED DRIVE
415V AUXILIARY SUPPLY
9kW

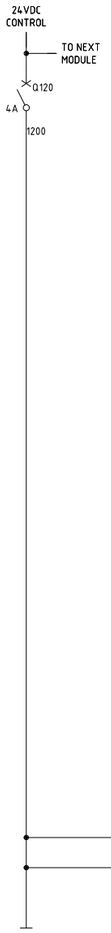

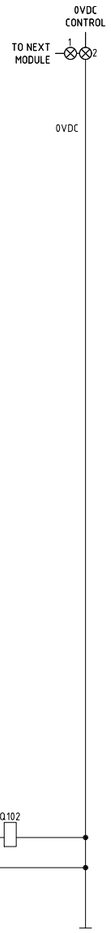


CABLE ZONE
24VDC TERMINALS
NOTE C.1

24VDC LOOPED POWER
NEXT MODULE
PREV MODULE

Q120	4A	F23SW602-2790
1		F23SW602-2800
2		F23SW602-2800
3		
4		
5		
6		
7		
8		EARTH

NOTE 2

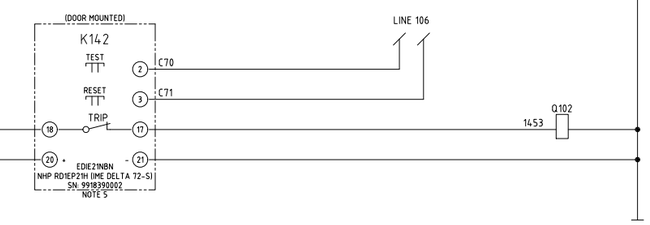

MCCB SHUNT TRIP COIL
102

EARTH LEAKAGE RELAY

MCC CELL LOCATION 4R-10

NOTES

1. TERMINALS ON TERMINAL STRIPS ABOVE 50VAC SHALL HAVE A SEPARATE PERSPEX SHROUD AND SHALL BE LABELLED "DANGER xxxVAC".
2. WIRE NUMBER FERRULES ON TERMINAL STRIP SHALL BE PREFIXED WITH EQUIPMENT NUMBER e.g. F23PP652VS-1200.
3. EACH WIRE SHALL BE IDENTIFIED AT BOTH ENDS WITH FERRULES.
4. NHP TDG×2 TOROID TO SUIT CABLE DIAMETER (TOROID MIN. 30mA).
   TOROID DETAILS
   TOGB2
   SN: 0461520069
   IN: 70A
5. EARTH LEAKAGE RELAY USER INTERFACE TO BE MOUNTED ON MCC MODULE DOOR.
   RELAY SETTINGS SET TO:
   IΔn ="1A".
   DELAY = "100ms".
   RANGES = "x1".
   FAILSAFE MODE = "Ne".
   RESET = "MAN".
6. REFER TO CABLE SCHEDULE 2000-F23-LST-EL-40003.


LEGEND

- 00/01/00 — DCS DIGITAL INPUT
- 00/02/00 — DCS DIGITAL OUTPUT
- MCC TERMINAL
- VSD TERMINAL
- FIELD TERMINAL
- DCS OR I/O TERMINAL
- MARSHALLING TERMINAL
- (x) DEVICE TERMINAL
- cc — INDICATION LAMP, cc = COLOUR

DCS LEGEND



TERMINATION LEGEND

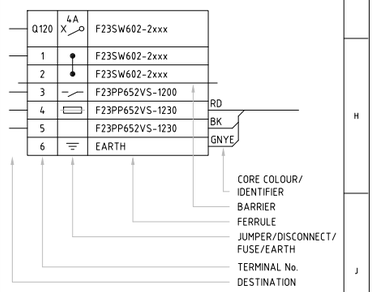

AS BUILT

REFERENCES	DWG No	REV	DATE	REVISION	DRN	CHK	TECH APP	APP
		2	13.MAR.26	AS BUILT FOR FIM III TSF	[redacted]	EA	[redacted]	[redacted]
F23-SW-602 LV MOTOR CONTROL CENTRE SINGLE LINE DIAGRAM SHT 1 OF 2	2000-F23-SLD-EL-40011	1	07.JUL.25	RE-APPROVED FOR CONSTRUCTION	TG	KVN		
GENERAL NOTES AND STANDARD DRAWINGS INDEX	2000-F00-STD-EL-10001	0	17.JAN.25	ISSUED FOR CONSTRUCTION	[redacted]	K[redacted]	KVN	

NORTHERN STAR RESOURCES LIMITED

DRA PACIFIC (PTY) LIMITED

[redacted]	[redacted]	02 [redacted] 2024
CHECKED	K.VAN NAMEN	19.DEC.2024
DESIGNED	[redacted]	20.NOV.2024
TECH APP	[redacted]	20.DEC.2024
[redacted] APP	[redacted]	17.JAN.2025

[redacted] KCGM
FIM TSF PROJECT

TITLE: FIM III BOOSTER STATION
F23-PP-652 FIM III BOOSTER PUMP 2 VSD 415V AUX. SUPPLY CONTROL SCHEMATIC DIAGRAM

A1 | SCALE NTS | DRG No. 2000-F23-SCM-EL-40019 | REV 2