
Docusign Envelope ID: D3EAC8FF-146A-4610-AFF4-26203B4BB02C

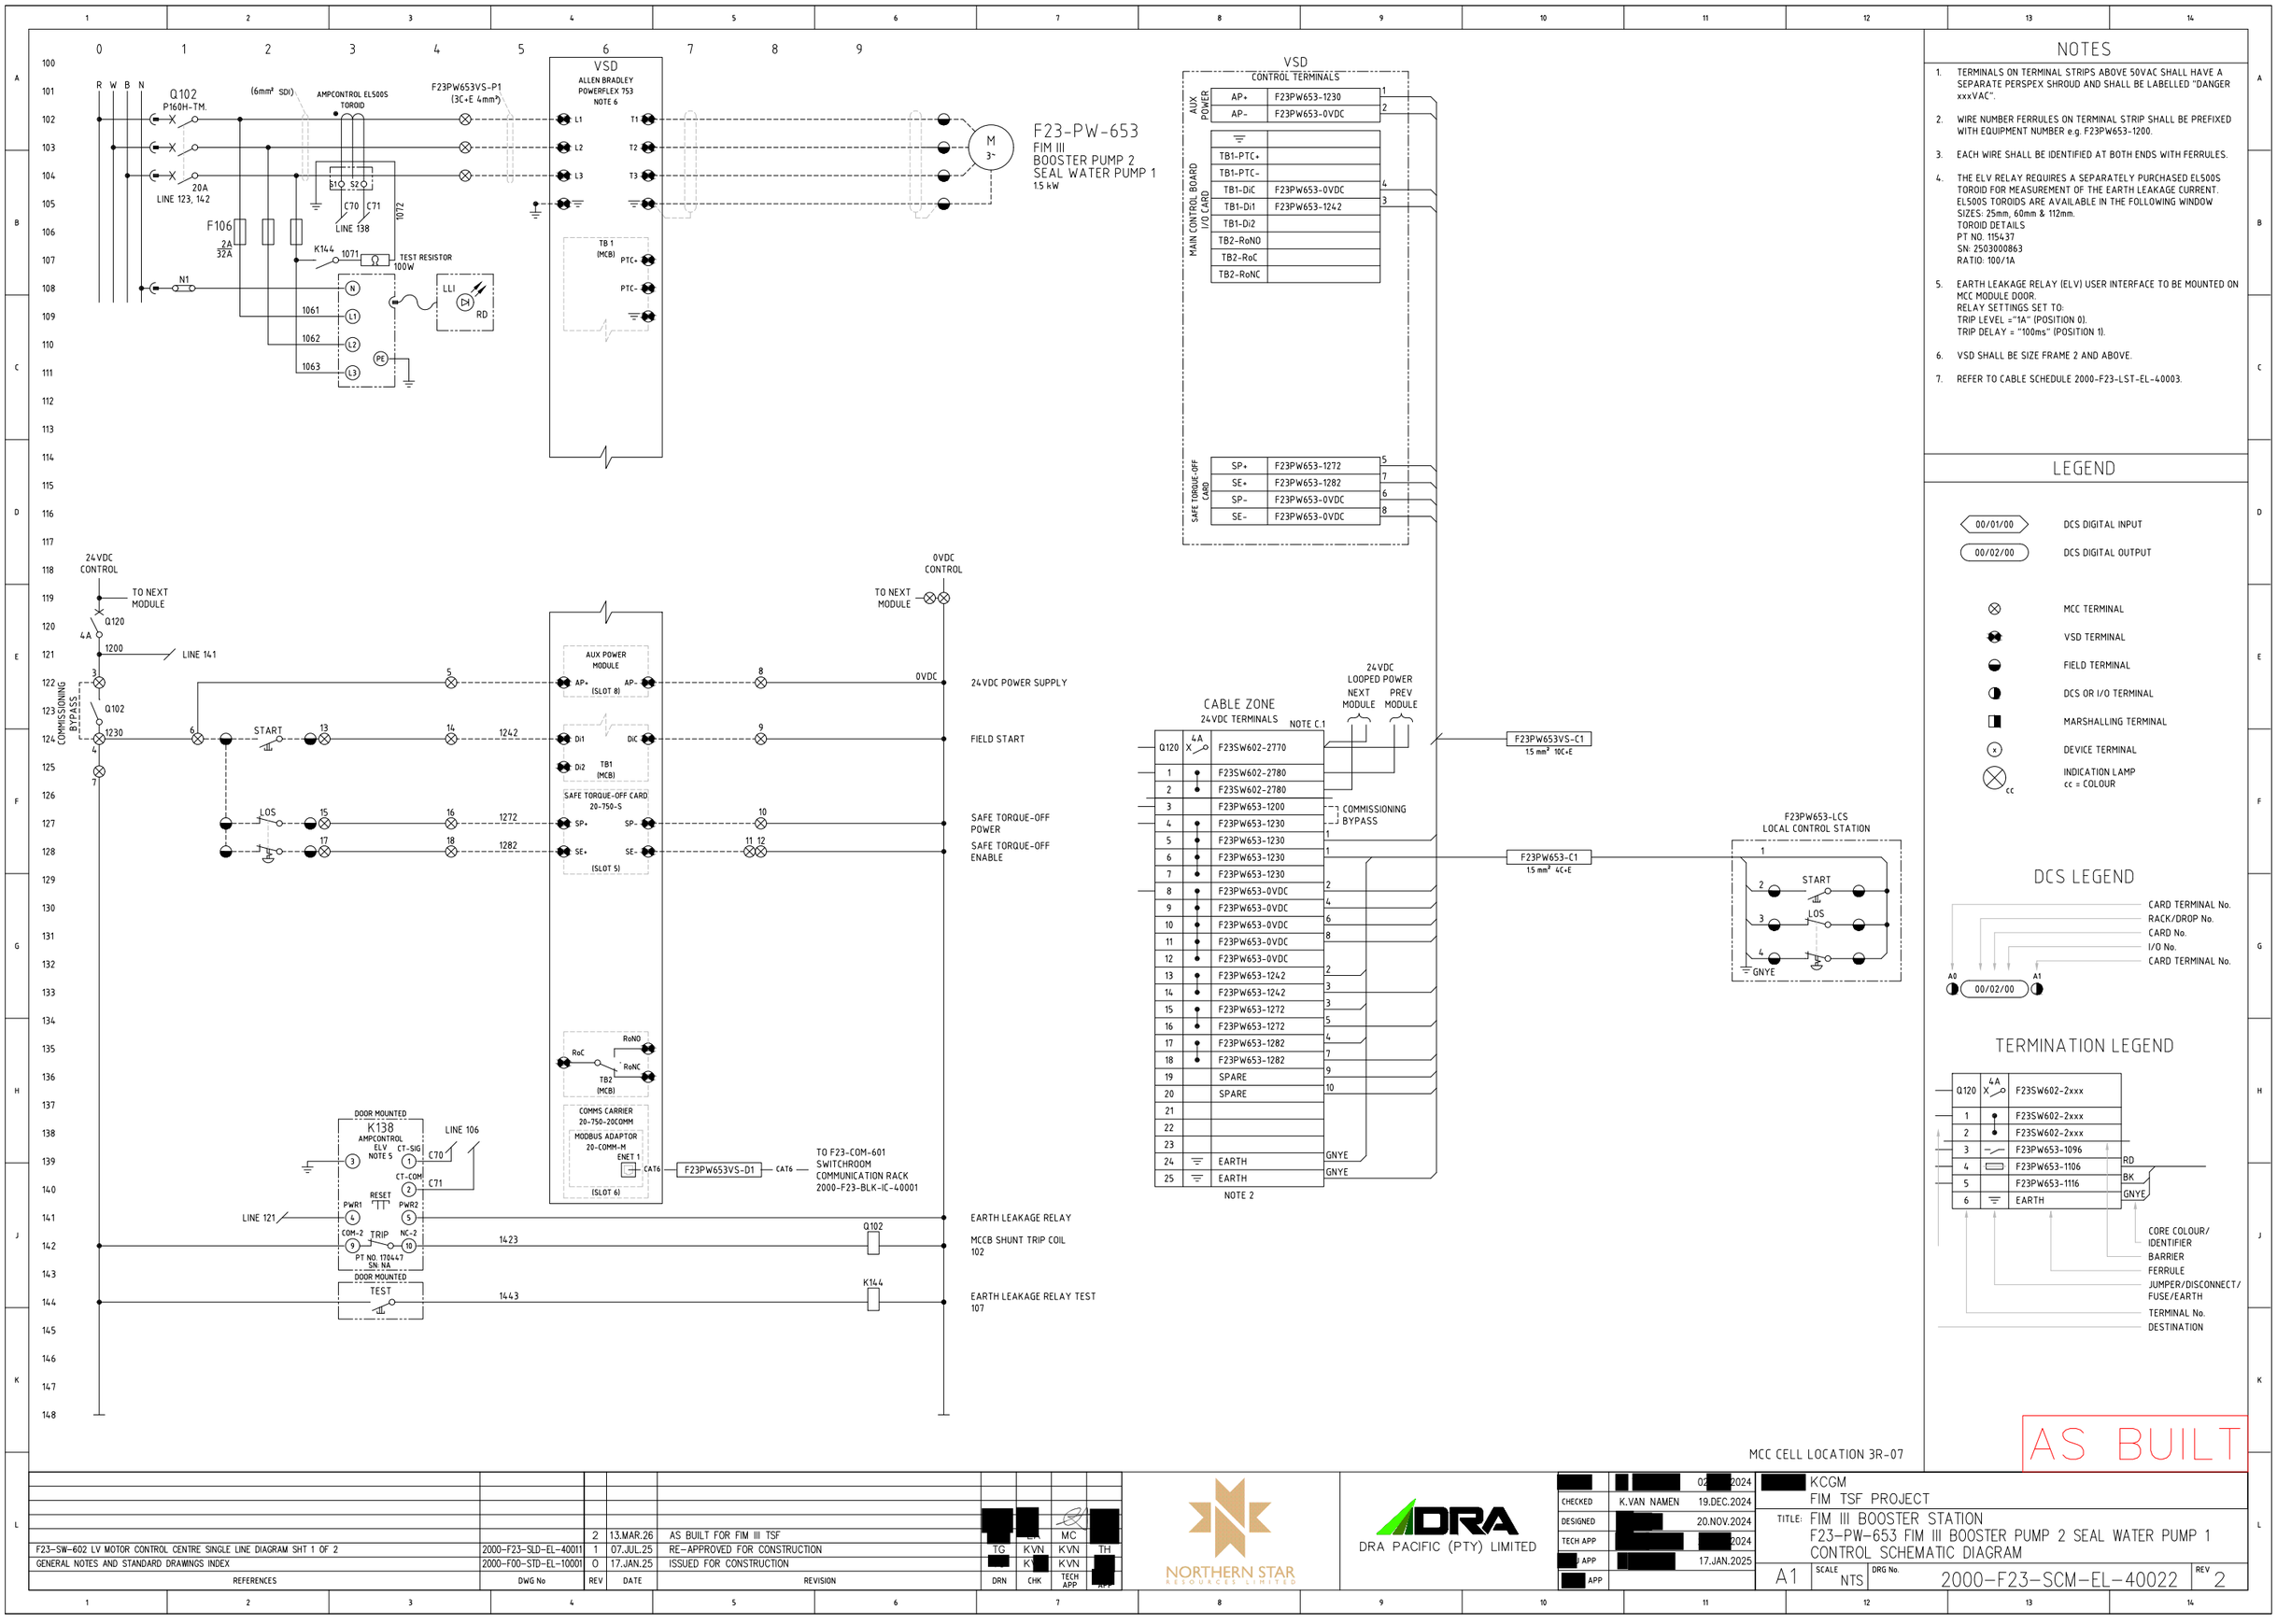

NOTES

1. TERMINALS ON TERMINAL STRIPS ABOVE 50VAC SHALL HAVE A SEPARATE PERSPEX SHROUD AND SHALL BE LABELLED "DANGER xxxVAC".
2. WIRE NUMBER FERRULES ON TERMINAL STRIP SHALL BE PREFIXED WITH EQUIPMENT NUMBER e.g. F23PW653-1200.
3. EACH WIRE SHALL BE IDENTIFIED AT BOTH ENDS WITH FERRULES.
4. THE ELV RELAY REQUIRES A SEPARATELY PURCHASED EL500S TOROID FOR MEASUREMENT OF THE EARTH LEAKAGE CURRENT. EL500S TOROIDS ARE AVAILABLE IN THE FOLLOWING WINDOW SIZES: 25mm, 60mm & 112mm.
   TOROID DETAILS
   PT NO. 115437
   SN: 2503000863
   RATIO: 100/1A
5. EARTH LEAKAGE RELAY (ELV) USER INTERFACE TO BE MOUNTED ON MCC MODULE DOOR.
   RELAY SETTINGS SET TO:
   TRIP LEVEL = "1A" (POSITION 0).
   TRIP DELAY = "100ms" (POSITION 1).
6. VSD SHALL BE SIZE FRAME 2 AND ABOVE.
7. REFER TO CABLE SCHEDULE 2000-F23-LST-EL-40003.

LEGEND

- 00/01/00 — DCS DIGITAL INPUT
- 00/02/00 — DCS DIGITAL OUTPUT
- MCC TERMINAL
- VSD TERMINAL
- FIELD TERMINAL
- DCS OR I/O TERMINAL
- MARSHALLING TERMINAL
- DEVICE TERMINAL
- INDICATION LAMP (cc = COLOUR)

DCS LEGEND

TERMINATION LEGEND

MCC CELL LOCATION 3R-07

AS BUILT

REFERENCES	DWG No	REV	DATE	REVISION	DRN	CHK	TECH APP	APP
		2	13.MAR.26	AS BUILT FOR FIM III TSF	[redacted]	[redacted]	MC	[redacted]
F23-SW-602 LV MOTOR CONTROL CENTRE SINGLE LINE DIAGRAM SHT 1 OF 2	2000-F23-SLD-EL-40011	1	07.JUL.25	RE-APPROVED FOR CONSTRUCTION	TG	K.VN	K.VN	TH
GENERAL NOTES AND STANDARD DRAWINGS INDEX	2000-F00-STD-EL-10001	0	17.JAN.25	ISSUED FOR CONSTRUCTION	[redacted]	K.[redacted]	K.VN	[redacted]

NORTHERN STAR RESOURCES LIMITED

DRA PACIFIC (PTY) LIMITED

[redacted]	[redacted]	02.[redacted].2024
CHECKED	K.VAN NAMEN	19.DEC.2024
DESIGNED	[redacted]	20.NOV.2024
TECH APP	[redacted]	[redacted].2024
[redacted] APP	[redacted]	17.JAN.2025
[redacted] APP		

[redacted] KCGM
FIM TSF PROJECT

TITLE: FIM III BOOSTER STATION
F23-PW-653 FIM III BOOSTER PUMP 2 SEAL WATER PUMP 1
CONTROL SCHEMATIC DIAGRAM

A1 | SCALE NTS | DRG No. 2000-F23-SCM-EL-40022 | REV 2