
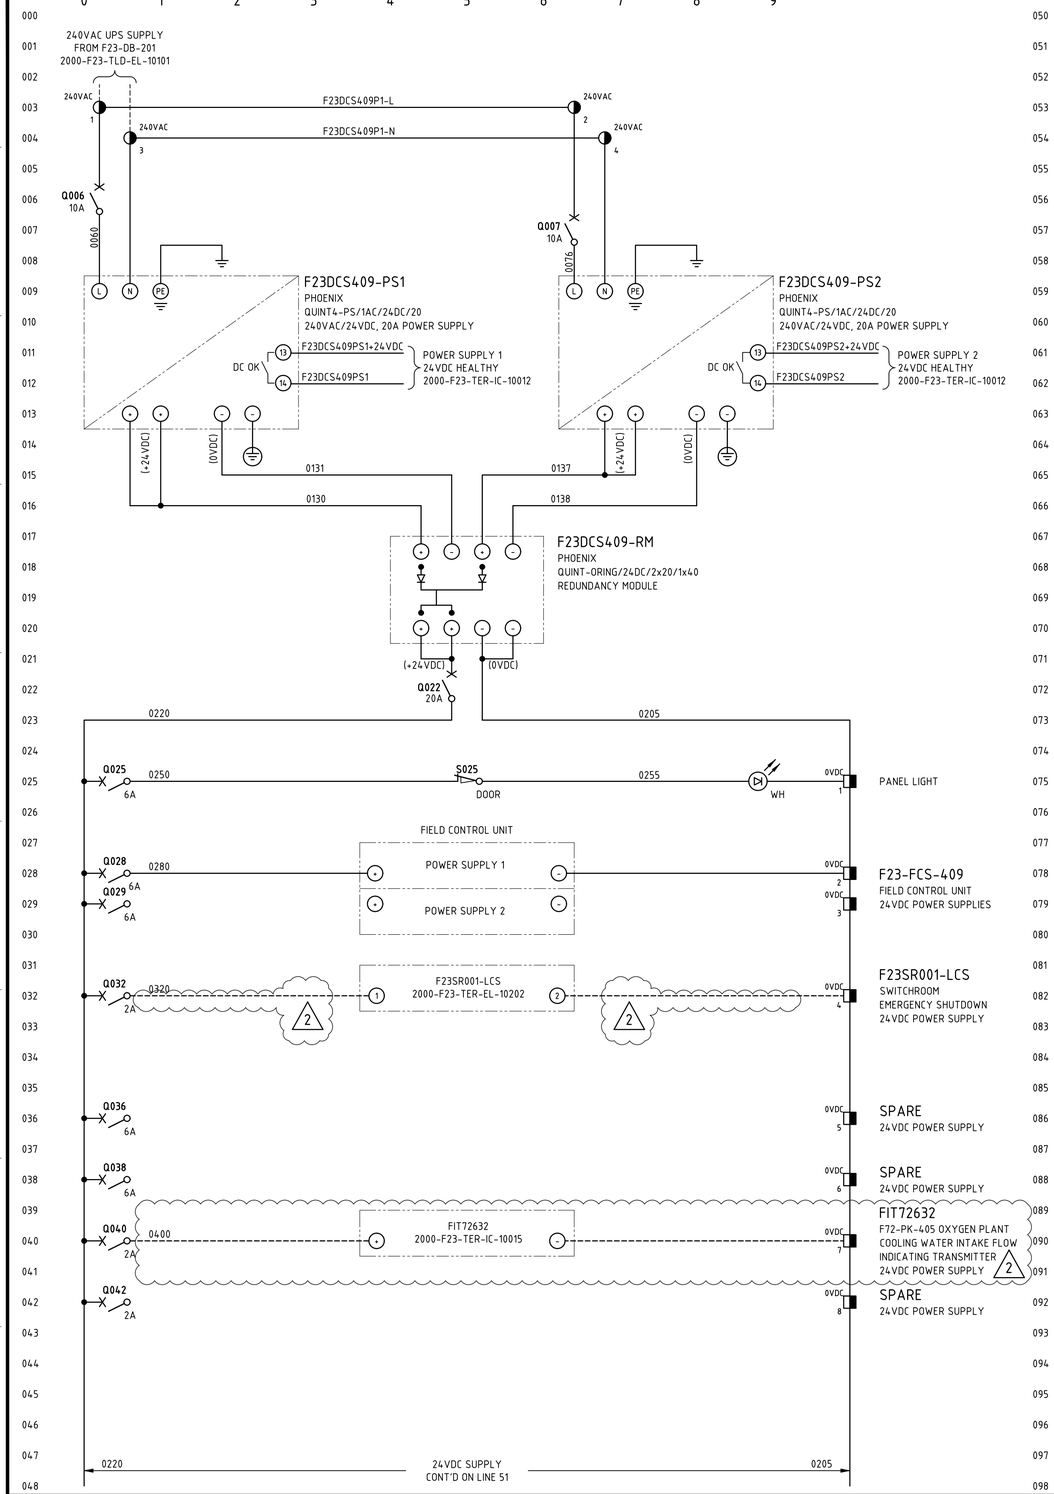


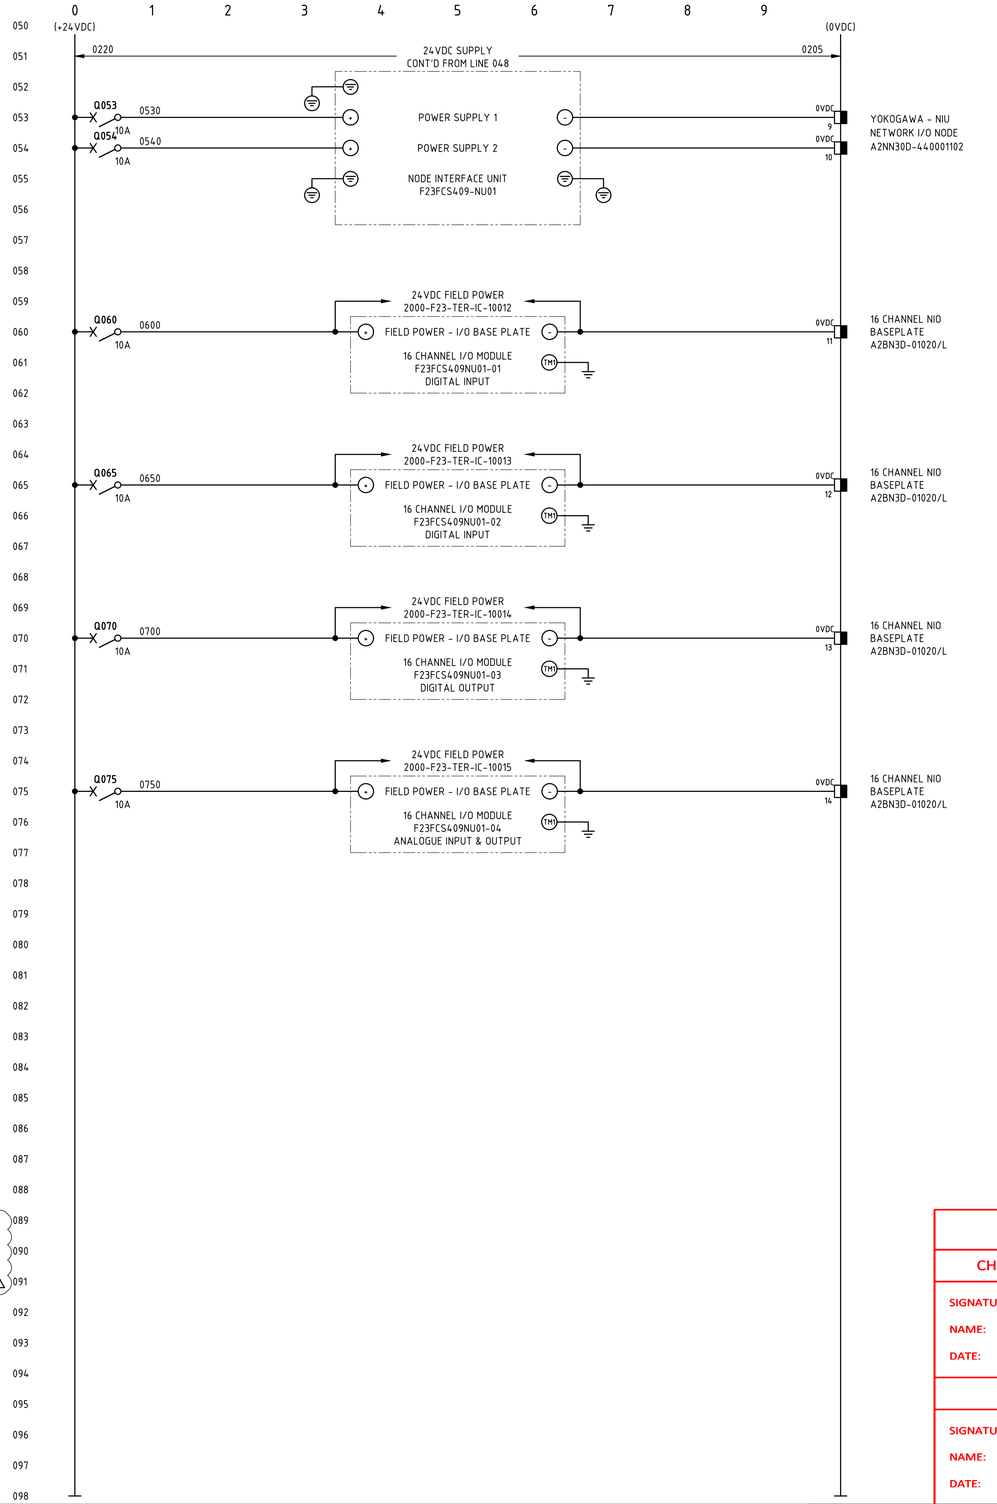

NOTES

1. TERMINALS ON TERMINAL STRIPS ABOVE 50VAC SHALL HAVE A SEPARATE PERSPEX SHROUD AND SHALL BE LABELLED "DANGER xxxVAC".
2. WIRE NUMBER FERRULES ON TERMINAL STRIP SHALL BE PREFIXED WITH EQUIPMENT NUMBER e.g. F23DCS409-xxxx.
3. EACH WIRE SHALL BE IDENTIFIED AT BOTH ENDS WITH FERRULES.
4. FOR NETWORK CONNECTION & BUS CABLING DETAILS REFER TO DCS PANEL COMMUNICATIONS TERMINATION DIAGRAMS.
5. INSTRUMENT EARTH BAR TO BE BONDED TO MAIN EARTH BAR WITH SOLID COPPER LINK.

LEGEND

- FIELD TERMINAL
- DCS OR I/O TERMINAL
- 0VDC TERMINAL FOR 24VDC (2)
- DEVICE TERMINAL
- INDICATION LAMP, cc = COLOUR
- EARTH BAR
- INSTRUMENT EARTH BAR

NIO BASEPLATE

F23FCS409NU01-01

- NETWORKED INPUT/OUTPUT (N-IO) BASEPLATE
- NODE INTERFACE UNIT (N-IU)
- FIELD CONTROL UNIT

AS CONSTRUCTED

CHANGE: ☐ NO CHANGE: ☒

SIGNATURE: *George Forrest*
NAME: GEORGE FORREST
DATE: 2025/11/19

ENGINEER SIGN OFF

SIGNATURE: Sanam Gurung
NAME: SANAM GURUNG
DATE: 2025/11/19

DRG No.	REFERENCES
2000-F23-TLD-EL-10101	F23-DB-201 LV SWITCHROOM 240VAC UPS DB THREE LINE DIAGRAM
2000-F23-DRG-IC-10011	F23-DCS-409 415V SWITCHROOM DCS PANEL GENERAL ARRANGEMENT
2000-F23-TER-IC-10011	F23-DCS-409 415V SWITCHROOM DCS PANEL COMMUNICATIONS TERMINATION DIAGRAM
2000-F23-TER-IC-10012	F23-DCS-409 415V SWITCHROOM DCS PANEL TERMINATION DIAGRAMS SHEET 1 (TO SHEET 4 - 10015)
2000-F00-STD-EL-10001	GENERAL NOTES AND STANDARD DRAWINGS INDEX

REV	DATE	DESCRIPTION	DRAW	CHECK	DESIGN	TECH APP	PROJ APP
2RL1	19/11/25	As Constructed for Sub-System F23.10.10 FOR SP1					
2	19SEP25	FAT REDLINES INCORPORATED					
1	12DEC24	ADDED EARTHING DETAILS. RE-ISSUED FOR CONSTRUCTION					
0	23OCT24	APPROVED FOR CONSTRUCTION					

NORTHERN STAR RESOURCES LIMITED

PRIMERO
primero.com.au | DESIGN | CONSTRUCT | OPERATE
PRIMERO PROJECT NUMBER: 23517

INFORMATION AND REPRESENTATIONS ON THIS DRAWING ARE THE INTELLECTUAL PROPERTY OF PRIMERO UNLESS SPECIFICALLY IDENTIFIED OTHERWISE. ALL RIGHTS INCLUDING USE RESERVED

PROJECT: NORTHERN STAR RESOURCES LTD
KCGM GROWTH PROJECT

TITLE: FINAL TAILINGS HANDLING & STORAGE - F23-SR-002
F23-DCS-409 415V SWITCHROOM DCS PANEL
SCHEMATIC DIAGRAM

SHEET	SCALE	DRG No.	REVISION
A1	NONE	2000-F23-SCM-IC-10011	2 RL1

O:\CAD PROJECTS\235 NORTHERN STAR RESOURCES LTD\23517 KCGM GROWTH PROJECT\03 DELIVERABLES\IC\F23 - FINAL TAILINGS HANDLING & STORAGE\2000-F23-SCM-IC-10011.DWG 02OCT25 9:04:AM HOTSEAT04