

Docusign Envelope ID: 661AA0FE-B647-84F7-80EB-F26CC03C9F72

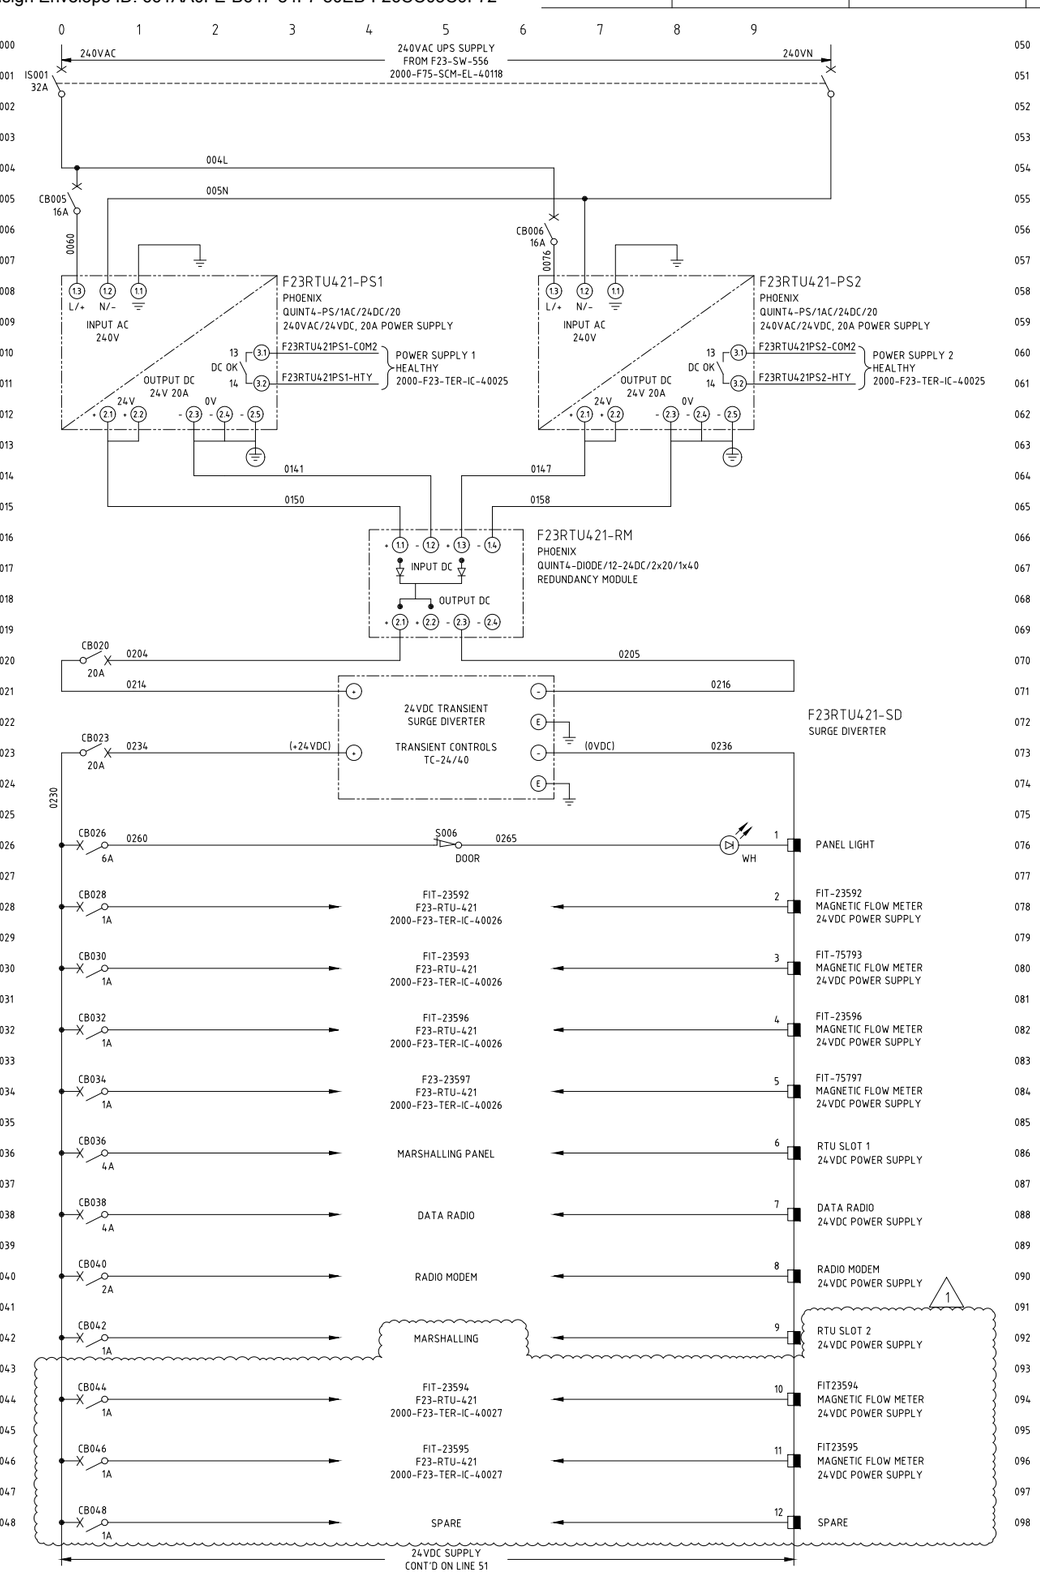

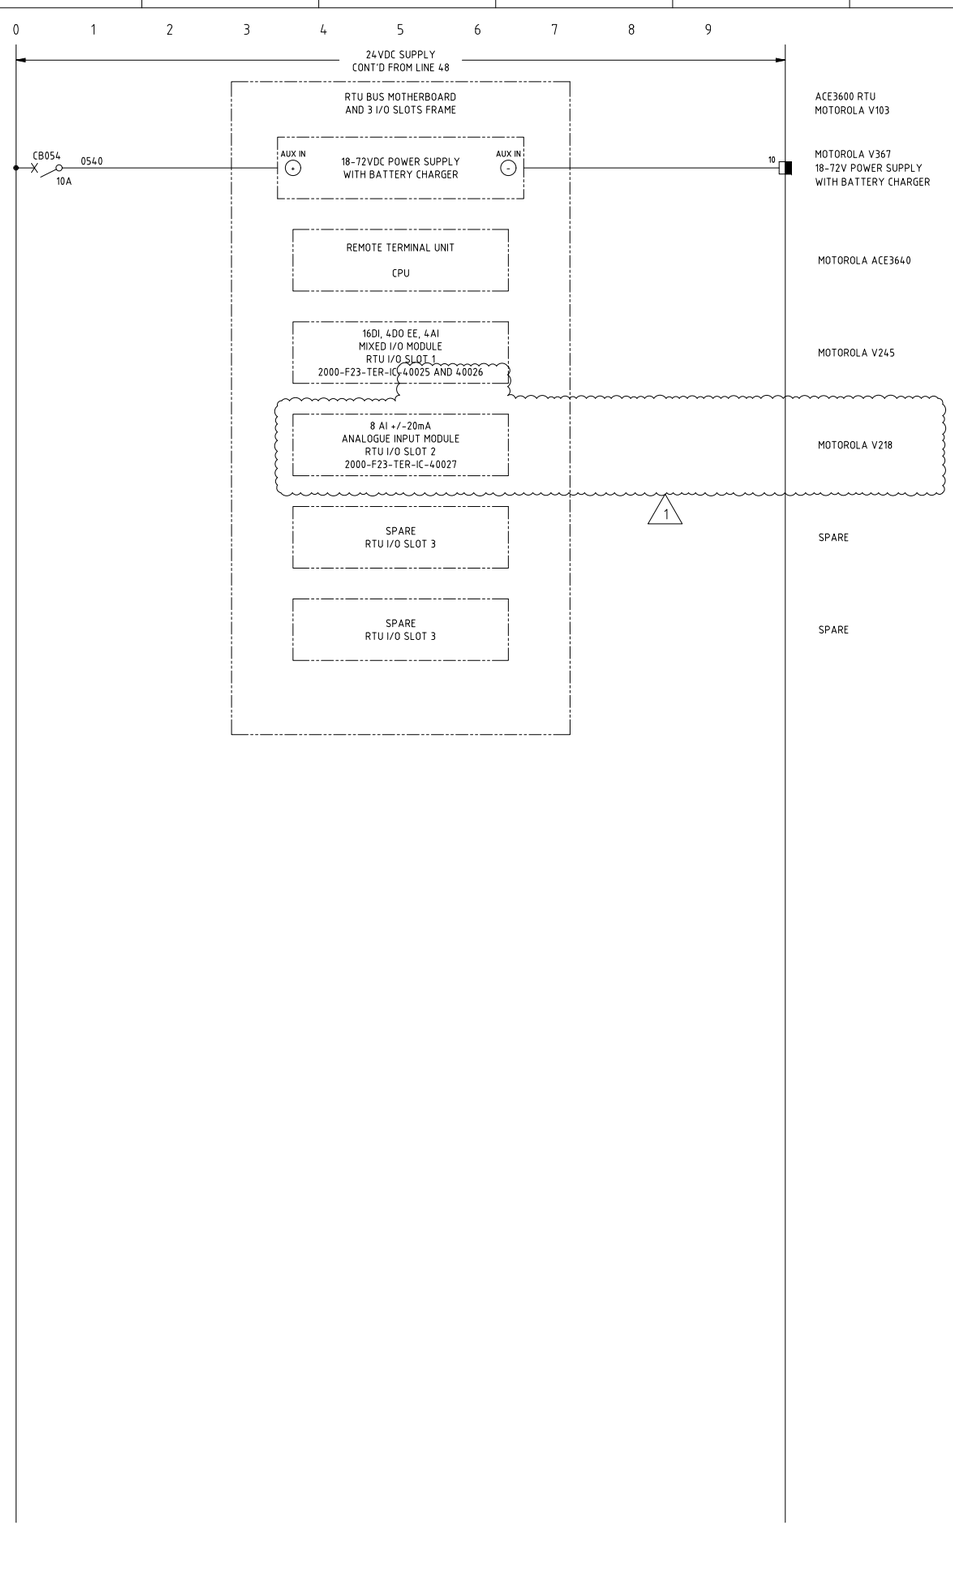

NOTES

1. TERMINALS ON TERMINAL STRIPS ABOVE 50VAC SHALL HAVE A SEPARATE PERSPEX SHROUD AND SHALL BE LABELLED "DANGER xxxVAC".
2. WIRE NUMBER FERRULES ON TERMINAL STRIP SHALL BE PREFIXED WITH EQUIPMENT NUMBER e.g. FxxPPxxx-1200.
3. EACH WIRE SHALL BE IDENTIFIED AT BOTH ENDS WITH FERRULES.

LEGEND

- FIELD TERMINAL
- DCS OR I/O TERMINAL
- MARSHALLING TERMINAL
- DEVICE TERMINAL
- INDICATION LAMP (cc = COLOUR)
- EARTH BAR
- INSTRUMENT EARTH BAR (IEB)

NORTHERN STAR RESOURCES LIMITED

Approved	X
Approved as Noted	
Not Approved	
For Information Only	

[redacted] Date 25.06.2026

RELIEVE THE SUPPLIER / CONTRACTOR OF ITS RESPONSIBILITY OR LIABILITIES UNDER THE PURCHASE ORDER / CONTRACT

ISSUED FOR CONSTRUCTION

REFERENCES	DWG No	REV	DATE	REVISION	DRN	CHK	TECH APP	PROJ APP
FIM III VALVE STATION TELEMETRY PANEL – F23-RTU-421 – RTU CABINET GENERAL ARRANGEMENT	2000-F23-DRG-IC-40020				ET	MC	KV	TH
FIM III TAILINGS DAM F75-SW-556 FIM III TSF SWITCHBOARD 1 SCHEMATIC DIAGRAM SHEET 1	2000-F75-SCM-EL-40118	1	01.JUN.26	RE-ISSUED FOR CONSTRUCTION	ET	MC	KV	TH
GENERAL NOTES AND STANDARD DRAWING INDEX	2000-F00-STD-EL-10001	0	22.JAN.26	ISSUED FOR CONSTRUCTION	ET	MC	KV	TH

NORTHERN STAR RESOURCES LIMITED

DRA PACIFIC (PTY) LIMITED

DRAWN	E. THOMAS	23.DEC.25
CHECKED	M. CHARLESWORTH	23.DEC.25
DESIGNED	E. THOMAS	23.DEC.5
TECH APP	K. VILJOEN	23.DEC.25
PROJ APP		
CLIENT APP		

PROJECT: KCGM
FIM – TSF PROJECT

TITLE: FIM III VALVE STATION
F23-RTU-421 – TELEMETRY PANEL
SCHEMATIC DIAGRAM

A1 | SCALE NTS | DRG No. 2000-F23-SCM-IC-40020 | REV 1