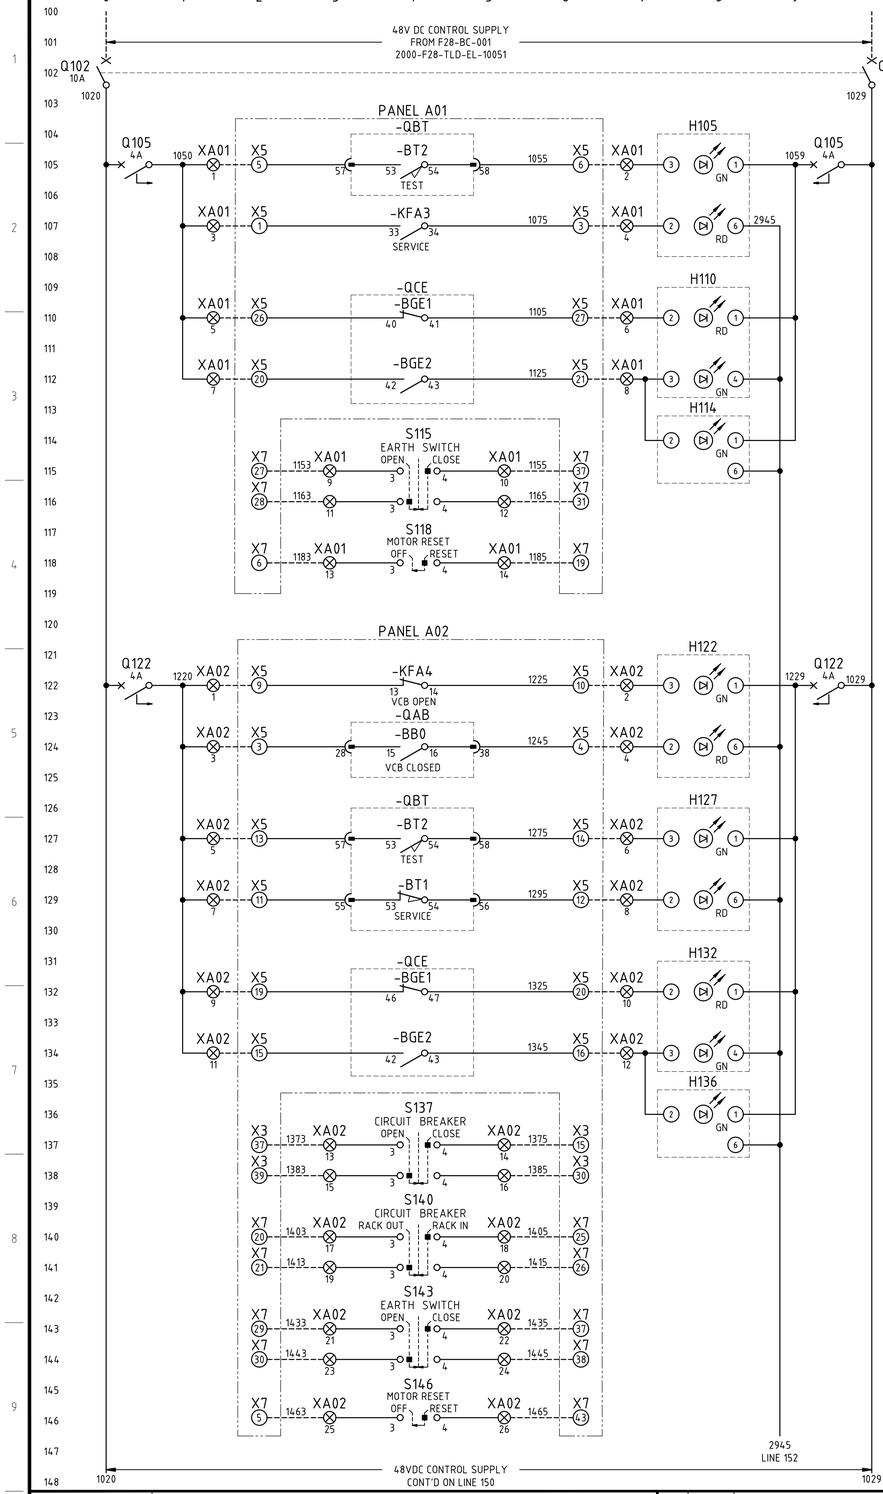


PANEL A01
BUS VT & EARTH SWITCH
2000-EL003-F16-10001

VT RACKED OUT INDICATION

VT RACKED IN INDICATION

EARTH SWITCH OPEN INDICATION

EARTH SWITCH CLOSED INDICATION

EARTH SYMBOL INDICATION

CLOSE EARTH SWITCH COMMAND

OPEN EARTH SWITCH COMMAND

MOTOR RESET

PANEL A02
F28-MUF-402 FEEDER
2000-EL003-F16-10012

CIRCUIT BREAKER OPEN INDICATION

CIRCUIT BREAKER CLOSED INDICATION

CIRCUIT BREAKER RACKED OUT INDICATION

CIRCUIT BREAKER RACKED IN INDICATION

EARTH SWITCH OPEN INDICATION

EARTH SWITCH CLOSED INDICATION

EARTH SYMBOL INDICATION

CLOSE CIRCUIT BREAKER COMMAND

OPEN CIRCUIT BREAKER COMMAND


RACK IN CIRCUIT BREAKER COMMAND

RACK OUT CIRCUIT BREAKER COMMAND

CLOSE EARTH SWITCH COMMAND

OPEN EARTH SWITCH COMMAND

MOTOR RESET

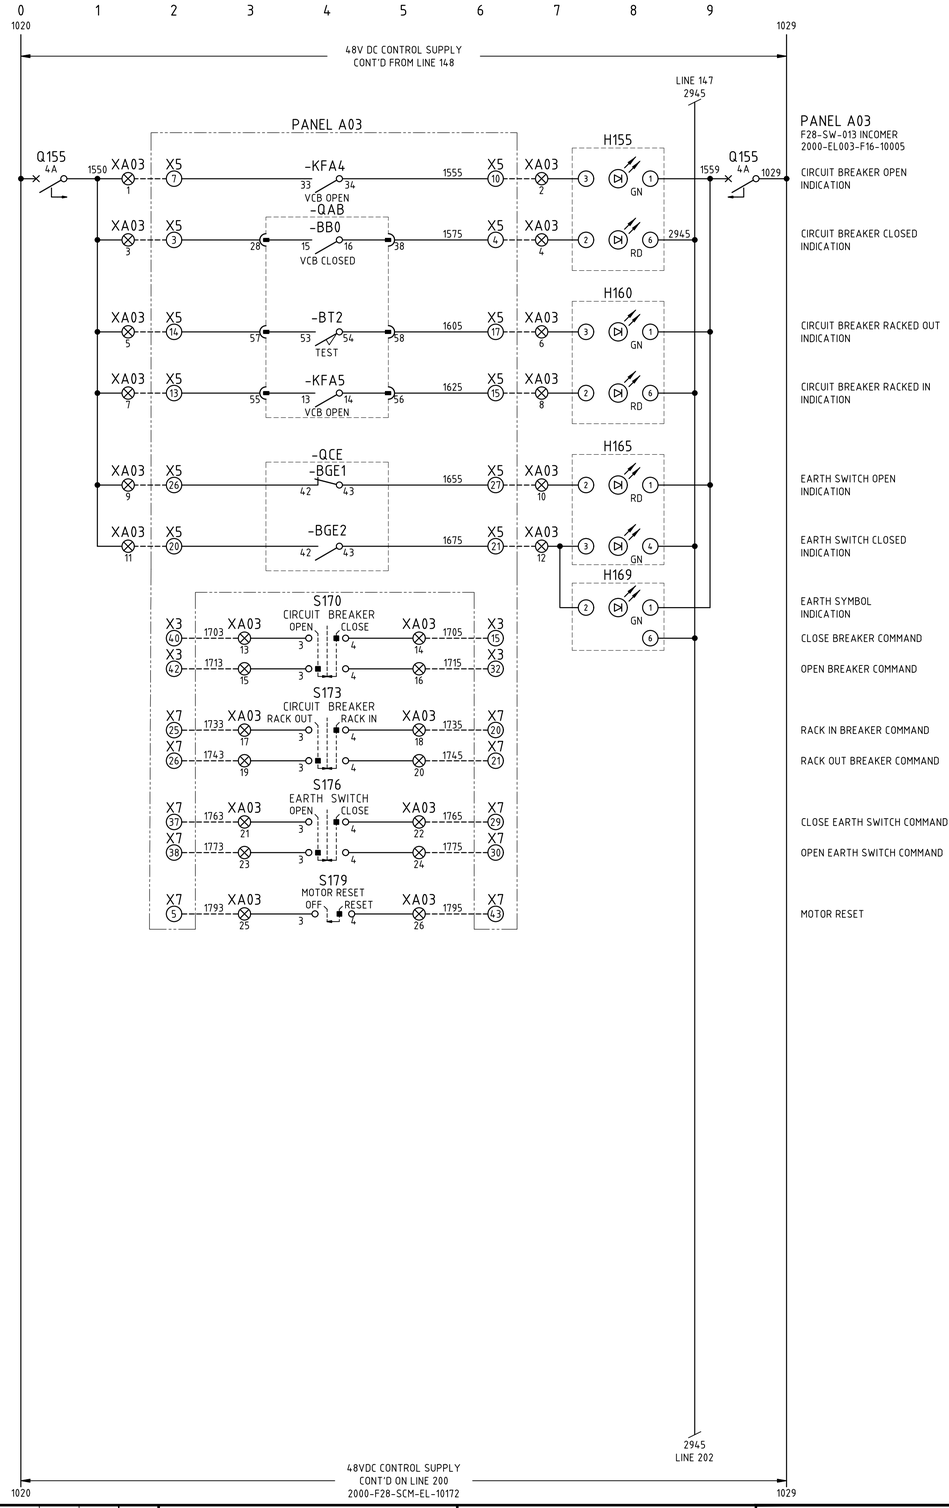

PANEL A03
F28-SW-013 INCOMER
2000-EL003-F16-10005

CIRCUIT BREAKER OPEN INDICATION

CIRCUIT BREAKER CLOSED INDICATION

CIRCUIT BREAKER RACKED OUT INDICATION

CIRCUIT BREAKER RACKED IN INDICATION

EARTH SWITCH OPEN INDICATION

EARTH SWITCH CLOSED INDICATION

EARTH SYMBOL INDICATION

CLOSE BREAKER COMMAND

OPEN BREAKER COMMAND

RACK IN BREAKER COMMAND

RACK OUT BREAKER COMMAND

CLOSE EARTH SWITCH COMMAND

OPEN EARTH SWITCH COMMAND

MOTOR RESET

NOTES

1. WIRE NUMBER FERRULES ON TERMINAL STRIP SHALL BE PREFIXED WITH EQUIPMENT NUMBER e.g. FxxPPxxx-1200, UNLESS OTHERWISE NOTED.
2. EACH WIRE SHALL BE IDENTIFIED AT BOTH ENDS WITH FERRULES.

LEGEND

- RSP TERMINAL
- HV SWITCHBOARD TERMINAL
- DEVICE TERMINAL

DRG No.	REFERENCES
2000-F28-DRG-EL-10053	F28SW013-LCS ULTRA FINE GRINDING 2/3 11kV SWBD REMOTE SWITCHING PANEL LAYOUT
2000-F28-TER-EL-10171	F28SW013-LCS ULTRA FINE GRINDING 2/3 11kV SWBD REMOTE SWITCHING PANEL TERMINATION DIAG. SH 1-4
2000-F28-SCM-EL-10171	F28SW013-LCS ULTRA FINE GRINDING 2/3 11kV SWBD REMOTE SWITCHING PANEL SCHEMATIC DIAG. SHEET 1
2000-F28-SLD-EL-10001	F28-SW-013 ULTRA FINE GRINDING 2/3 11kV SWBD SINGLE LINE DIAGRAM SHEET 1-3
2000-F00-STD-EL-10001	GENERAL NOTES AND STANDARD DRAWINGS INDEX

REV	DATE	DESCRIPTION	DRAW	CHECK	DESIGN	TECH APP	PROJ APP
2	02OCT26	KCGM GROWTH PROJECT - SP1 AS-BUILT					
1	08SEP25	FAT REDLINES INCORPORATED					
0	14NOV24	APPROVED FOR CONSTRUCTION					

NORTHERN STAR RESOURCES LIMITED

PRIMERO
primero.com.au | DESIGN | CONSTRUCT | OPERATE

PRIMERO PROJECT NUMBER: 23517

INFORMATION AND REPRESENTATIONS ON THIS DRAWING ARE THE INTELLECTUAL PROPERTY OF PRIMERO UNLESS SPECIFICALLY IDENTIFIED OTHERWISE. ALL RIGHTS INCLUDING USE RESERVED

PROJECT: NORTHERN STAR RESOURCES LTD
KCGM GROWTH PROJECT

TITLE: ULTRA FINE GRINDING 2/3 - F28SW013-LCS
11kV SWITCHBOARD REMOTE SWITCHING PANEL
SCHEMATIC DIAGRAM SHEET 1

SHEET	SCALE	DRG No.	REVISION
A1	NONE	2000-F28-SCM-EL-10171	2

O:\CAD PROJECTS\235 NORTHERN STAR RESOURCES LTD\23517 KCGM GROWTH PROJECT\03 DELIVERABLES\ELV\F28 - ULTRAFINE GRINDING 2 & 3\2000-F28-SCM-EL-10171.DWG 25SEP26 1:50PM ROBINLAW