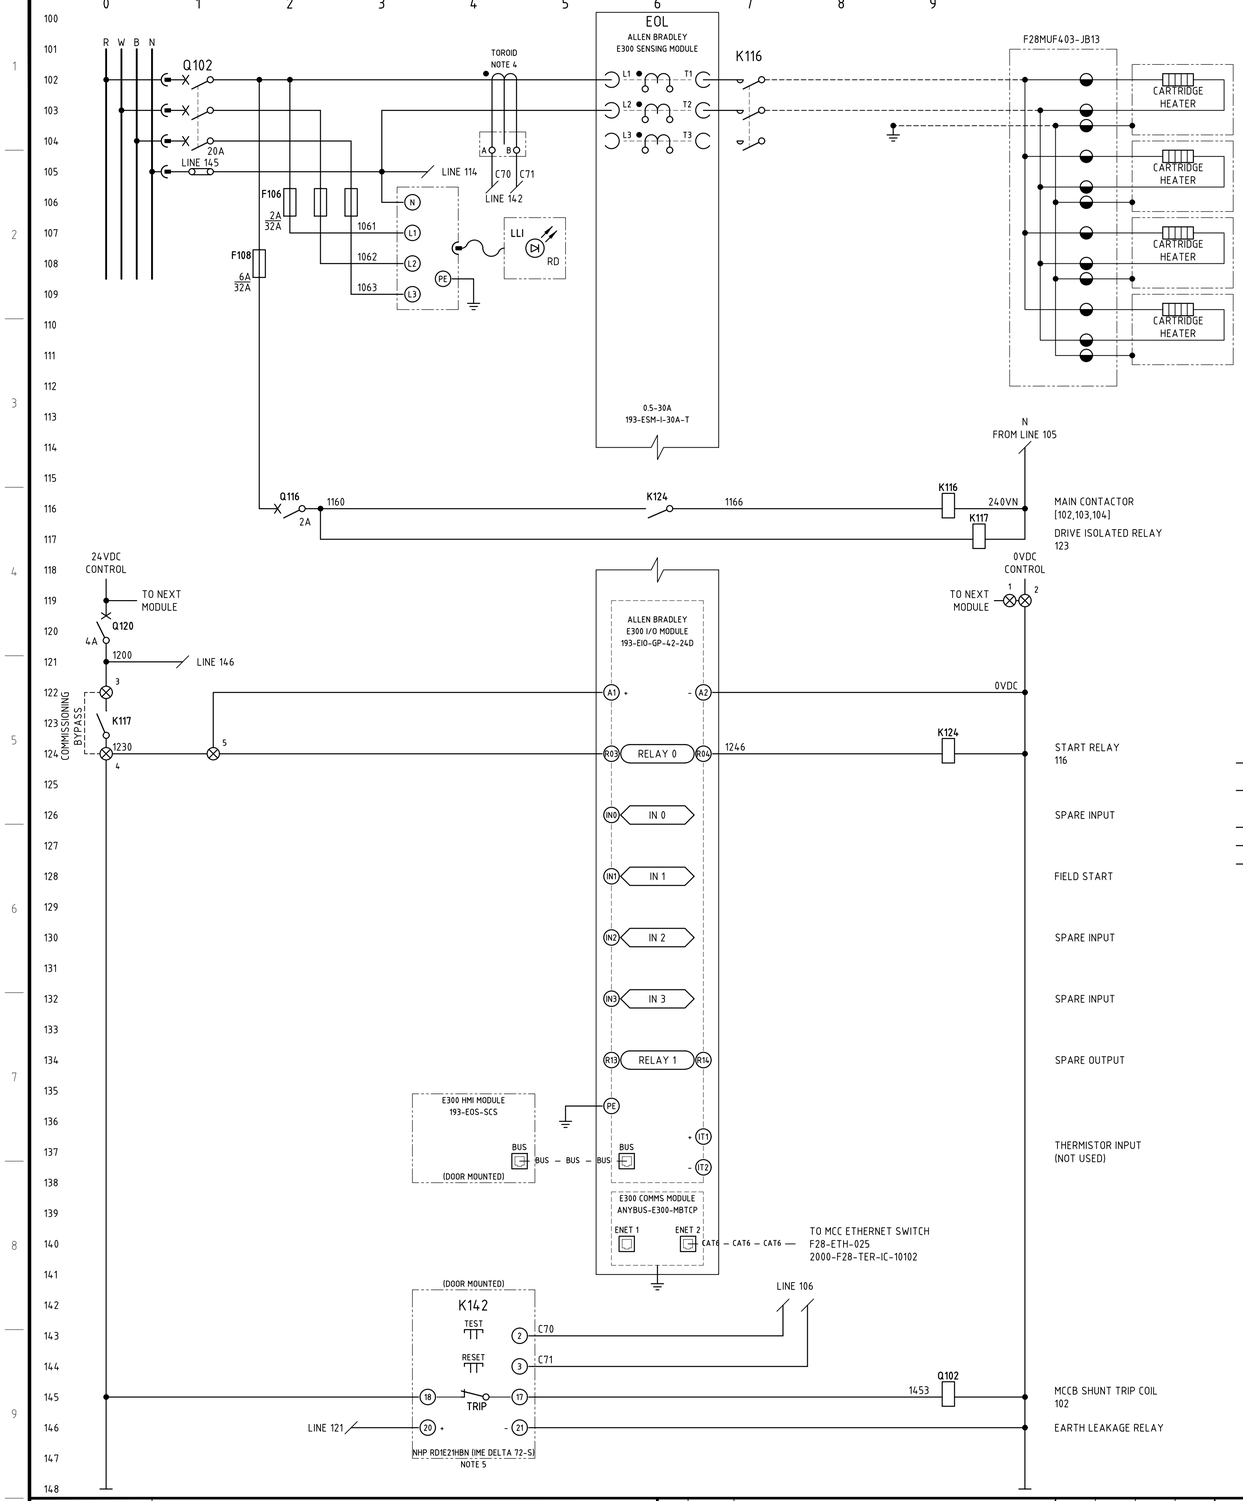


F28-HT-484

UFG MILL 3
BEARING OLS
HEATERS
2.4 kW


NOTES

1. TERMINALS ON TERMINAL STRIPS ABOVE 50VAC SHALL HAVE A SEPARATE PERSPEX SHROUD AND SHALL BE LABELLED "DANGER xxxVAC".
2. WIRE NUMBER FERRULES ON TERMINAL STRIP SHALL BE PREFIXED WITH EQUIPMENT NUMBER e.g. F28HT484-1200, UNLESS OTHERWISE NOTED.
3. EACH WIRE SHALL BE IDENTIFIED AT BOTH ENDS WITH FERRULES.
4. NHP TDGB2
   IN:70A IΔN MIN:0.03A TOROID TO SUIT CABLE DIAMETER.
5. EARTH LEAKAGE RELAY (ELV) USER INTERFACE TO BE MOUNTED ON MCC MODULE DOOR. RELAY ENERGISED (NORMALLY CLOSED CONTACT OPEN) IN NORMAL OPERATION.

LEGEND

- 00/01/00 — DCS DIGITAL INPUT
- 00/02/00 — DCS DIGITAL OUTPUT
- ⊗ — MCC TERMINAL
- ◕ — VSD TERMINAL
- ◒ — FIELD TERMINAL
- ◑ — DCS OR I/O TERMINAL
- ◧ — MARSHALLING TERMINAL
- (x) — DEVICE TERMINAL
- ⊗cc — INDICATION LAMP, cc = COLOUR

TERMINATION LEGEND

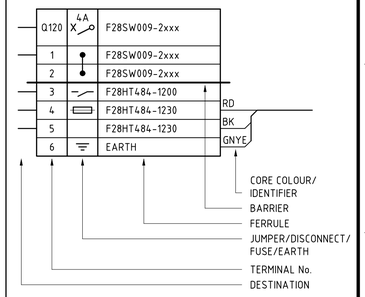

DRG No.	REFERENCES
2000-F28-SLD-EL-10201	F28-SW-009 415V MCC SINGLE LINE DIAGRAM SHEET 1
2000-F00-STD-EL-10001	GENERAL NOTES AND STANDARD DRAWINGS INDEX

REV	DATE	DESCRIPTION	DRAW	CHECK	DESIGN	TECH APP	PROJ APP
2	02OCT26	KCGM GROWTH PROJECT - SP1 AS-BUILT					
1	11SEP25	FAT REDLINES INCORPORATED					
0	25SEP24	APPROVED FOR CONSTRUCTION					

NORTHERN STAR RESOURCES LIMITED

PRIMERO
primero.com.au | DESIGN | CONSTRUCT | OPERATE

PRIMERO PROJECT NUMBER: 23517

INFORMATION AND REPRESENTATIONS ON THIS DRAWING ARE THE INTELLECTUAL PROPERTY OF PRIMERO UNLESS SPECIFICALLY IDENTIFIED OTHERWISE. ALL RIGHTS INCLUDING USE RESERVED

PROJECT: NORTHERN STAR RESOURCES LTD
KCGM GROWTH PROJECT

TITLE: ULTRA FINE GRINDING 2/3 - F28-SW-009
F28-HT-484 UFG MILL 3 BEARING OLS HEATER
SCHEMATIC AND TERMINATION DIAGRAM

SHEET	SCALE	DRG No.	REVISION
A1	NONE	2000-F28-SCM-EL-10218	2

O:\CAD PROJECTS\235 NORTHERN STAR RESOURCES LTD\23517 KCGM GROWTH PROJECT\03 DELIVERABLES\ELV\F28 - ULTRAFINE GRINDING 2 & 3\2000-F28-SCM-EL-10218.DWG 25SEP26 2:48PM ROBIN.LAW