


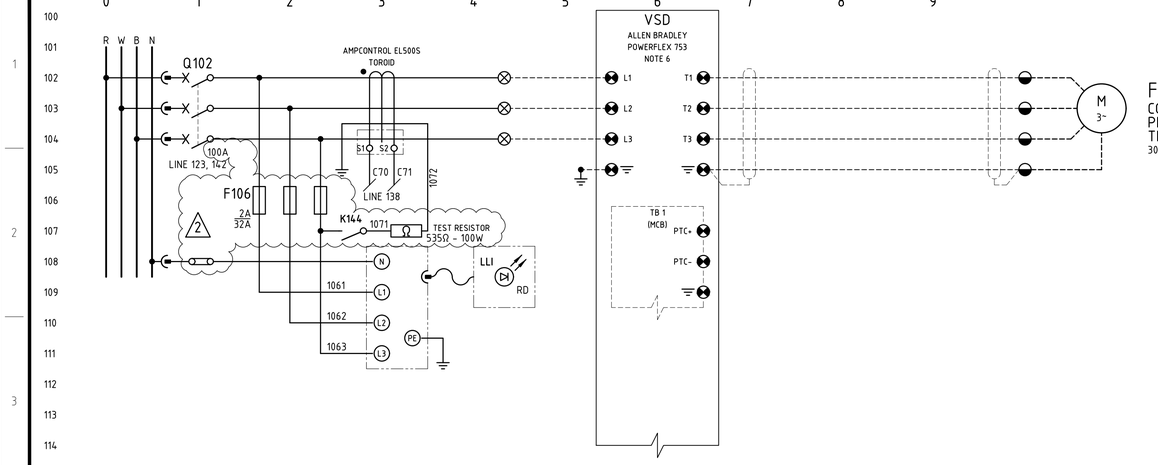


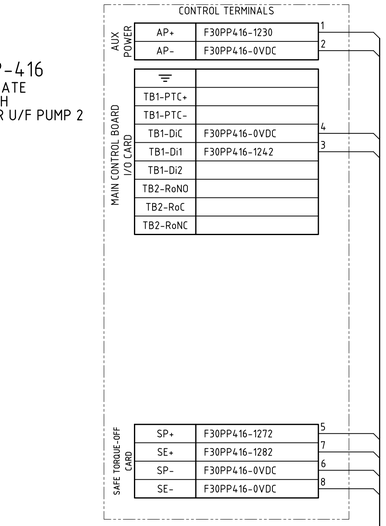

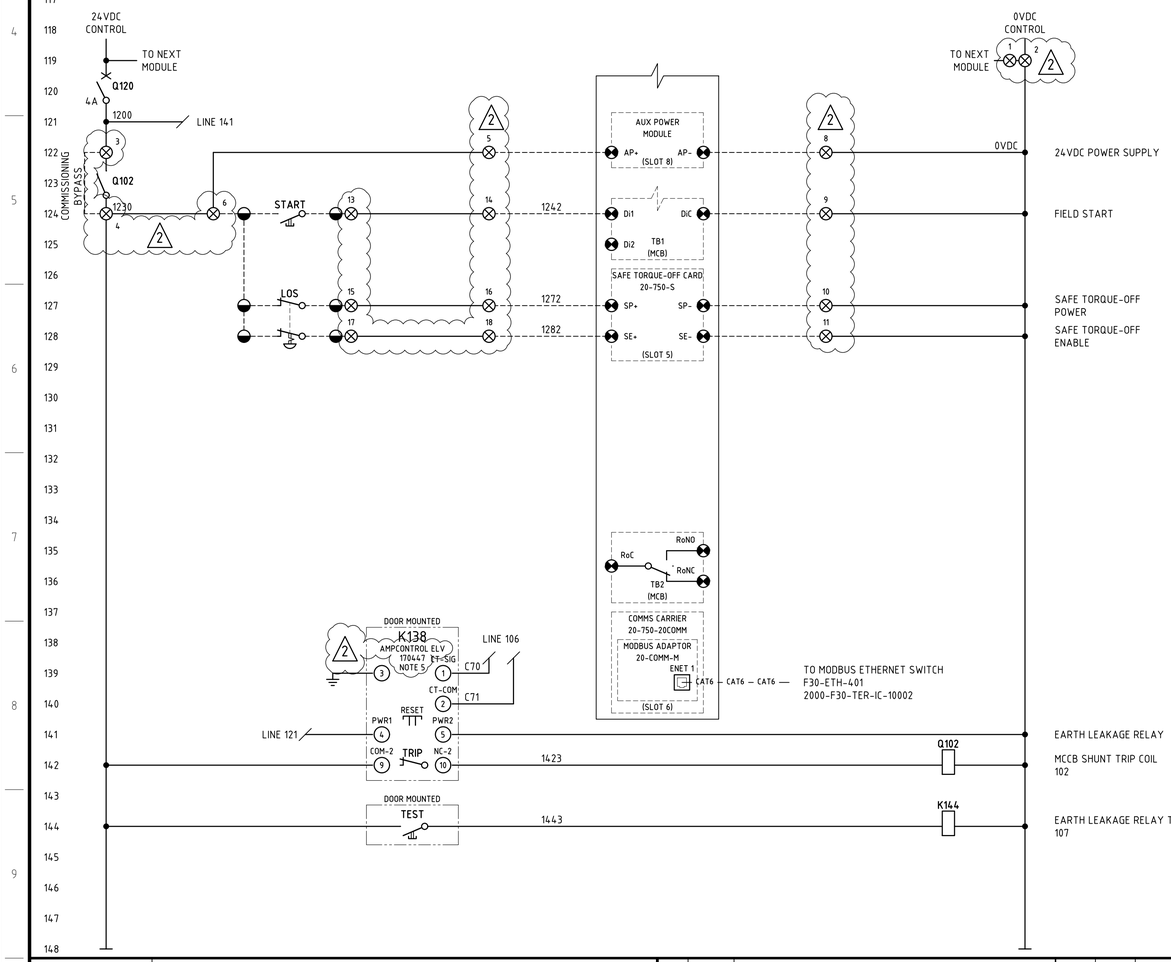

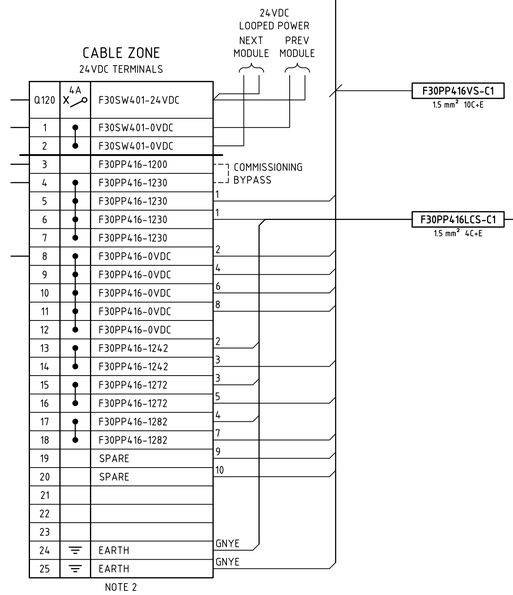


NOTES

1. TERMINALS ON TERMINAL STRIPS ABOVE 50VAC SHALL HAVE A SEPARATE PERSPEX SHROUD AND SHALL BE LABELLED "DANGER xxxVAC".
2. WIRE NUMBER FERRULES ON TERMINAL STRIP SHALL BE PREFIXED WITH EQUIPMENT NUMBER e.g. F30PP416-1200, UNLESS OTHERWISE NOTED.
3. EACH WIRE SHALL BE IDENTIFIED AT BOTH ENDS WITH FERRULES.
4. AMPCONTROL 10164.9
   100/1A TOROID.
5. EARTH LEAKAGE RELAY (ELV) USER INTERFACE TO BE MOUNTED ON MCC MODULE DOOR. RELAY ENERGISED (NORMALLY CLOSED CONTACT OPEN) IN NORMAL OPERATION.
6. VSD SHALL BE SIZE FRAME 2 AND ABOVE.

LEGEND

- 00/01/00 — DCS DIGITAL INPUT
- 00/02/00 — DCS DIGITAL OUTPUT
- MCC TERMINAL
- VSD TERMINAL
- FIELD TERMINAL
- DCS OR I/O TERMINAL
- MARSHALLING TERMINAL
- DEVICE TERMINAL
- INDICATION LAMP (cc = COLOUR)

TERMINATION LEGEND

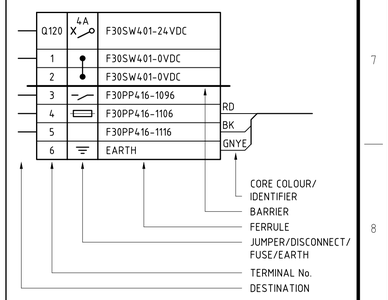

DRG No.	REFERENCES
2000-F30-SLD-EL-10301	SUBSTATION NO. 68 MCC F30-SW-401 SINGLE LINE DIAGRAM SHEET 1
2000-F00-STD-EL-10001	GENERAL NOTES AND STANDARD DRAWING INDEX

REV	DATE	DESCRIPTION	DRAW	CHECK	DESIGN	TECH APP	PROJ APP
2	28OCT25	FAT REDLINES INCORPORATED					
1	07MAR25	MCC SUPPLY LOCATION UPDATED					
0	04NOV24	APPROVED FOR CONSTRUCTION					

NORTHERN STAR RESOURCES LIMITED

PRIMERO
primero.com.au | DESIGN | CONSTRUCT | OPERATE

PRIMERO PROJECT NUMBER: 23517

INFORMATION AND REPRESENTATIONS ON THIS DRAWING ARE THE INTELLECTUAL PROPERTY OF PRIMERO UNLESS SPECIFICALLY IDENTIFIED OTHERWISE. ALL RIGHTS INCLUDING USE RESERVED

PROJECT: NORTHERN STAR RESOURCES LTD
KCGM GROWTH PROJECT

TITLE: FIMISTON PLANT - SUBSTATION NO. 68 MCC F30-SW-401
F30-PP-416 CONC. PRE-LEACH THICKENER U/F PUMP 2
SCHEMATIC AND TERMINATION DIAGRAM

SHEET	SCALE	DRG No.	REVISION
A1	NONE	2000-F30-SCM-EL-10002	2

O:\CAD PROJECTS\235 NORTHERN STAR RESOURCES LTD\23517 KCGM GROWTH PROJECT\03 DELIVERABLES\ELV\F30 - CIL\2_3 & CONCENTRATE THICKENING\2000-F30-SCM-EL-10002.DWG 19NOV25 11:45AM HOTSEAT04