
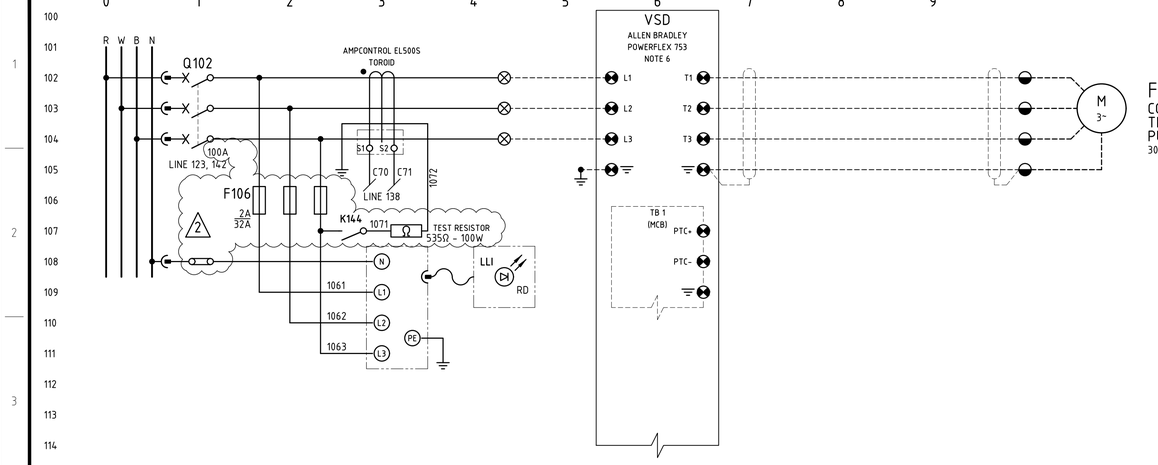


F30-PP-418
CONCENTRATE THICKENER U/F PUMP 2
30 kW

VSD
CONTROL TERMINALS

AUX POWER	AP+	F30PP418-1230	1
	AP-	F30PP418-0VDC	2
MAIN CONTROL BOARD I/O CARD	⏚		
	TB1-PTC+		
	TB1-PTC-		
	TB1-DiC	F30PP418-0VDC	4
	TB1-Di1	F30PP418-1242	3
	TB1-Di2		
	TB2-RoNO		
	TB2-RoC		
	TB2-RoNC		
SAFE TORQUE-OFF CARD	SP+	F30PP418-1272	5
	SE+	F30PP418-1282	7
	SP-	F30PP418-0VDC	6
	SE-	F30PP418-0VDC	8

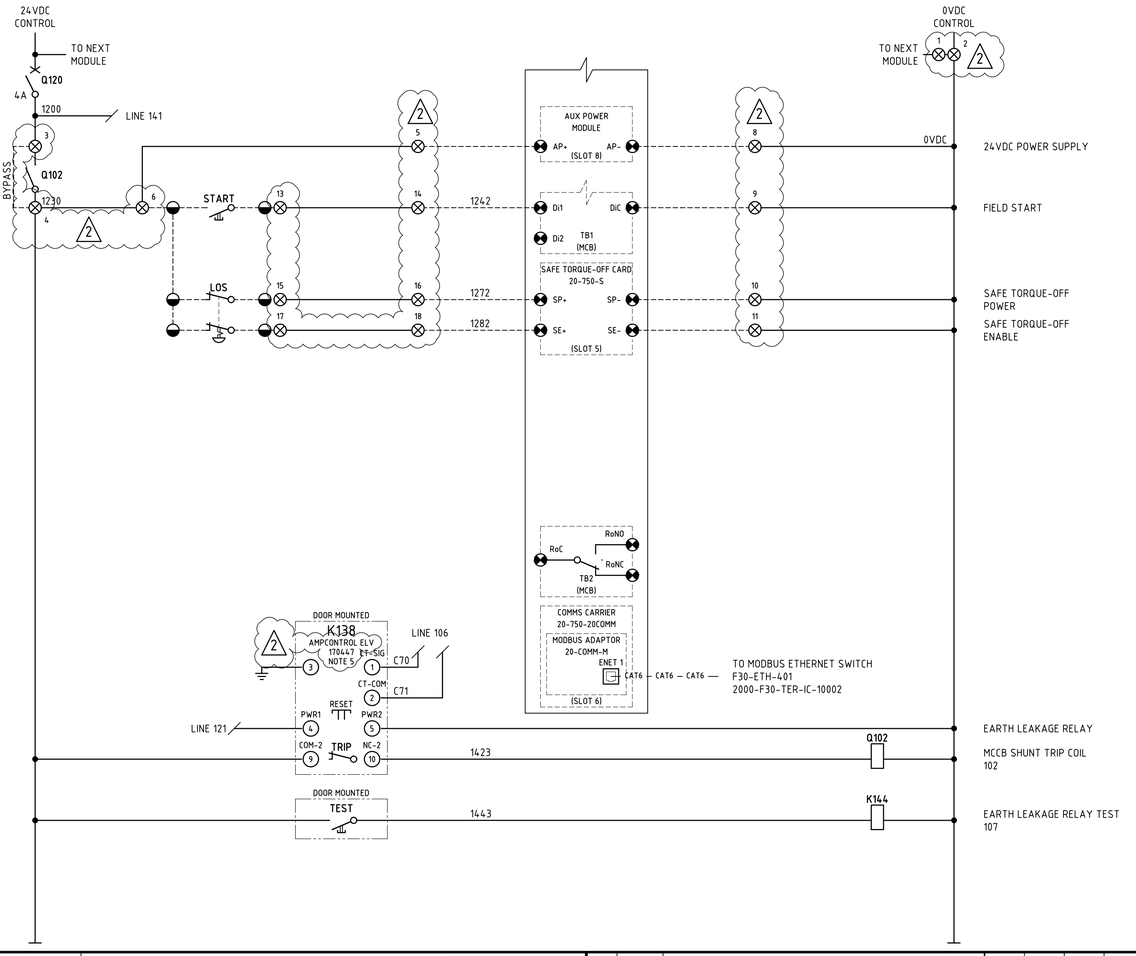

CABLE ZONE
24VDC TERMINALS

Q120	4A	F30SW401-24VDC	
1		F30SW401-0VDC	
2		F30SW401-0VDC	
3		F30PP418-1200	
4		F30PP418-1230	
5		F30PP418-1230	
6		F30PP418-1230	
7		F30PP418-1230	
8		F30PP418-0VDC	
9		F30PP418-0VDC	
10		F30PP418-0VDC	
11		F30PP418-0VDC	
12		F30PP418-0VDC	
13		F30PP418-1242	
14		F30PP418-1242	
15		F30PP418-1272	
16		F30PP418-1272	
17		F30PP418-1282	
18		F30PP418-1282	
19		SPARE	
20		SPARE	
21			
22			
23			
24	⏚	EARTH	GNYE
25	⏚	EARTH	GNYE

NOTE 2

24VDC LOOPED POWER
NEXT MODULE PREV MODULE
COMMISSIONING BYPASS

F30PP418VS-C1
1.5 mm² 10C+E

F30PP418LCS-C1
1.5 mm² 4C+E

F30PP418-LCS
LOCAL CONTROL STATION
START
LOS
GNYE


NOTES

1. TERMINALS ON TERMINAL STRIPS ABOVE 50VAC SHALL HAVE A SEPARATE PERSPEX SHROUD AND SHALL BE LABELLED "DANGER xxxVAC".
2. WIRE NUMBER FERRULES ON TERMINAL STRIP SHALL BE PREFIXED WITH EQUIPMENT NUMBER e.g. F30PP418-1200, UNLESS OTHERWISE NOTED.
3. EACH WIRE SHALL BE IDENTIFIED AT BOTH ENDS WITH FERRULES.
4. AMPCONTROL 101649 100/1A TOROID.
5. EARTH LEAKAGE RELAY (ELV) USER INTERFACE TO BE MOUNTED ON MCC MODULE DOOR. RELAY ENERGISED (NORMALLY CLOSED CONTACT OPEN) IN NORMAL OPERATION.
6. VSD SHALL BE SIZE FRAME 2 AND ABOVE.

LEGEND

- 00/01/00 — DCS DIGITAL INPUT
- 00/02/00 — DCS DIGITAL OUTPUT
- MCC TERMINAL
- VSD TERMINAL
- FIELD TERMINAL
- DCS OR I/O TERMINAL
- MARSHALLING TERMINAL
- DEVICE TERMINAL
- INDICATION LAMP (cc = COLOUR)

TERMINATION LEGEND

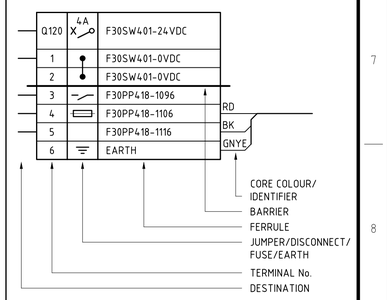

DRG No.	REFERENCES
2000-F30-SLD-EL-10301	SUBSTATION NO. 68 MCC F30-SW-401 SINGLE LINE DIAGRAM SHEET 1
2000-F00-STD-EL-10001	GENERAL NOTES AND STANDARD DRAWING INDEX

REV	DATE	DESCRIPTION	DRAW	CHECK	DESIGN	TECH APP	PROJ APP
2	28OCT25	FAT REDLINES INCORPORATED					
1	07MAR25	MCC SUPPLY LOCATION UPDATED					
0	04NOV24	APPROVED FOR CONSTRUCTION					

NORTHERN STAR RESOURCES LIMITED

PRIMERO
primero.com.au | DESIGN | CONSTRUCT | OPERATE

PRIMERO PROJECT NUMBER: 23517

INFORMATION AND REPRESENTATIONS ON THIS DRAWING ARE THE INTELLECTUAL PROPERTY OF PRIMERO UNLESS SPECIFICALLY IDENTIFIED OTHERWISE. ALL RIGHTS INCLUDING USE RESERVED

PROJECT: NORTHERN STAR RESOURCES LTD
KCGM GROWTH PROJECT

TITLE: FIMISTON PLANT - SUBSTATION NO. 68 MCC F30-SW-401
F30-PP-418 CONCENTRATE THICKENER UNDERFLOW PUMP 2
SCHEMATIC AND TERMINATION DIAGRAM

SHEET	SCALE	DRG No.	REVISION
A1	NONE	2000-F30-SCM-EL-10018	2

O:\CAD PROJECTS\23S NORTHERN STAR RESOURCES LTD\23517 KCGM GROWTH PROJECT\03 DELIVERABLES\ELV\F30 - CIL2_3 & CONCENTRATE THICKENING\2000-F30-SCM-EL-10018.DWG 19NOV25 11:45AM HOTSEAT04