


240VAC UPS SUPPLY
FROM 30-DB-62
2000-F30-TLD-EL-10001

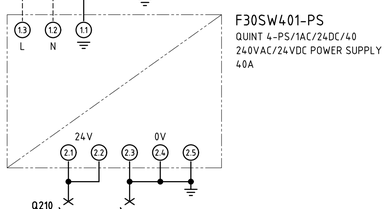

F30SW401-PS
QUINT 4-PS/1AC/24DC/40
240VAC/24VDC POWER SUPPLY
40A

Q210
40A

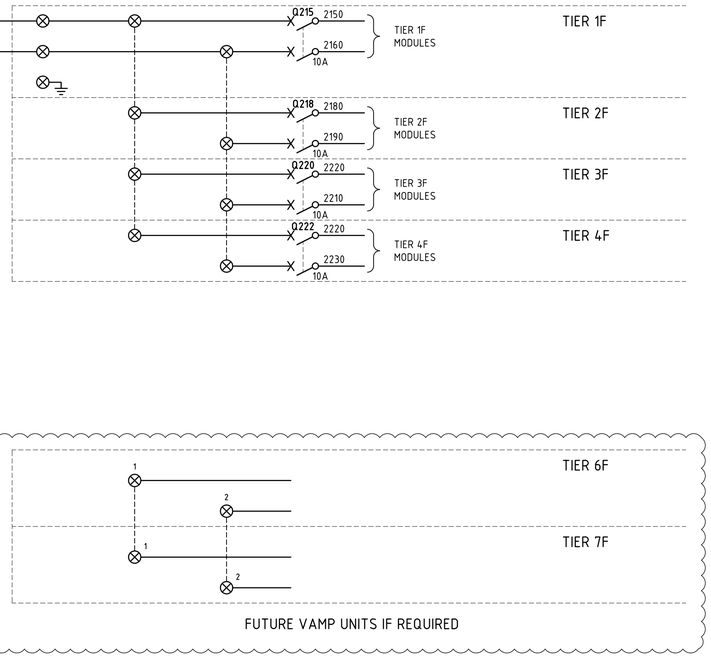

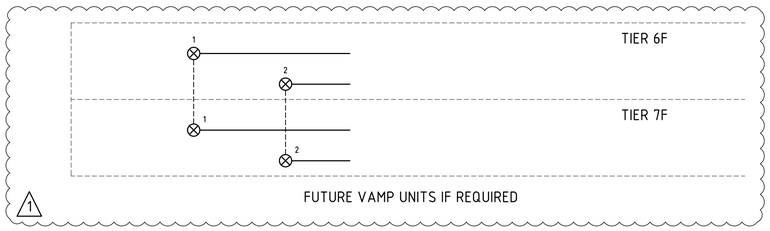


NOTES

1. TERMINALS ON TERMINAL STRIPS ABOVE 50VAC SHALL HAVE A SEPARATE PERSPEX SHROUD AND SHALL BE LABELLED "DANGER xxxVAC".
2. WIRE NUMBER FERRULES ON TERMINAL STRIP SHALL BE PREFIXED WITH EQUIPMENT NUMBER e.g. F30SW401PS-1200, UNLESS OTHERWISE NOTED.
3. EACH WIRE SHALL BE IDENTIFIED AT BOTH ENDS WITH FERRULES.

LEGEND



TERMINATION LEGEND

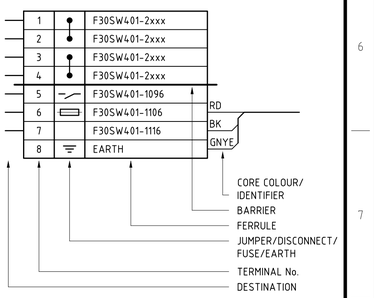

DRG No.	REFERENCES
2000-F30-SLD-EL-10301	415V MCC F30-SW-401 SINGLE LINE DIAGRAM SHEET 1
2000-F30-TLD-EL-10001	240V INSTRUMENT DISTRIBUTION BOARD NO. 62 POWER SCHEMATIC
2000-F00-STD-EL-10001	GENERAL NOTES AND STANDARD DRAWINGS INDEX

REV	DATE	DESCRIPTION	DRAW	CHECK	DESIGN	TECH APP	PROJ APP
1	28OCT25	FAT REDLINES INCORPORATED					
0	07APR25	APPROVED FOR CONSTRUCTION					

NORTHERN STAR RESOURCES LIMITED

PRIMERO
primero.com.au | DESIGN | CONSTRUCT | OPERATE

PRIMERO PROJECT NUMBER: 23517

INFORMATION AND REPRESENTATIONS ON THIS DRAWING ARE THE INTELLECTUAL PROPERTY OF PRIMERO UNLESS SPECIFICALLY IDENTIFIED OTHERWISE. ALL RIGHTS INCLUDING USE RESERVED

PROJECT: NORTHERN STAR RESOURCES LTD
KCGM GROWTH PROJECT

TITLE: FIMISTON PLANT - SUBSTATION NO. 68 MCC F30-SW-401
F30-SW-401 24VDC DISTRIBUTION
SCHEMATIC DIAGRAM

SHEET	SCALE	DRG No.	REVISION
A1	NONE	2000-F30-SCM-EL-10034	1

O:\CAD PROJECTS\235 NORTHERN STAR RESOURCES LTD\23517 KCGM GROWTH PROJECT\03 DELIVERABLES\EL\F30 - CUL2_3 & CONCENTRATE THICKENING\2000-F30-SCM-EL-10034.DWG 19NOV25 11:45AM HOTSEAT04