


	DRIVE No.	NAME	MODULE No.	FERRULE PREFIX	DCS START OUTPUT	DCS STOP INPUT	DCS START INPUT	DCS FAULT INPUT	DCS RUN INPUT
	30-SC-63	CIL 3 STRIPPED CARBON SIZING SCREEN		SC63	%Z055129	%Z052423	%Z052424	%Z052425	%Z052426
SPARE	65-SC-65	CARBON RECOVERY SCREEN	2R/6	SC65	%Z055109	%Z052201	%Z052202	%Z052203	%Z052204

	DRIVE No.	DB No	DCS PANEL	24V CB No
	30-SC-63	30-PC-62	DF	A11
SPARE	65-SC-65	30-PC-62	DF	A14

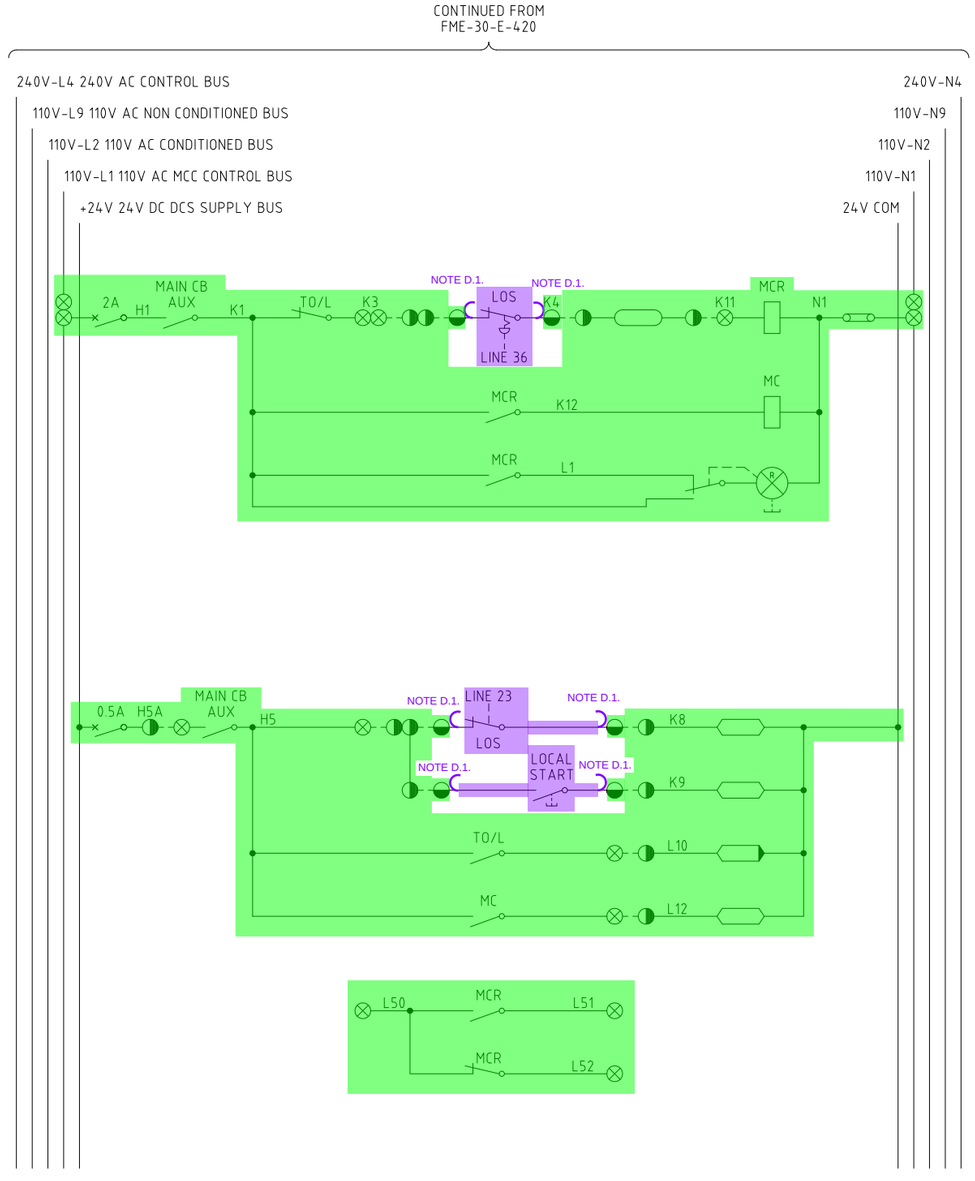

KCGM GROWTH PROJECT DEMOLITION NOTES

D.1. MOTOR AND THERMISTOR CABLES TO BE DISCONNECTED AND MADE SAFE.

LEGEND

- STAGE 1 - NEW
- STAGE 1 - REMOVE
- STAGE 1 - DECOMMISSIONED (OTHERS)
- STAGE 2 - NEW
- STAGE 2 - REMOVE
- STAGE 2 - DECOMMISSIONED (OTHERS)

	110V-L1	•
	110V-L1	•
	110V-N1	•
	110V-N1	•
	K3	•
	K3	•
	K11	
	H5	
	H5A	
	L10	
	L12	
	L50	
	L51	
	L52	

MCC TERMINAL ARRANGEMENT

REV	DATE	DESCRIPTION	CHECK	TECH APP
0	12/11/25	APPROVED FOR CONSTRUCTION	[redacted]	MB/DM

KCGM GROWTH PROJECT

DRAWING NO. 2000-F30-SCM-EL-10055

LEGEND

TERMINALS
- MOTOR CONTROL CENTRE (MCC)
- FIELD
- PROCESS CONTROL CUBICLE (30-PC-63)
- LINE CONDITIONER
- VARIABLE SPEED DRIVE
- DISTRIBUTION BOARD

DIGITAL FUNCTIONS
- DCS INPUT
- DCS INPUT WITH ALARM FUNCTION
- DCS OUTPUT

ANALOGUE FUNCTION
- 4-20mA INPUT
- 4-20mA OUTPUT

ANCILLARY EQUIPMENT
- CONTACT - NORMALLY CLOSED
- CONTACT - NORMALLY OPEN
- LIMIT SWITCH
- CONTACTOR
- PUSH BUTTON
- LOS (LOCK OFF STOP)
- RELAY
- LINK
- CIRCUIT BREAKER
- THERMISTOR
- INDICATION LAMP R RED, G GREEN, A AMBER
- SIREN
- HORN

NOTES

1. ALL WIRES EXCEPT CONTROL SUPPLIES & THOSE WITHIN FORM 4 MODULES SHALL BE FERRULED WITH PREFIX LISTED IN ABOVE TABLE.

CLIENT APPROVED for CONSTRUCTION

DATE: 24/03/95 SIGNED: S. ELANGSINGHE

DRAWING No.	REFERENCE DRAWINGS
FME-30-E-407	415V MCC 30-SW-63 SINGLE LINE DIAGRAM SHT 2
FME-30-E-408	415V MCC 30-SW-63 SINGLE LINE DIAGRAM SHT 3

COPYRIGHT ©
This drawing remains the property of MINPROC ENGINEERS LIMITED and may not be copied in any way without prior written approval from this company.

MINPROC ENGINEERS LIMITED
A.C.N. 008 992 694
22, STIRLING HIGHWAY, NEDLANDS WA 6009
PHONE (09) 347 4777

No.	BY	DATE	REVISION	CHECKED	APPROV
4	GS	8/2/96	AS BUILTS BY LYCOPODIUM		
3	AH	8/05/95	DCS ADDRESSES ADDED	J.A.M	P.F
2	KC	23/03/95	RE-APPROVED FOR CONSTRUCTION	J.A.M.	[redacted]
1	AH	28/02/95	APPROVED FOR CONSTRUCTION	J.A.M.	P.F.

		DATE
PROJECT APPR.	[redacted]	24/03/95
DESIGN APPR.	[redacted]	13/03/95
DESIGNED	[redacted]	13/03/95
CHECKED	[redacted]	07/03/95
DRAWN	[redacted]	28/02/95

KALGOORLIE CONSOLIDATED GOLD MINES

SIZE A1 | SCALE N.T.S.

TITLE
FIMISTON EXPANSION 1994/95
CIL 3 AREA 415V MCC 30-SW-63
SCHEMATIC DIAGRAM SHEET 7

REV. No. 1 2 3 4

DRAWING No. 30\E\0427