

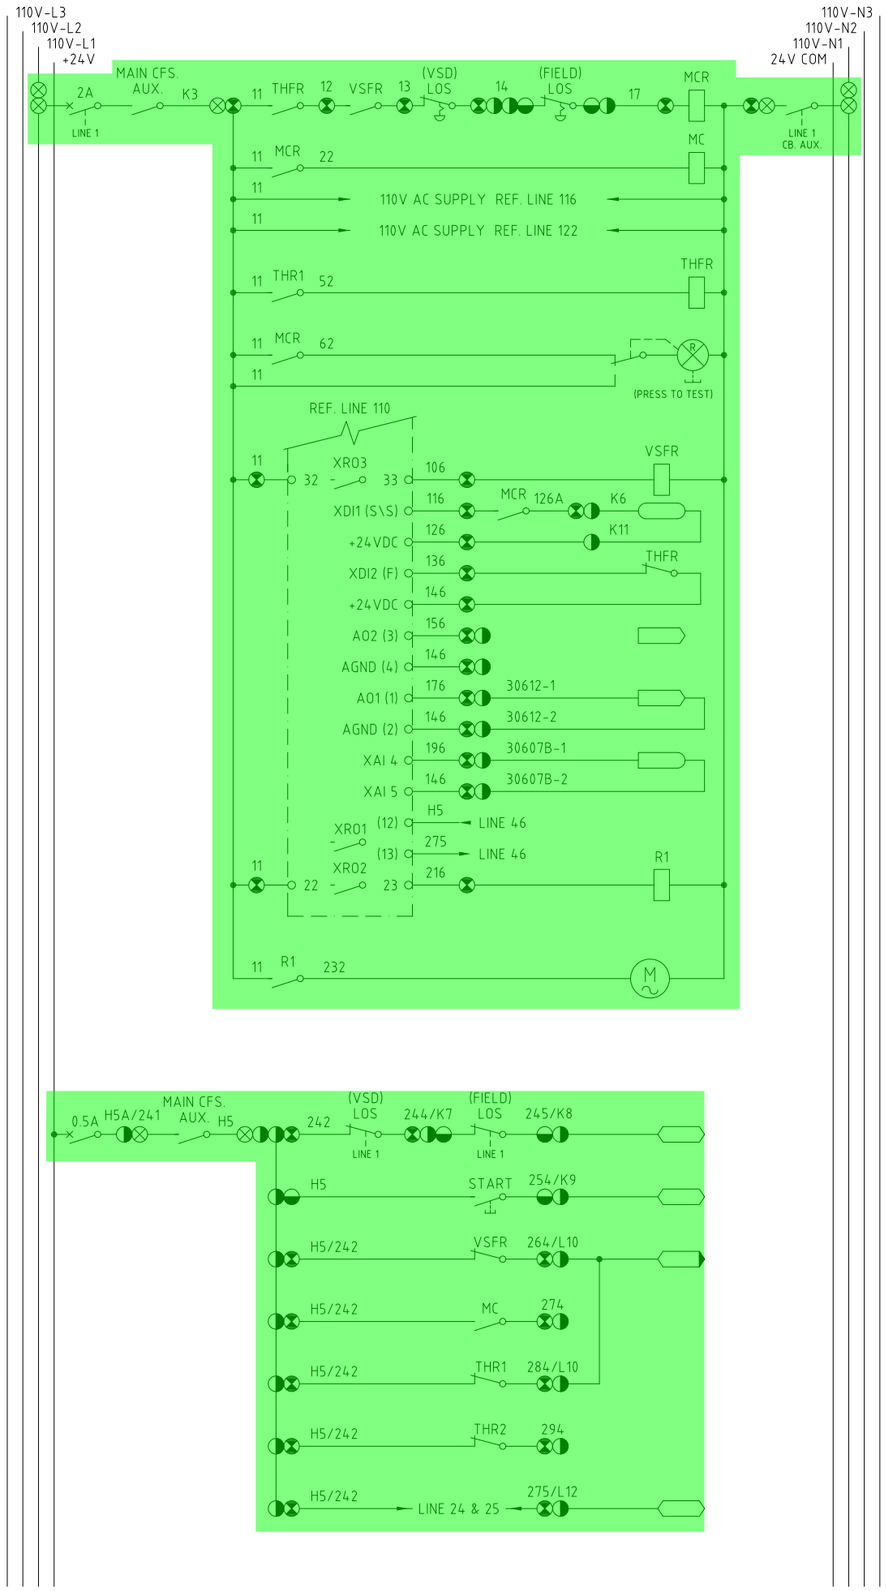


POWER LAYOUT

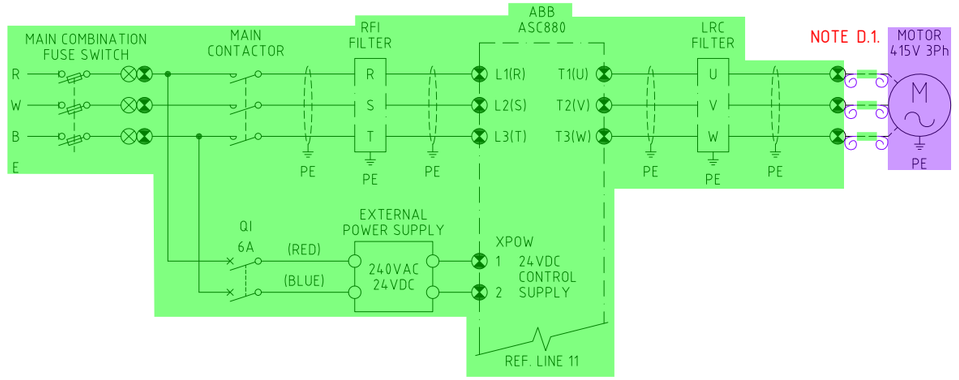

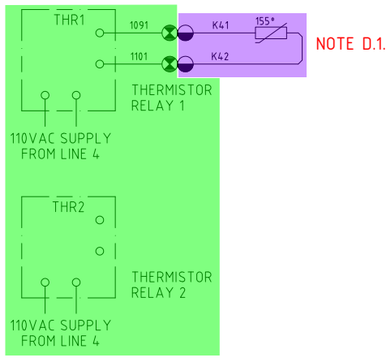

3

MAIN CONTACTOR RELAY	100	
	101	
MAIN CONTACTOR	102	
TO THERMISTOR RELAY 1 (TRIP)	103	
TO THERMISTOR RELAY 2 (ALARM)	104	
	105	
THERMISTOR FAULT RELAY	106	
	107	
VSD SUPPLY AVAILABLE	108	
	109	
	110	
	111	
VSD FAULT RELAY	112	
MAIN CONTACTOR RELAY	113	
	114	
THERMISTOR FAULT RELAY	115	
	116	
REMOTE SPEED INPUT (NOT CONNECTED)	117	
	118	
REMOTE CURRENT INPUT	119	
	120	
REMOTE SPEED OUTPUT	121	
	122	
	123	
	124	
COOLING FAN RELAY	125	
	126	
	127	
COOLING FAN		
STOP INPUT		
START INPUT		
VSD FAULT INPUT		

KCGM GROWTH PROJECT DEMOLITION NOTES

D.1. MOTOR AND THERMISTOR CABLES TO BE DISCONNECTED AND MADE SAFE.

LEGEND
- EXISTING
- NON-EXISTENT
- STAGE 1 - NEW
- STAGE 1 - REMOVE
- STAGE 1 - DECOMMISSIONED (OTHERS)
- STAGE 2 - NEW
- STAGE 2 - REMOVE
- STAGE 2 - DECOMMISSIONED (OTHERS)

KCGM GROWTH PROJECT

DRAWING NO. 2000-F30-SCM-EL-10058

REV	DATE	DESCRIPTION	CHECK	TECH APP
0	10/11/25	APPROVED FOR CONSTRUCTION	RF	MB/DM

SPARE

EQUIPMENT NUMBER	DESCRIPTION	MODULE NUMBER	FERRULE PREFIX	24V C/B NUMBER	DCS START OUTPUT	DCS STOP INPUT	DCS START INPUT	DCS VSD FAULT INPUT
30-PP-31A	FLOTATION TAILS THICKENER 2 U/FLOW PUMP "A"	1R3	PP31A	6/16	%Z013216	%Z013129	%Z013130	%Z013131
	SPARE 250A FEEDER							

RUN INPUT

EQUIPMENT NUMBER	DCS RUN INPUT	DCS REM SPEED ANALOG OUTPUT	DCS MTR AMPS ANALOG INPUT	VSD UNIT NUMBER						
30-PP-31A	%Z013132	25\E\1088	25\E\1088	30VS31A						

LEGEND

TERMINALS
- MOTOR CONTROL CENTRE (MCC)
- FIELD
- PROCESS CONTROL CUBICLE
- LINE CONDITIONER
- SOFT STARTER TERMINAL
- VARIABLE SPEED DRIVE
- DISTRIBUTION BOARD
- HV MOTOR CONTROL CENTRE
- MISC. ELECTRICAL DEVICE REFER NOTES FOR SPECIFIC DESC.

DIGITAL FUNCTIONS
- DCS INPUT
- DCS INPUT WITH ALARM FUNCTION
- DCS OUTPUT

ANALOGUE FUNCTION
- 4-20mA INPUT
- 4-20mA OUTPUT

ANCILLARY EQUIPMENT
- CIRCUIT BREAKER
- COMBINATION FUSE SWITCH
- ISOLATOR
- PUSH BUTTON
- LOS (LOCK OFF STOP)
- PULL WIRE SWITCH
- NORMALLY CLOSED CONTACT
- LIMIT SWITCH
- CONTACTOR CONTACT
- NORMALLY OPEN CONTACT
- TIMER CONTACT
- FUNCTION CONTACT
  - P - PRESSURE
  - T - TEMPERATURE
  - F - FLOW
  - L - FLOAT
- SIREN
- HORN
- RELAY
- LINK
- THERMISTOR
- INDICATION LAMP (R) R - RED, G - GREEN, A - AMBER

VOLTAGES ON CONTROL BUS
- +24V - 24V DC DCS SUPPLY BUS
- 110V-L1 - 110V AC MCC CONTROL BUS
- 110V-L2 - 110V AC CONDITIONED BUS
- 110V-L3 - 110V AC NON CONDITIONED BUS

NOTES

1. ALL WIRES EXCEPT CONTROL SUPPLIES & THOSE WITHIN FORM 4 MODULES SHALL BE FERRULED WITH PREFIX LISTED IN ABOVE TABLE.

MK	DATE	REVISION	BY	CKD	APP
3	07/11/22	ASBUILT	[redacted]	MB	[redacted]
2B	04/11/22	VSD REPLACED AS BUILT REVIEW			
2A	24/10/22	IFR - 30PP31A TOSHIBA VSD REPLACED WITH ABB VSD		RH	
1	2-11-07	DCS UPGRADE ALTERATIONS			
0	30-10-03	AS BUILT	[redacted]		

REFERENCE DRAWINGS

DWG NO.

PROJ. FILE #.

SCALE NTS

DRAWN [redacted] 30-10-03

DESIGNED

CHECKED

APPROVED

PROJ.APP

FIMISTON PLANT
FLOTATION AREA TAILS THICKENER
FLOTATION TAILS THICKENER 2 U/FLOW PUMP A
CONTROL SCHEMATIC

SIZE	DRAWING NUMBER	REV
A1	30\E\1350-001	3

KALGOORLIE CONSOLIDATED GOLD MINES PTY. LTD. ACN 009 377 619