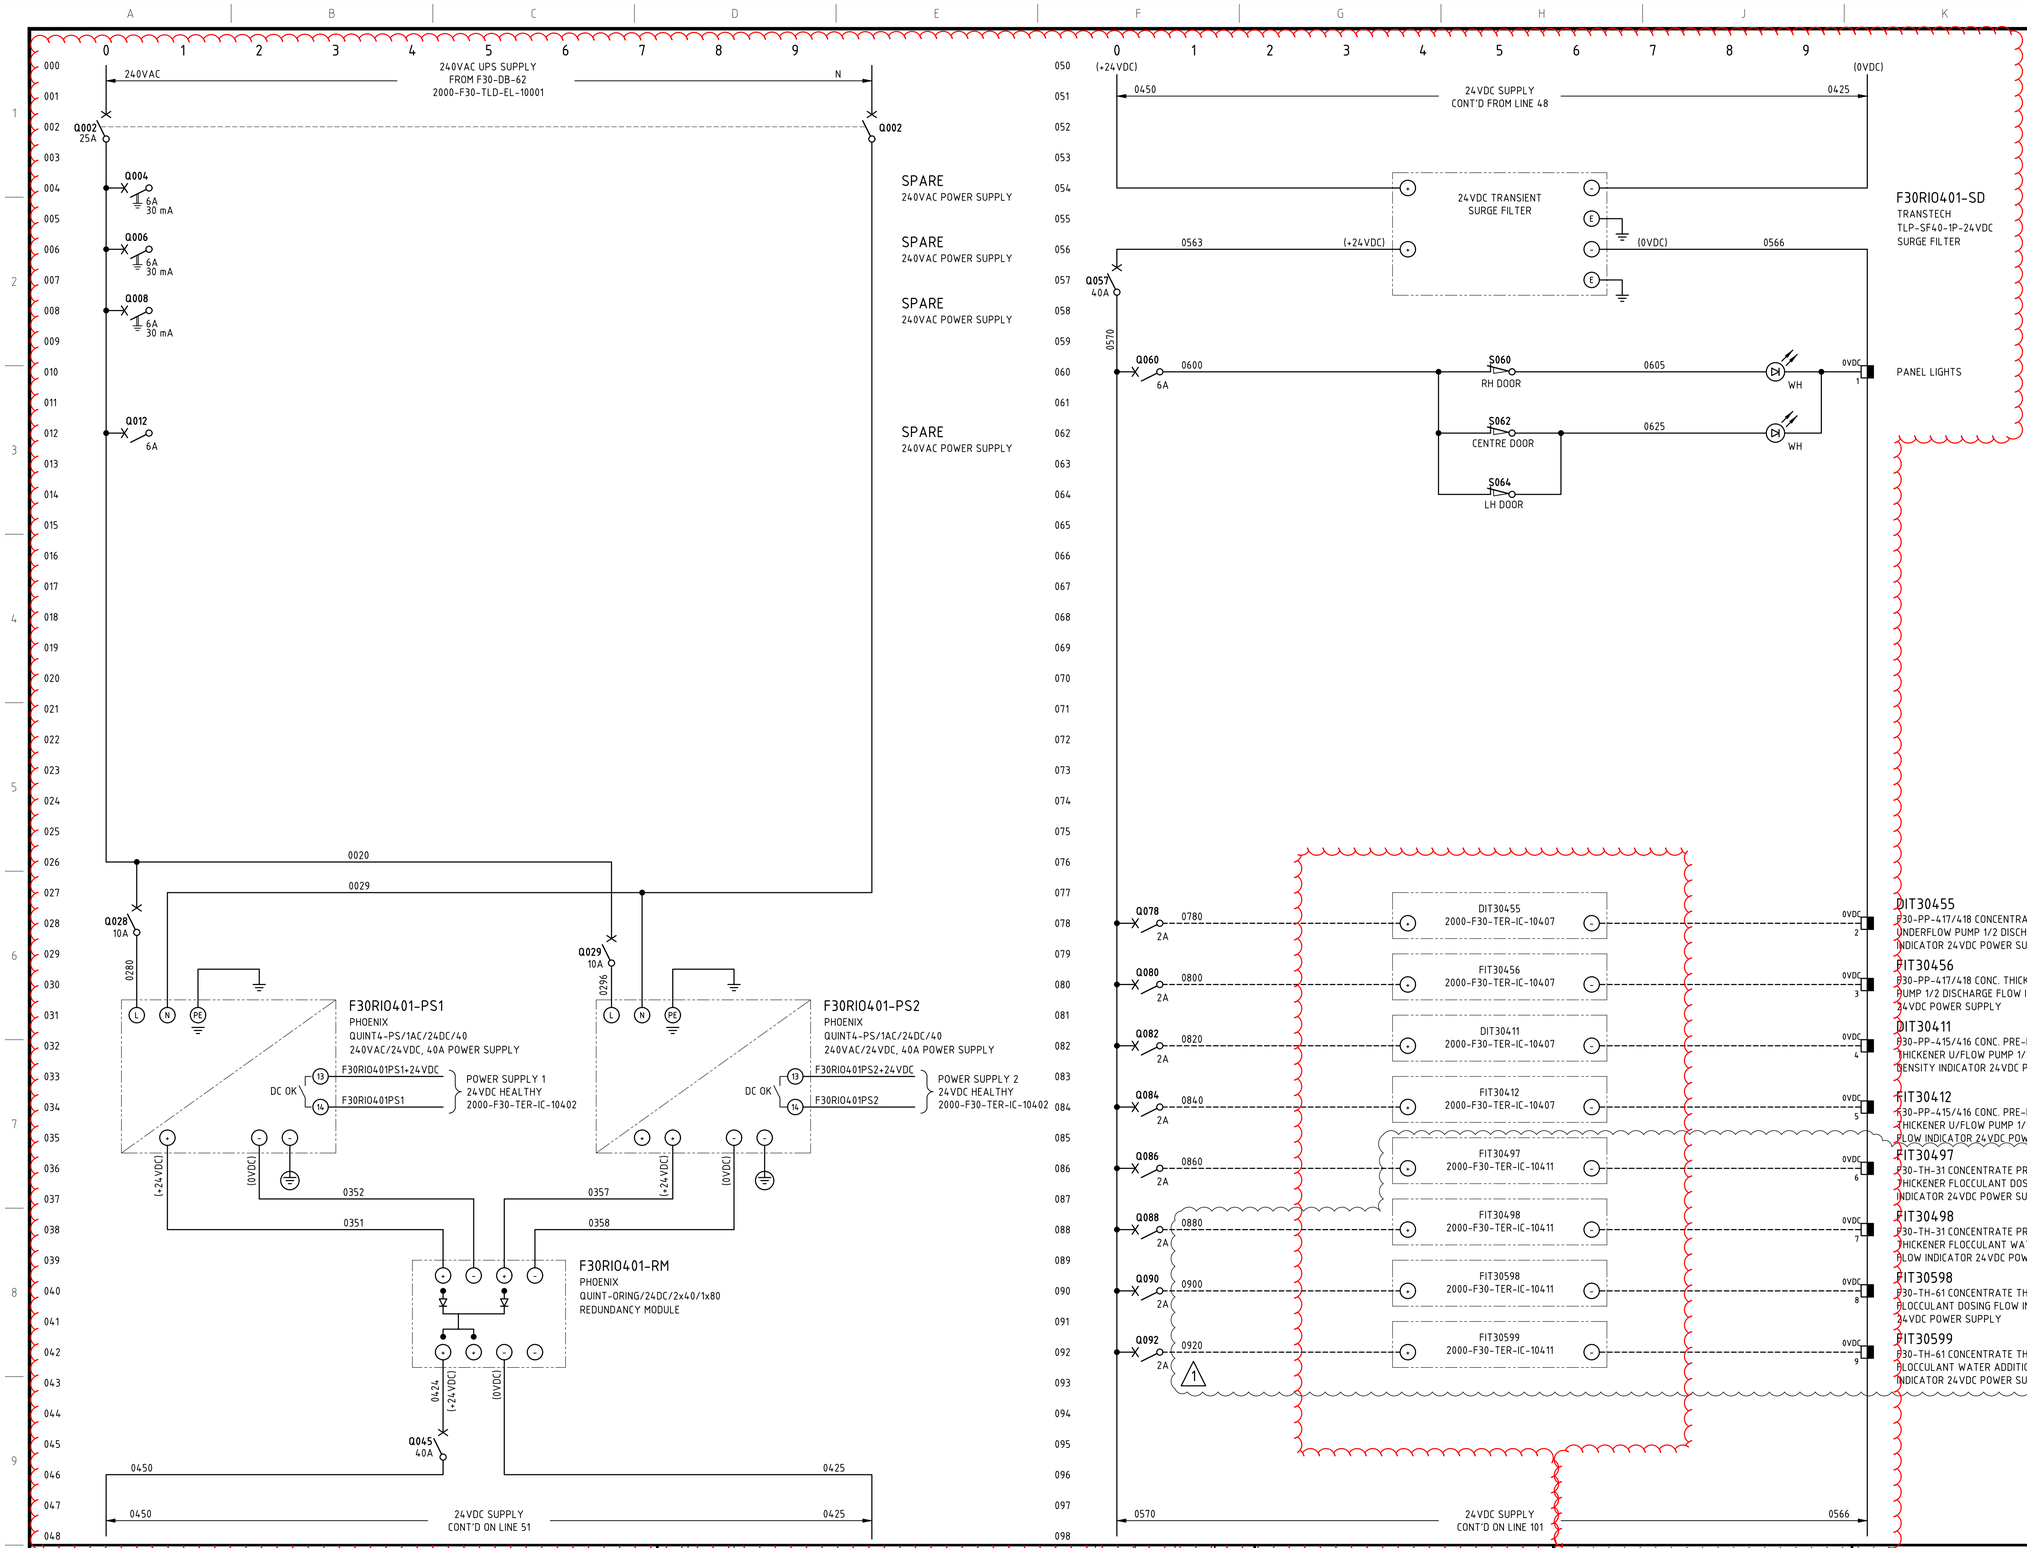


NOTES

1. TERMINALS ON TERMINAL STRIPS ABOVE 50VAC SHALL HAVE A SEPARATE PERSPEX SHROUD AND SHALL BE LABELLED "DANGER xxxVAC".
2. WIRE NUMBER FERRULES ON TERMINAL STRIP SHALL BE PREFIXED WITH EQUIPMENT NUMBER e.g. F30RIO401-xxxx.
3. EACH WIRE SHALL BE IDENTIFIED AT BOTH ENDS WITH FERRULES.
4. FOR NETWORK CONNECTION & BUS CABLING DETAILS REFER TO: RIO PANEL COMMUNICATIONS TERMINATION DIAGRAMS.
5. INSTRUMENT EARTH BAR TO BE BONDED TO MAIN BAR WITH SOLID COPPER LINK.

LEGEND

- FIELD TERMINAL
- DCS OR I/O TERMINAL
- 0VDC TERMINAL FOR 24VDC
- DEVICE TERMINAL
- INDICATION LAMP, cc = COLOUR
- EARTH BAR
- INSTRUMENT EARTH BAR

AS CONSTRUCTED

CHANGE: ☐ NO CHANGE: ☒

SIGNATURE: [redacted]
NAME: Will Herbert
DATE: 05/02/2026

ENGINEER SIGN OFF

SIGNATURE: Sanam Gurung
NAME: Sanam Gurung
DATE: 05/02/2026

DRG No.	REFERENCES
2000-F30-TLD-EL-10001	240V INSTRUMENT DISTRIBUTION BOARD NO. 62 POWER SCHEMATIC
2000-F30-DRG-IC-10401	F30-RIO-401 FIELD N-IO PANEL GENERAL ARRANGEMENT
2000-F30-SCM-IC-10402	F30-RIO-401 FIELD N-IO PANEL SCHEMATIC DIAGRAM SHEET 2
2000-F30-TER-IC-10400	F30-RIO-401 FIELD N-IO PANEL COMMUNICATIONS TERMINATION DIAGRAMS SHEET 1 (TO SHEET 2 – 10401)
2000-F30-TER-IC-10402	F30-RIO-401 FIELD N-IO PANEL TERMINATION DIAGRAMS SHEET 1 (TO SHEET 12 – 10413)
2000-F00-STD-EL-10001	GENERAL NOTES AND STANDARD DRAWINGS INDEX

REV	DATE	DESCRIPTION	DRAW	CHECK	DESIGN	TECH APP	PROJ APP
1RL1	05/02/26	As Constructed for Sub-System F30.10.08 FOR SP1					
1	06NOV25	FAT REDLINES INCORPORATED					
0	07APR25	APPROVED FOR CONSTRUCTION					

NORTHERN STAR RESOURCES LIMITED

PRIMERO
primero.com.au | DESIGN | CONSTRUCT | OPERATE

PRIMERO PROJECT NUMBER: 23517

INFORMATION AND REPRESENTATIONS ON THIS DRAWING ARE THE INTELLECTUAL PROPERTY OF PRIMERO UNLESS SPECIFICALLY IDENTIFIED OTHERWISE. ALL RIGHTS INCLUDING USE RESERVED

PROJECT: NORTHERN STAR RESOURCES LTD
KCGM GROWTH PROJECT

TITLE: FIMISTON PLANT – CARBON IN LEACH (CIL 3)
F30-RIO-401 CONC LEACH & ADSORPTION FIELD N-IO PANEL
SCHEMATIC DIAGRAM SHEET 1

SHEET	SCALE	DRG No.	REVISION
A1	NONE	2000-F30-SCM-IC-10401	1 RL1

O:\CAD PROJECTS\235 NORTHERN STAR RESOURCES LTD\23517 KCGM GROWTH PROJECT\03 DELIVERABLES\CF30 - CIL2_3 & CONCENTRATE THICKENING\2000-F30-SCM-IC-10401.DWG 19NOV25 11:46AM HOTSEAT04