
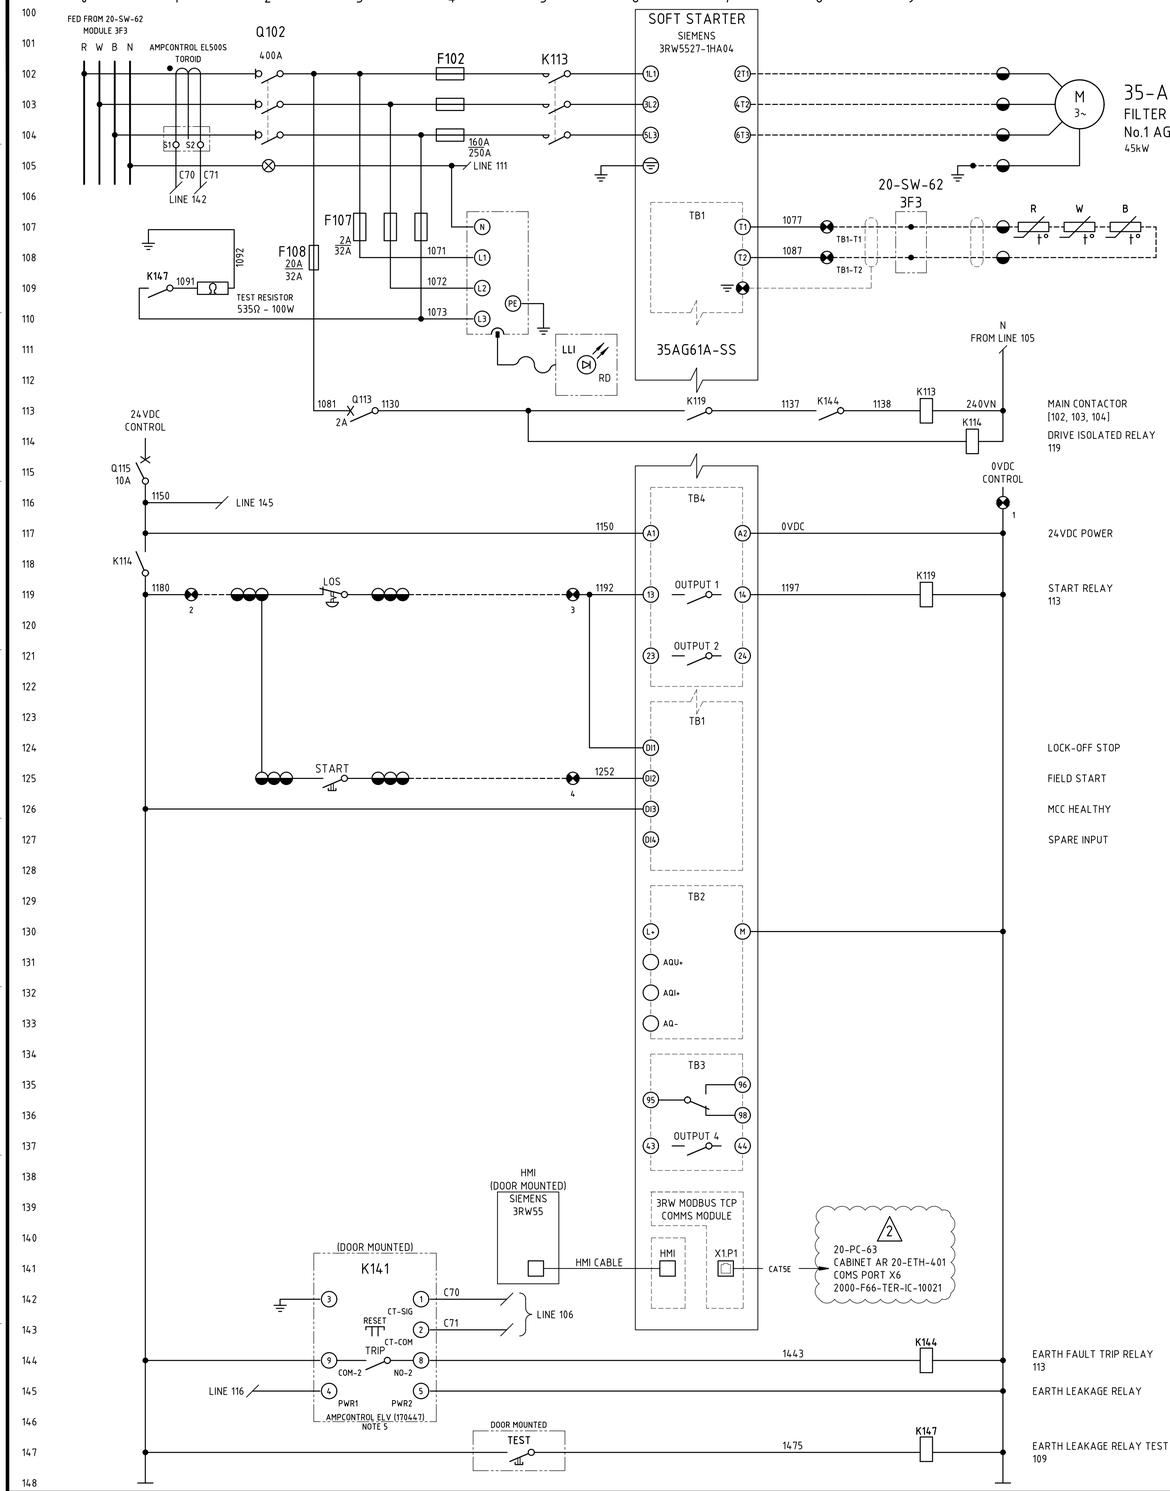


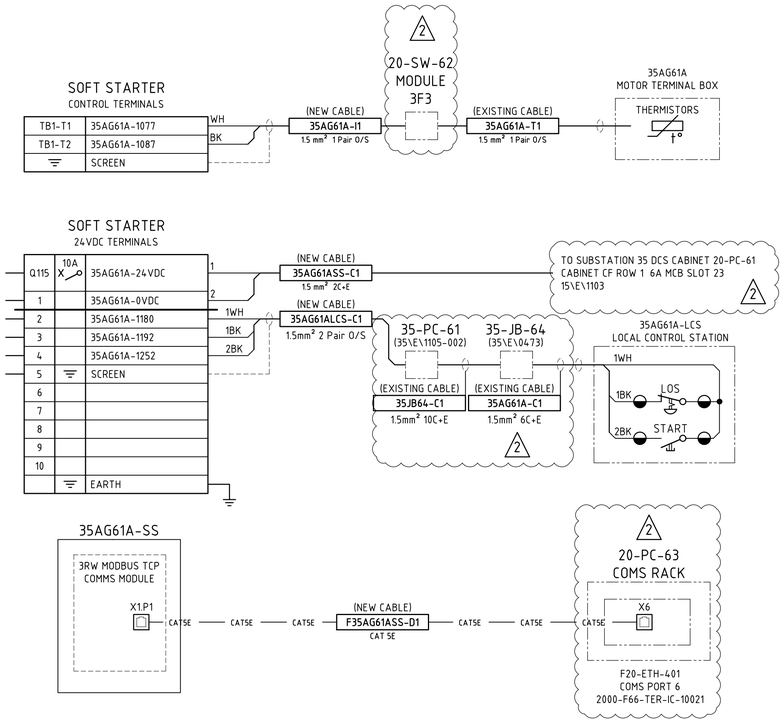


NOTES

1. TERMINALS ON TERMINAL STRIPS ABOVE 50VAC SHALL HAVE A SEPARATE PERSPEX SHROUD AND SHALL BE LABELLED "DANGER xxVAC".
2. WIRE NUMBER FERRULES ON TERMINAL STRIP SHALL BE PREFIXED WITH EQUIPMENT NUMBER i.e. 35AG61A-1200, UNLESS OTHERWISE NOTED.
3. EACH WIRE SHALL BE IDENTIFIED AT BOTH ENDS WITH FERRULES.
4. AMPCONTROL 101649 100/1A TOROID.
5. EARTH LEAKAGE RELAY (ELV) USER INTERFACE TO BE MOUNTED ON MCC MODULE DOOR. RELAY ENERGISED (NORMALLY CLOSED CONTACT OPEN) IN NORMAL OPERATION.
6. SWITCHGEAR SELECTED SHALL PROVIDE TYPE-2 CO-ORDINATION SUITABLE FOR HIGH-EFFICIENCY MOTORS.

LEGEND

- MCC MODULE TERMINAL
- FIELD TERMINAL
- DEVICE TERMINAL
- SOFT STARTER TERMINAL
- DCS OR I/O TERMINAL

TERMINATION LEGEND

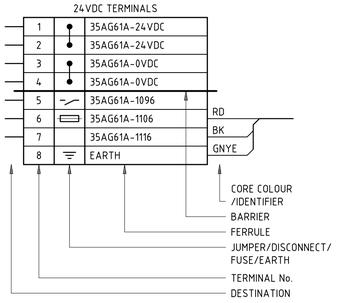

DRG No.	REFERENCES	REV	DATE	DESCRIPTION	DRAW	CHECK	DESIGN	TECH APP	PROJ APP
2000-F35-SLD-EL-10101	SUBSTATION NO. 35 MCC 20-SW-62 SINGLE LINE DIAGRAM SHEET 2								
2000-F35-DRG-EL-10161	TANK A AGITATOR SOFT STARTER PANEL 45KW GENERAL ARRANGEMENT	2	24AUG26	BROWN FIELDS INFRASTRUCTURE INCORPERATED			JB	JB	
2000-F20-TER-IC-10001	SUBSTATION NO. 35 DCS CABINET 20-PC-61 BR	1	20JUL26	FAT REDLINES INCORPORATED					
2000-F00-STD-EL-10001	GENERAL NOTES AND STANDARD DRAWINGS INDEX	0	20APR26	APPROVED FOR CONSTRUCTION					

NORTHERN STAR RESOURCES LIMITED

PRIMERO
primero.com.au | DESIGN | CONSTRUCT | OPERATE

PRIMERO PROJECT NUMBER: 23517

INFORMATION AND REPRESENTATIONS ON THIS DRAWING ARE THE INTELLECTUAL PROPERTY OF PRIMERO UNLESS SPECIFICALLY IDENTIFIED OTHERWISE. ALL RIGHTS INCLUDING USE RESERVED

PROJECT: NORTHERN STAR RESOURCES LTD
KCGM GROWTH PROJECT

TITLE: FIMISTON PLANT - SUBSTATION No. 35 MCC 20-SW-62
TANK A AGITATOR SOFT STARTER PANEL - 45kW
SCHEMATIC AND TERMINATION DIAGRAM

SHEET	SCALE	DRG No.	REVISION
A1	NONE	2000-F35-SCM-EL-10161	2

O:\CAD PROJECTS\235 NORTHERN STAR RESOURCES LTD\235TI KCGM GROWTH PROJECT\03 DELIVERABLES\EL\F35 - CONCENTRATE HANDLING & FILTRATION\2000-F35-SCM-EL-10161.DWG 24AUG26 9:52PM GRENVILLE.DEASY