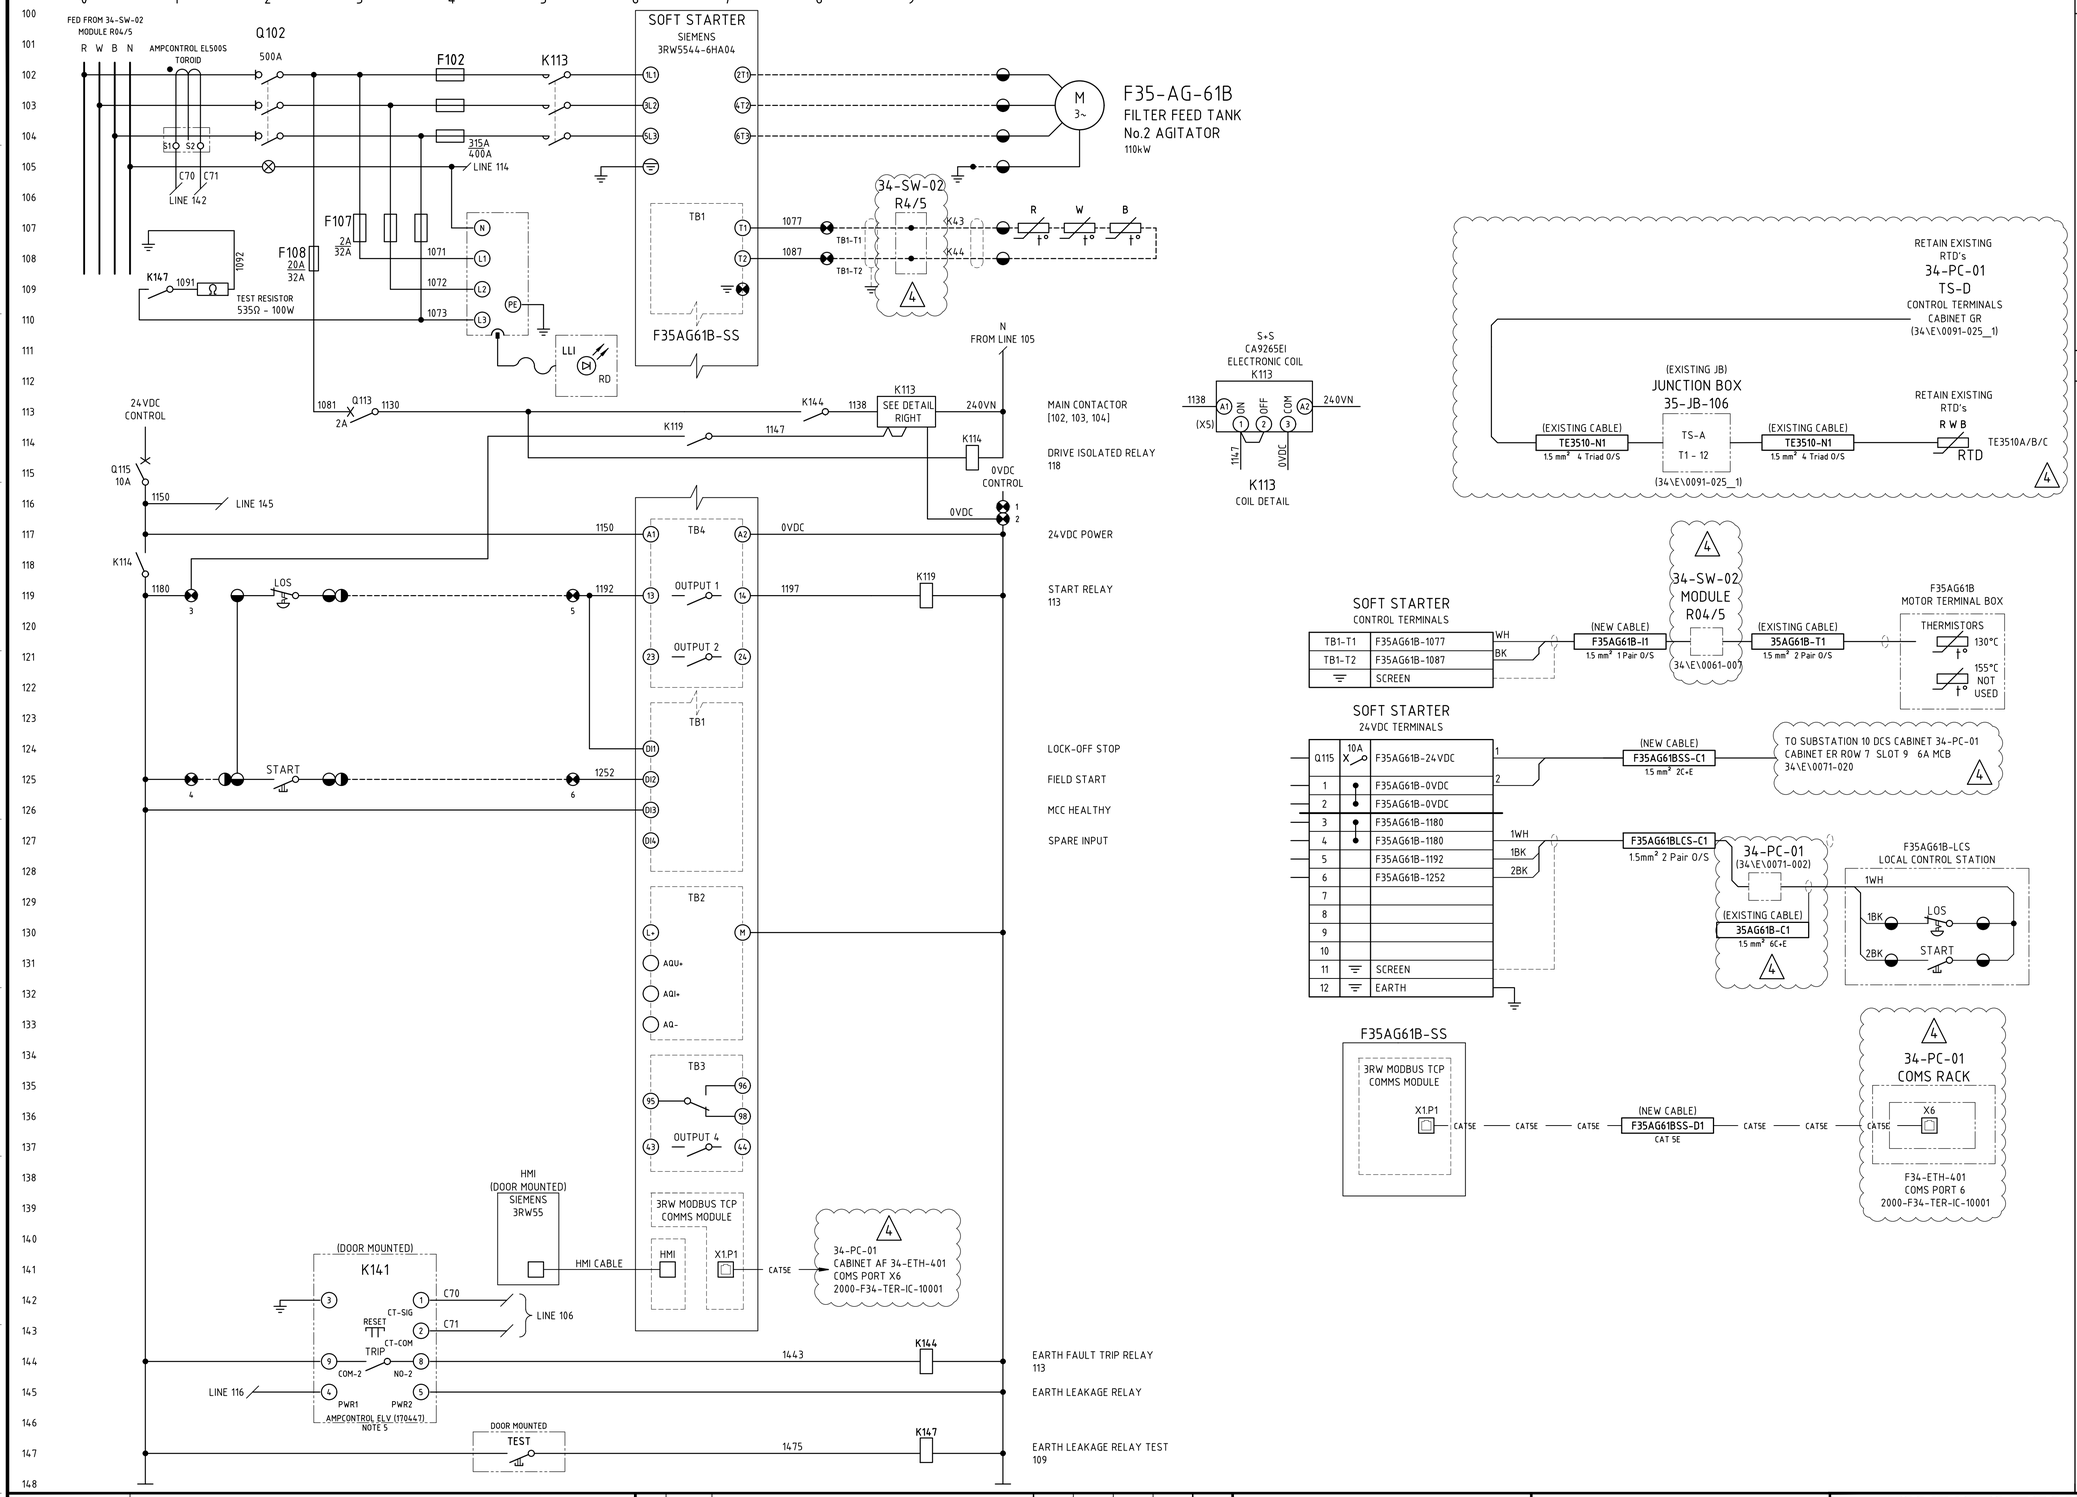



NOTES

1. TERMINALS ON TERMINAL STRIPS ABOVE 50VAC SHALL HAVE A SEPARATE PERSPEX SHROUD AND SHALL BE LABELLED "DANGER xxVAC".
2. WIRE NUMBER FERRULES ON TERMINAL STRIP SHALL BE PREFIXED WITH EQUIPMENT NUMBER i.e. F35AG61B-1200, UNLESS OTHERWISE NOTED.
3. EACH WIRE SHALL BE IDENTIFIED AT BOTH ENDS WITH FERRULES.
4. AMPCONTROL 101656
   100/1A TOROID.
5. EARTH LEAKAGE RELAY (ELV) USER INTERFACE TO BE MOUNTED ON MCC MODULE DOOR. RELAY ENERGISED (NORMALLY CLOSED CONTACT OPEN) IN NORMAL OPERATION.
6. SWITCHGEAR SELECTED SHALL PROVIDE TYPE-2 CO-ORDINATION SUITABLE FOR HIGH-EFFICIENCY MOTORS.

LEGEND

- MCC MODULE TERMINAL
- FIELD TERMINAL
- DEVICE TERMINAL
- SOFT STARTER TERMINAL
- DCS OR I/O TERMINAL

TERMINATION LEGEND

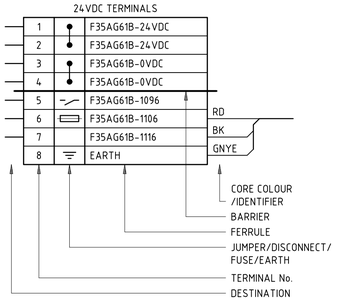

DRG No.	REFERENCES
2000-F34-SLD-EL-10102	SUBSTATION NO. 10 MCC 34-SW-02 SINGLE LINE DIAGRAM
2000-F35-DRG-EL-10162	TANK B AGITATOR SOFT STARTER PANEL 110KW GENERAL ARRANGEMENT
2000-F34-TER-IC-10004	SUBSTATION NO. 10 DCS CABINET 34-PC-01 ER
2000-F00-STD-EL-10001	GENERAL NOTES AND STANDARD DRAWINGS INDEX

REV	DATE	DESCRIPTION	DRAW	CHECK	DESIGN	TECH APP	PROJ APP
4	14SEP26	BROWN FIELDS INFRASTRUCTURE INCORPERATED					
3	20JUL26	FAT REDLINES INCORPERATED					
2	29MAY26	THERMISTOR CIRCUIT REINSTATED					
1	07MAY26	THERMISTOR CIRCUIT REMOVED REPLACED WITH EXISTING RTDS					
0	20APR26	APPROVED FOR CONSTRUCTION					

NORTHERN STAR RESOURCES LIMITED

PRIMERO
primero.com.au | DESIGN | CONSTRUCT | OPERATE

PRIMERO PROJECT NUMBER: 23517

INFORMATION AND REPRESENTATIONS ON THIS DRAWING ARE THE INTELLECTUAL PROPERTY OF PRIMERO UNLESS SPECIFICALLY IDENTIFIED OTHERWISE. ALL RIGHTS INCLUDING USE RESERVED

PROJECT: NORTHERN STAR RESOURCES LTD
KCGM GROWTH PROJECT

TITLE: FIMISTON PLANT - SUBSTATION No. 10 MCC 34-SW-02
TANK B AGITATOR SOFT STARTER PANEL - 110kW
SCHEMATIC AND TERMINATION DIAGRAM

SHEET	SCALE	DRG No.	REVISION
A1	NONE	2000-F35-SCM-EL-10162	4

O:\CAD PROJECTS\23S NORTHERN STAR RESOURCES LTD\23517 KCGM GROWTH PROJECT\03 DELIVERABLES\EL\F35 - CONCENTRATE HANDLING & FILTRATION\2000-F35-SCM-EL-10162.DWG 14:SEP26 2:12PM GRENVILLE.DEASY