
Docusign Envelope ID: D3EAC8FF-146A-4610-AFF4-26203B4BB02C

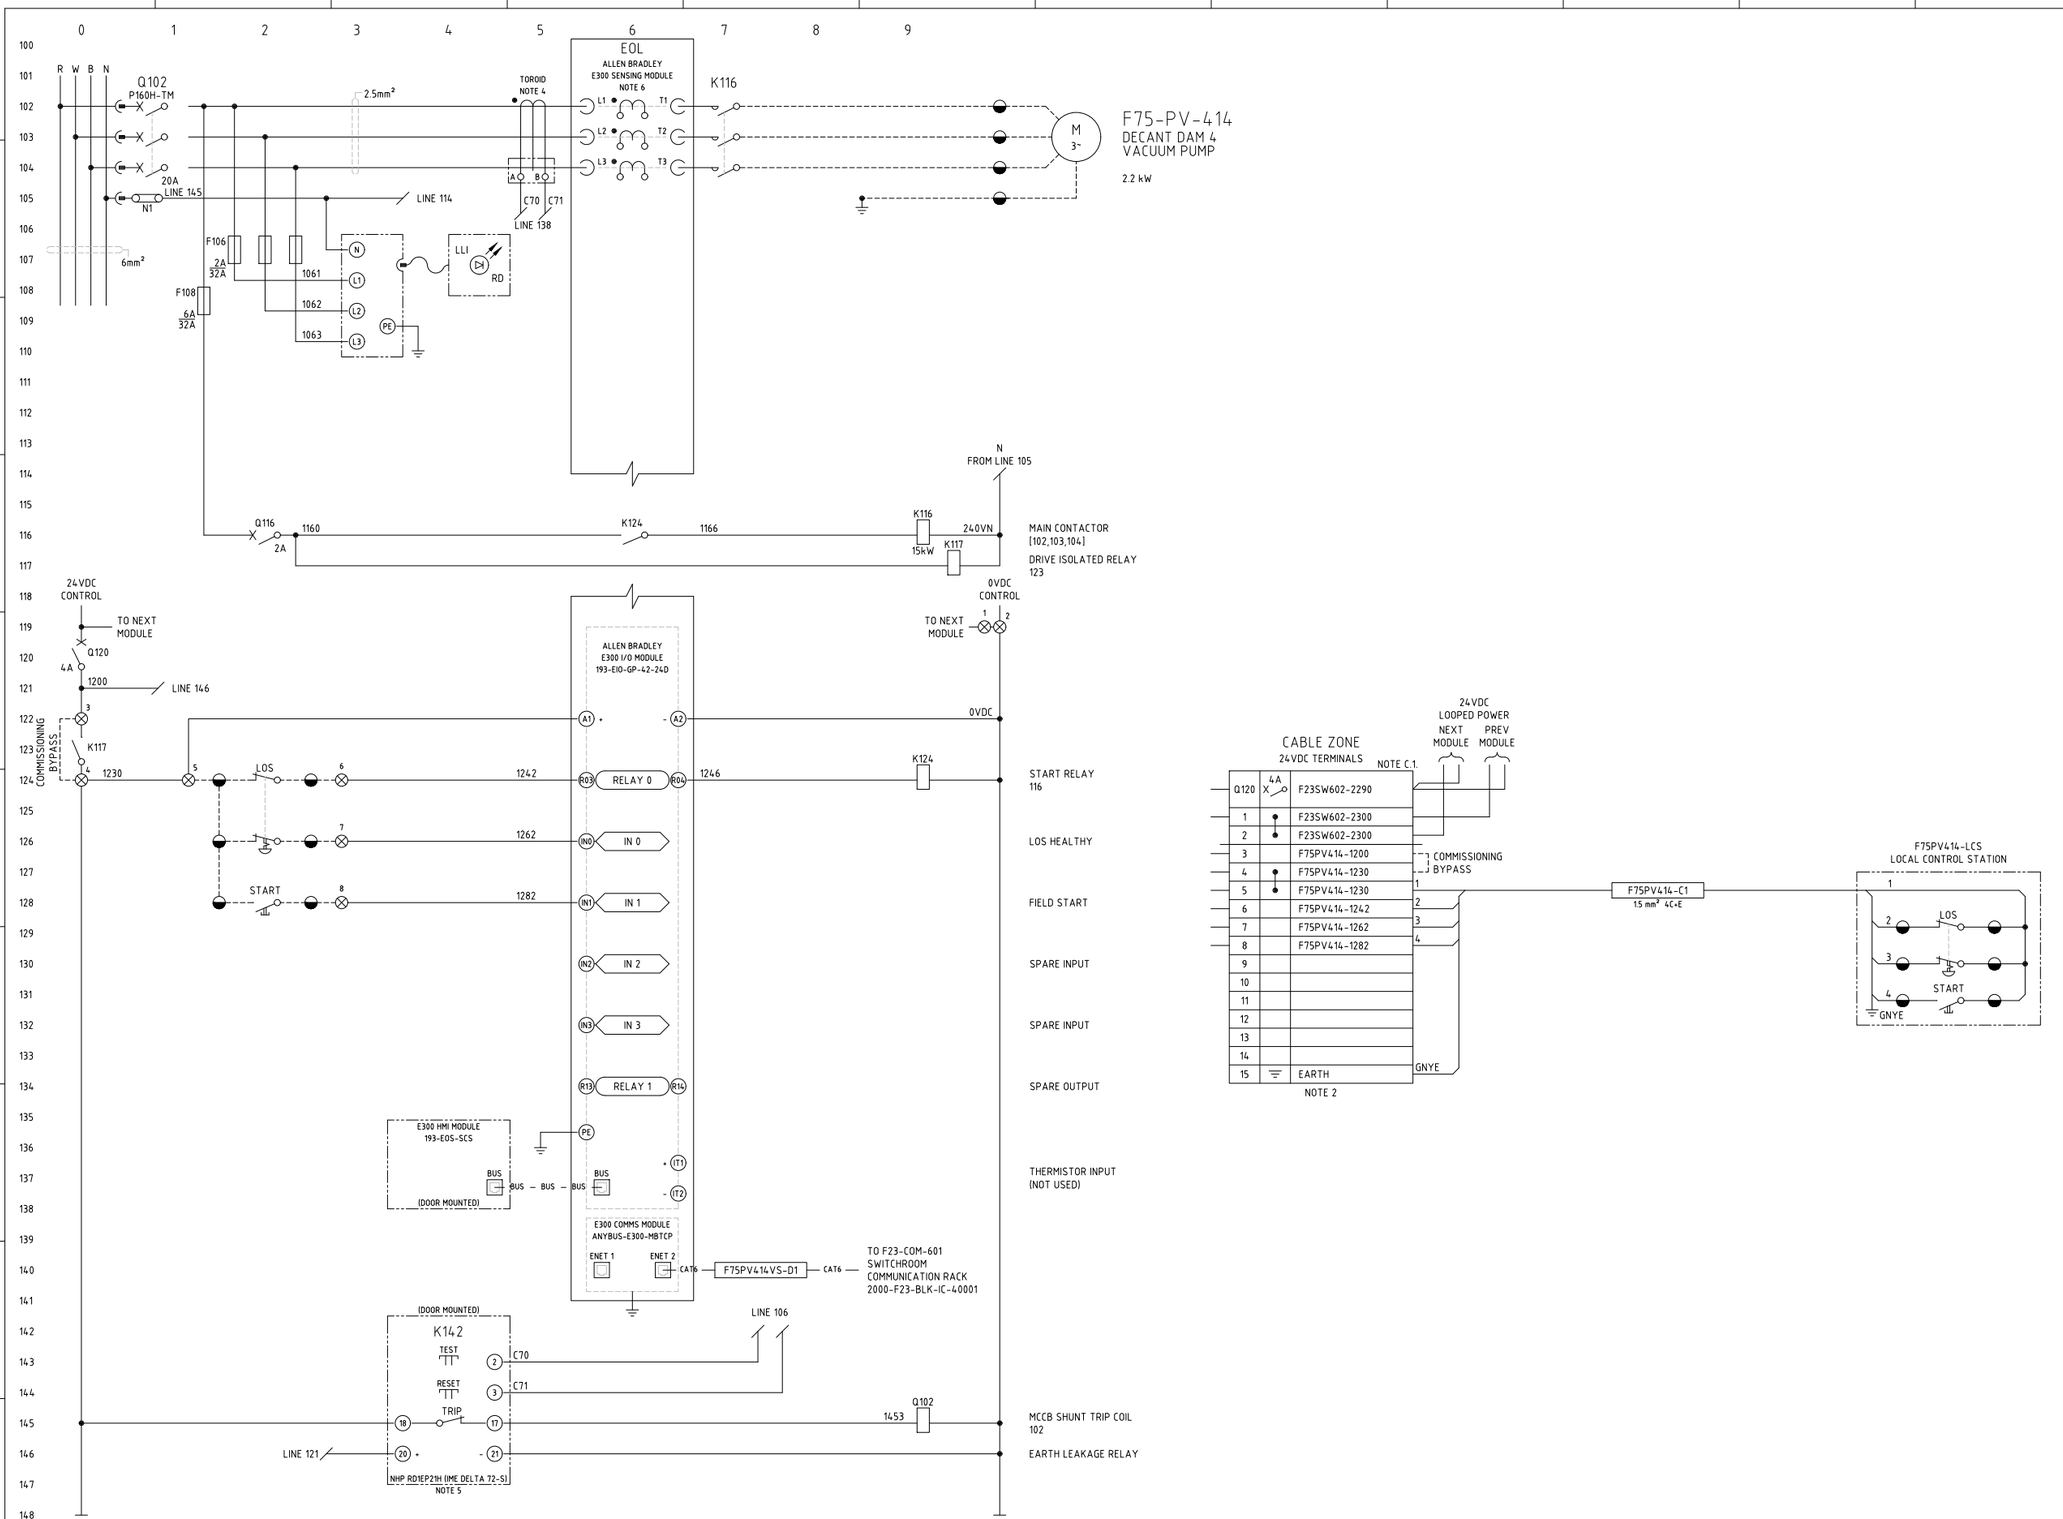

NOTES

1. TERMINALS ON TERMINAL STRIPS ABOVE 50VAC SHALL HAVE A SEPARATE PERSPEX SHROUD AND SHALL BE LABELLED "DANGER xxxVAC".
2. WIRE NUMBER FERRULES ON TERMINAL STRIP SHALL BE PREFIXED WITH EQUIPMENT NUMBER e.g. F23PV414-1200.
3. EACH WIRE SHALL BE IDENTIFIED AT BOTH ENDS WITH FERRULES.
4. THE ELV RELAY REQUIRES A SEPARATELY PURCHASED EL500S TOROID FOR MEASUREMENT OF THE EARTH LEAKAGE CURRENT. EL500S TOROIDS ARE AVAILABLE IN THE FOLLOWING WINDOW SIZES: 25mm, 60mm & 112mm. (TDGB2) In:70A
5. EARTH LEAKAGE RELAY (ELV) USER INTERFACE TO BE MOUNTED ON MCC MODULE DOOR.
   RELAY SETTINGS SET TO:
   TRIP LEVEL ="1A" (POSITION 0).
   TRIP DELAY = "100ms" (POSITION 1).
6. E300 SENSING MODULE FOR VOLTAGE/ CURRENT/ GROUND FAULT (VIG RANGE) TO SUIT MOTOR KW DUTY. (193-ESM-I-30A-T) 0.5-30A
7. REFER TO CABLE SCHEDULE 2000-F23-LST-EL-40003.


LEGEND

- 00/01/00 — DCS DIGITAL INPUT
- 00/02/00 — DCS DIGITAL OUTPUT
- ⊗ — MCC TERMINAL
- ◓ — VSD TERMINAL
- ◒ — FIELD TERMINAL
- ◑ — DCS OR I/O TERMINAL
- ◧ — MARSHALLING TERMINAL
- (x) — DEVICE TERMINAL
- ⊗ cc — INDICATION LAMP, cc = COLOUR

DCS LEGEND



TERMINATION LEGEND

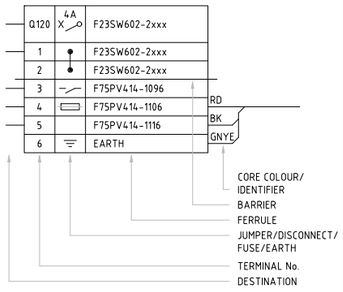

AS BUILT

MCC CELL LOCATION 4F-10

REFERENCES	DWG No	REV	DATE	REVISION	DRN	CHK	TECH APP	APP
		2	13.MAR.26	AS-BUILT FOR FIM TSF III	ET	EA	MC	[redacted]
F23-SW-602 LV MOTOR CONTROL CENTRE SINGLE LINE DIAGRAM SHT 2 OF 2	2000-F23-SLD-EL-40012	1	13.JUN.25	RE-APPROVED FOR CONSTRUCTION	TG	[redacted]	KVN	
GENERAL NOTES AND STANDARD DRAWINGS INDEX	2000-F00-STD-EL-10001	0	17.JAN.25	ISSUED FOR CONSTRUCTION	TG	[redacted]	KVN	

NORTHERN STAR RESOURCES LIMITED

DRA PACIFIC (PTY) LIMITED

[redacted]	[redacted]	02.DEC.2024
CHECKED	[redacted] WEE	02.DEC.2024
DE[redacted]	[redacted] NAMEN	02.DEC.2024
TECH APP	K[redacted]	20.DEC.2024
[redacted]PP	T. HAMDORF	17.JAN.2025
CLIENT APP		

PROJECT: KCGM
FIM TSF PROJECT

TITLE: FIM III BOOSTER STATION
F75-PV-414 DECANT DAM 4 VACUUM PUMP
CONTROL SCHEMATIC DIAGRAM

[redacted] SCALE NTS | DRG No. 2000-F75-SCM-EL-40004 | REV 2