
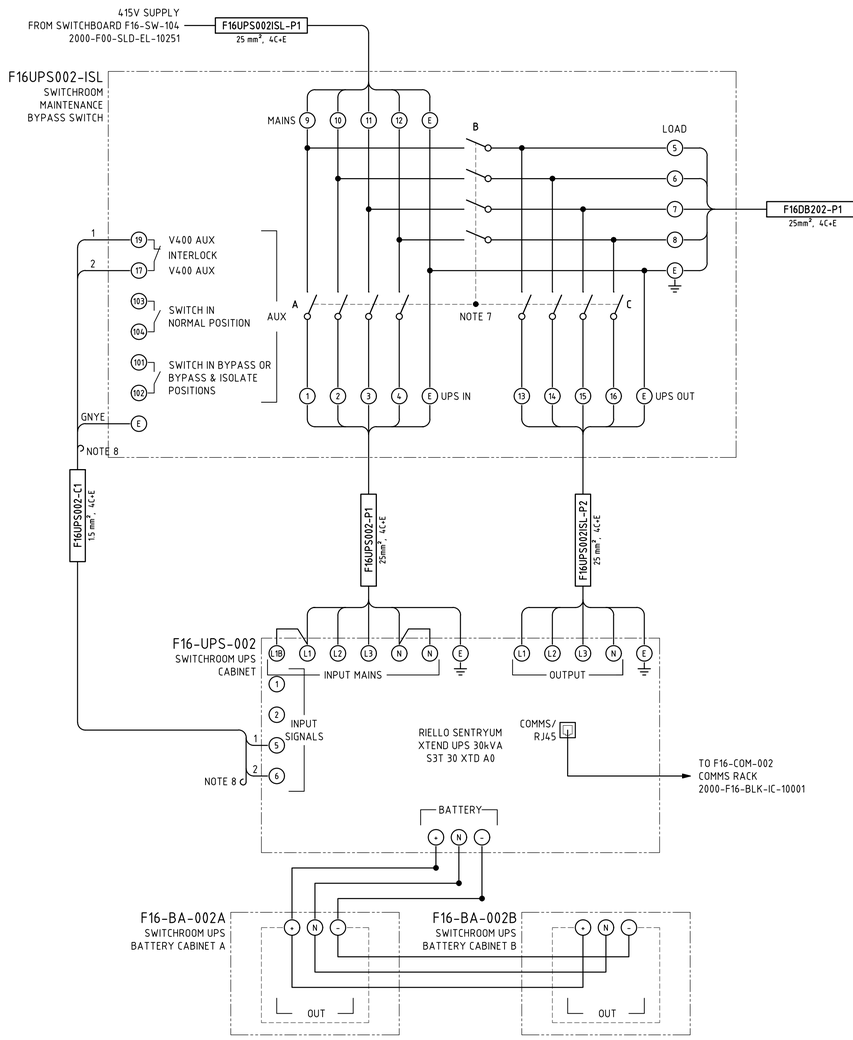


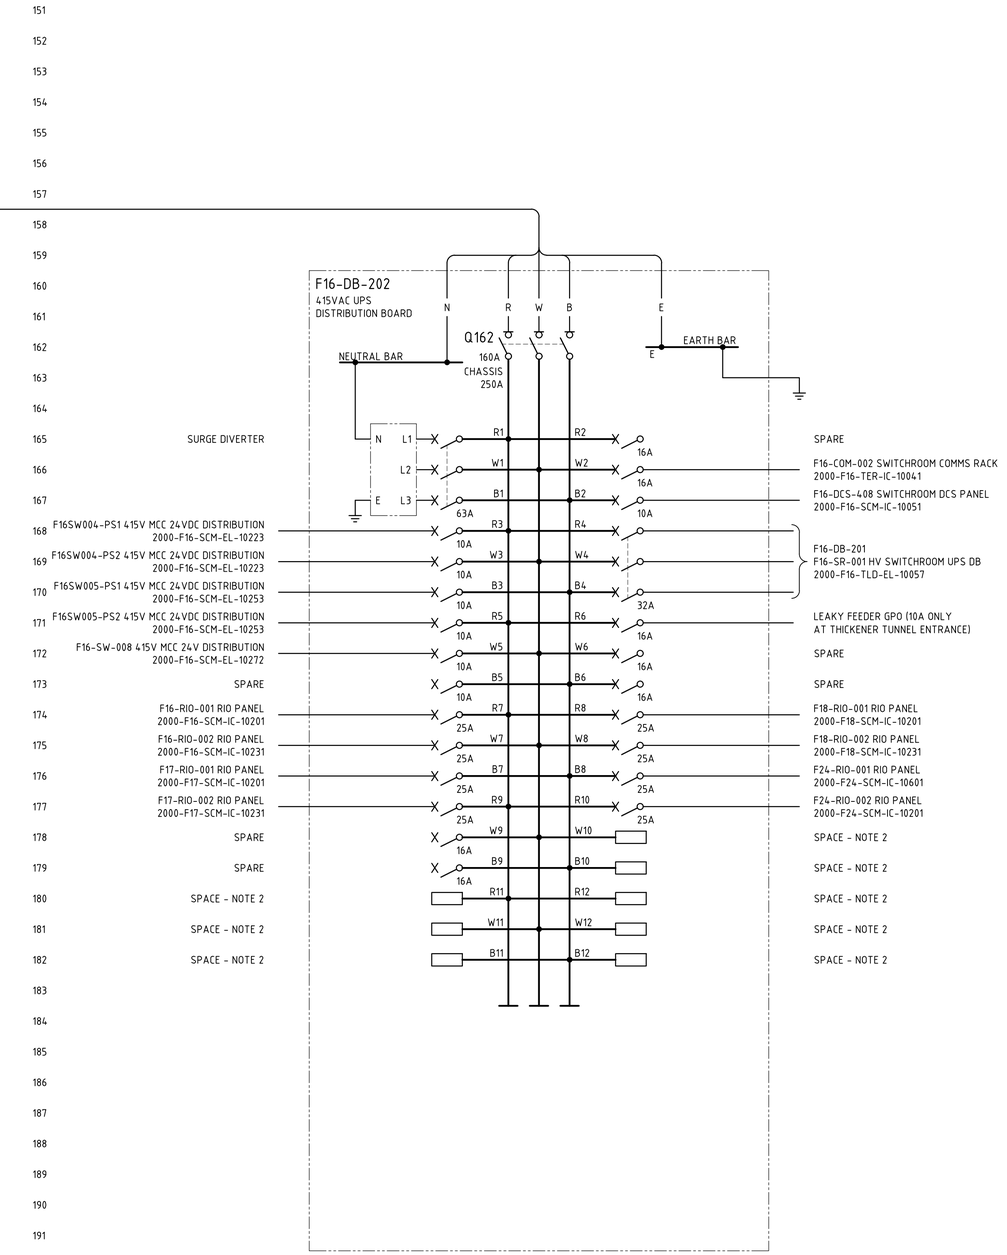

NOTES

1. CIRCUIT BREAKERS SHALL BE PAD-LOCKABLE IN THE 'OFF' POSITION ONLY, VIA LOCK-DOGS OR SIMILAR, LOCKING TO ESCUTCHEON SHALL NOT BE ACCEPTABLE.
2. ALL SPARE SPACE SHALL BE FILLED WITH DUMMY CIRCUIT BREAKERS, ESCUTCHEON POLE FILLERS SHALL NOT BE ACCEPTABLE.
3. EQUIPOTENTIAL BONDING CONDUCTOR SHALL BE INSTALLED FROM DB EARTH BAR TO SWITCHROOM EARTH BAR OR NEAREST EARTHED STRUCTURE VIA 35mm² Cu GNYE/PVC OR AS PER CABLE SCHEDULE.
4. AS-BUILT CIRCUIT SCHEDULE SHALL BE KEPT INTERNAL TO DISTRIBUTION BOARD AT ALL TIMES.
5. MINIMUM 20% SPARE CIRCUIT BREAKERS AND ADDITIONAL 20% SPARE SPACE SHALL BE PROVIDED FOR FUTURE LOADS.
6. DISTRIBUTION BOARD SHALL BE CONSTRUCTED IN ACCORDANCE WITH STANDARD - 2000-F00-STS-EL-10007. LOW VOLTAGE DISTRIBUTION BOARDS SPECIFICATION.
7. UPS MAINTENANCE BYPASS SWITCH SHALL BE OF THE ROTARY 3-POSITION TYPE. POSITIONS AS FOLLOWS:
 NORMAL MODE: SWITCH A & C CLOSED
 BYPASS MODE: SWITCH A & B CLOSED
 BYPASS & ISOLATE MODE: SWITCH B CLOSED.
8. SPARE CABLE CORES TO BE TAPED BACK - HEAT SHRINK APPLIED TO BOTH ENDS AND MADE SAFE.

LEGEND

- MCC TERMINAL
- VSD TERMINAL
- FIELD TERMINAL
- PLC OR I/O TERMINAL
- MARSHALLING TERMINAL
- DISTRIBUTION BOARD TERMINAL
- DEVICE TERMINAL
- INDICATION LAMP, cc = COLOUR
- DUMMY CIRCUIT BREAKER, NOTE 2

DRG No.	REFERENCES	REV	DATE	DESCRIPTION
		2	07SEP26	KCGM GROWTH PROJECT - SP1 AS-BUILT
2000-F16-SLD-EL-10211	F16-SW-104 415V ESSENTIAL SWITCHBOARD SINGLE LINE DIAGRAM SHEET 1	1	26AUG25	FAT REDLINES INCORPORATED
2000-F00-STD-EL-10001	GENERAL NOTES AND STANDARD DRAWINGS INDEX	0	17SEP24	APPROVED FOR CONSTRUCTION

DRAW | CHECK | DESIGN | TECH APP | PROJ APP

NORTHERN STAR RESOURCES LIMITED

PRIMERO
primero.com.au | DESIGN | CONSTRUCT | OPERATE

PRIMERO PROJECT NUMBER: 23517

INFORMATION AND REPRESENTATIONS ON THIS DRAWING ARE THE INTELLECTUAL PROPERTY OF PRIMERO UNLESS SPECIFICALLY IDENTIFIED OTHERWISE. ALL RIGHTS INCLUDING USE RESERVED

PROJECT: NORTHERN STAR RESOURCES LTD
KCGM GROWTH PROJECT

TITLE: ROUGHER & SCAVENGER FLOTATION - F16-SR-002
F16-DB-202 LV SWITCHROOM 415V UPS DB
THREE LINE DIAGRAM

SHEET	SCALE	DRG No.	REVISION
A1	NONE	2000-F16-TLD-EL-10056	2

O:\CAD PROJECTS\235 NORTHERN STAR RESOURCES LTD\23517 KCGM GROWTH PROJECT\03 DELIVERABLES\ELV\F16 - ROUGHER & SCAVENGER FLOTATION\2000-F16-TLD-EL-10056.DWG 04SEP26 1:21PM ROBIN.LAW