


Docusign Envelope ID: D3EAC8FF-146A-4610-AFF4-26203B4BB02C

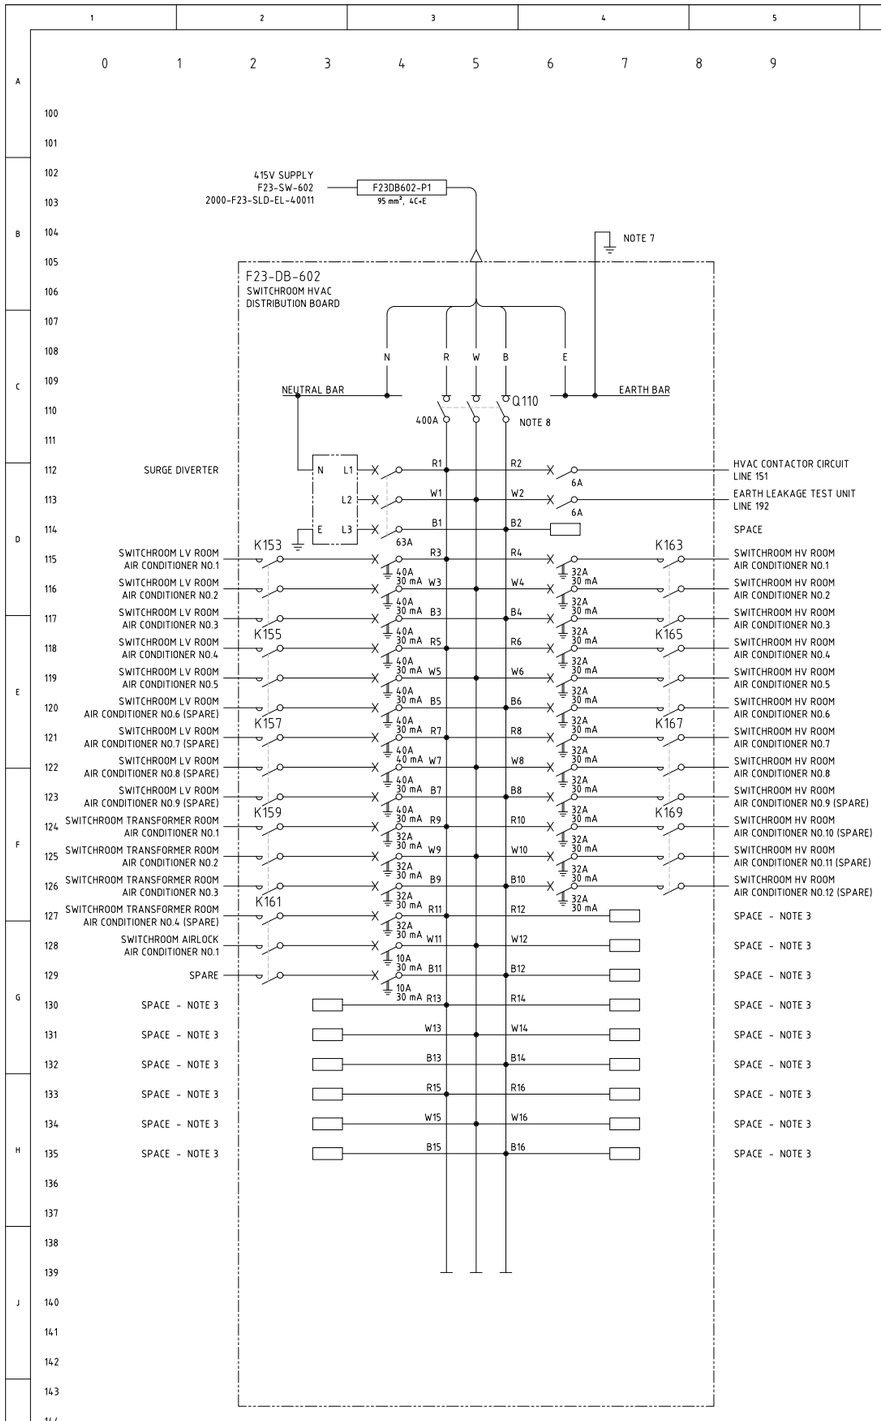

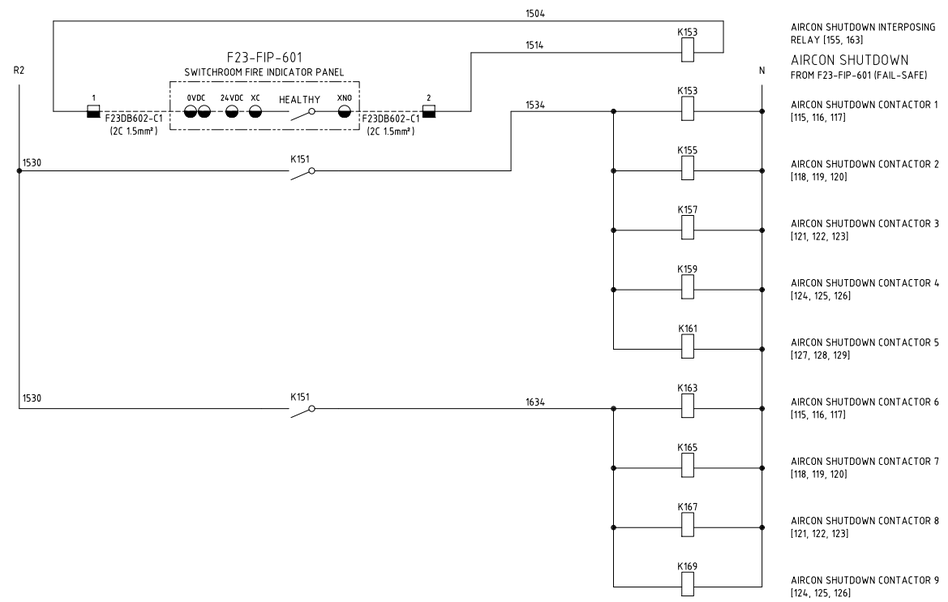

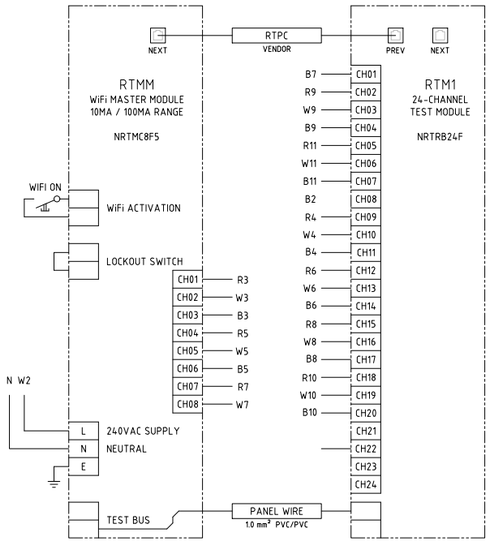

NOTES

1. THREE PHASE CIRCUITS SHALL ALWAYS BE PLACED ACROSS CIRCUIT RWB - i.e. R7, W7, B7 - NEVER ACROSS MIXED CIRCUITS i.e. B5, R7, W7.
2. CIRCUIT BREAKERS SHALL BE PAD-LOCKABLE IN THE 'OFF' POSITION ONLY, VIA LOCK-DOGS OR SIMILAR, LOCKING TO ESCUTCHEON SHALL NOT BE ACCEPTABLE.
3. ALL SPARE SPACE SHALL BE FILLED WITH DUMMY CIRCUIT BREAKERS, ESCUTCHEON POLE FILLERS SHALL NOT BE ACCEPTABLE.
4. ESCUTCHEON SHALL BE KEYED TO MAIN ISOLATOR HANDLE SUCH THAT ESCUTCHEON CANNOT BE REMOVED WHILE BOARD IS LIVE.
5. NEUTRAL CIRCUITS FED FROM RCDs MUST BE WIRED BACK TO THE NEUTRAL OF THE RCD, NOT THE NEUTRAL BAR.
6. MINIMUM 20% SPARE CIRCUIT BREAKERS AND ADDITIONAL 20% SPARE SPACE SHALL BE PROVIDED FOR FUTURE LOADS.
7. EQUIPOTENTIAL BONDING CONDUCTOR SHALL BE INSTALLED FROM DB EARTH BAR TO SWITCHROOM EARTH BAR OR NEAREST EARTHED STRUCTURE VIA 35mm² Cu GNYE/PVC OR AS PER CABLE SCHEDULE.
8. FOR PROSPECTIVE FAULT CURRENT >10kA, FUSED-SWITCH SHALL BE INSTALLED IN PLACE OF LOAD-BREAK ISOLATOR C/W HRC gG FAULT-CURRENT LIMITING FUSES, SIZED TO SUIT.
9. 6kA MINIATURE CIRCUIT BREAKERS SHALL ONLY BE USED WITH ENGINEERING APPROVAL.
10. AS-BUILT CIRCUIT SCHEDULE SHALL BE KEPT INTERNAL TO DISTRIBUTION BOARD AT ALL TIMES.
11. P.E. CELL SHALL BE INSTALLED OUT OF DIRECT LINE OF ANY LIGHTING.
12. REFER GENERAL ARRANGEMENT 2000-F00-STD-EL-10022 FOR ALL WIRING AND CONSTRUCTION DETAILS.
13. DISTRIBUTION BOARD SHALL BE CONSTRUCTED IN ACCORDANCE WITH STANDARD - 2000-F00-STS-EL-10007. LOW VOLTAGE DISTRIBUTION BOARDS SPECIFICATION.
14. REFER TO CABLE SCHEDULE 2000-F23-LST-EL-40003.

LEGEND

- PE CELL
- MCC TERMINAL
- VSD TERMINAL
- FIELD TERMINAL
- PLC OR I/O TERMINAL
- MARSHALLING TERMINAL
- DISTRIBUTION BOARD TERMINAL
- DEVICE TERMINAL
- INDICATION LAMP (cc = COLOUR)
- DUMMY CIRCUIT BREAKER (NOTE 2)

AS BUILT

REFERENCES	DWG No	REV	DATE	REVISION	DRN	CHK	TECH APP	APP
F23-DB-601 HV/LV SWITCHROOM AND AREA L&SP DB THREE-LINE DIAGRAM	2000-F23-TLD-EL-40011				[redacted]	JYW	MC	[redacted]
F23-SW-602 LV MOTOR CONTROL CENTRE SINGLE LINE DIAGRAM SHEET 1	2000-F23-SLD-EL-40011	2	20.MAR.26	AS BUILT FOR FIM III TSF	[redacted]	[redacted]	MC	[redacted]
F23-SR-601 HV/LV SWITCHROOM GENERAL ARRANGEMENT	2000-F23-DRG-EL-40001	1	19.MAR.25	RE-APPROVED FOR CONSTRUCTION	[redacted]	JYW	KVN	[redacted]
GENERAL NOTES AND STANDARD DRAWING INDEX	2000-F00-SLD-EL-10001	0	17.JAN.25	APPROVED FOR CONSTRUCTION	[redacted]	KVN	KVN	[redacted]

NORTHERN STAR RESOURCES LIMITED

DRA PACIFIC (PTY) LIMITED

[redacted]	T. [redacted]	02.DEC.2024
CHECKED	K. VAN NAMEN	19.DEC.2024
DESIGNED	T. [redacted]OOM	20.NOV.2024
TECH APP	K. [redacted]	20.DEC.2024
[redacted]APP	T. [redacted]	17.JAN.2025
CLIENT APP		

PROJECT: KCGM
FIM TSF PROJECT

TITLE: FIM III BOOSTER STATION
F23-DB-602 HV/LV SWITCHROOM HVAC DB
THREE-LINE DIAGRAM

A1 | SCALE NTS | DRG No. 2000-F23-TLD-EL-40012 | REV 2