
Docusign Envelope ID: D3EAC8FF-146A-4610-AFF4-26203B4BB02C

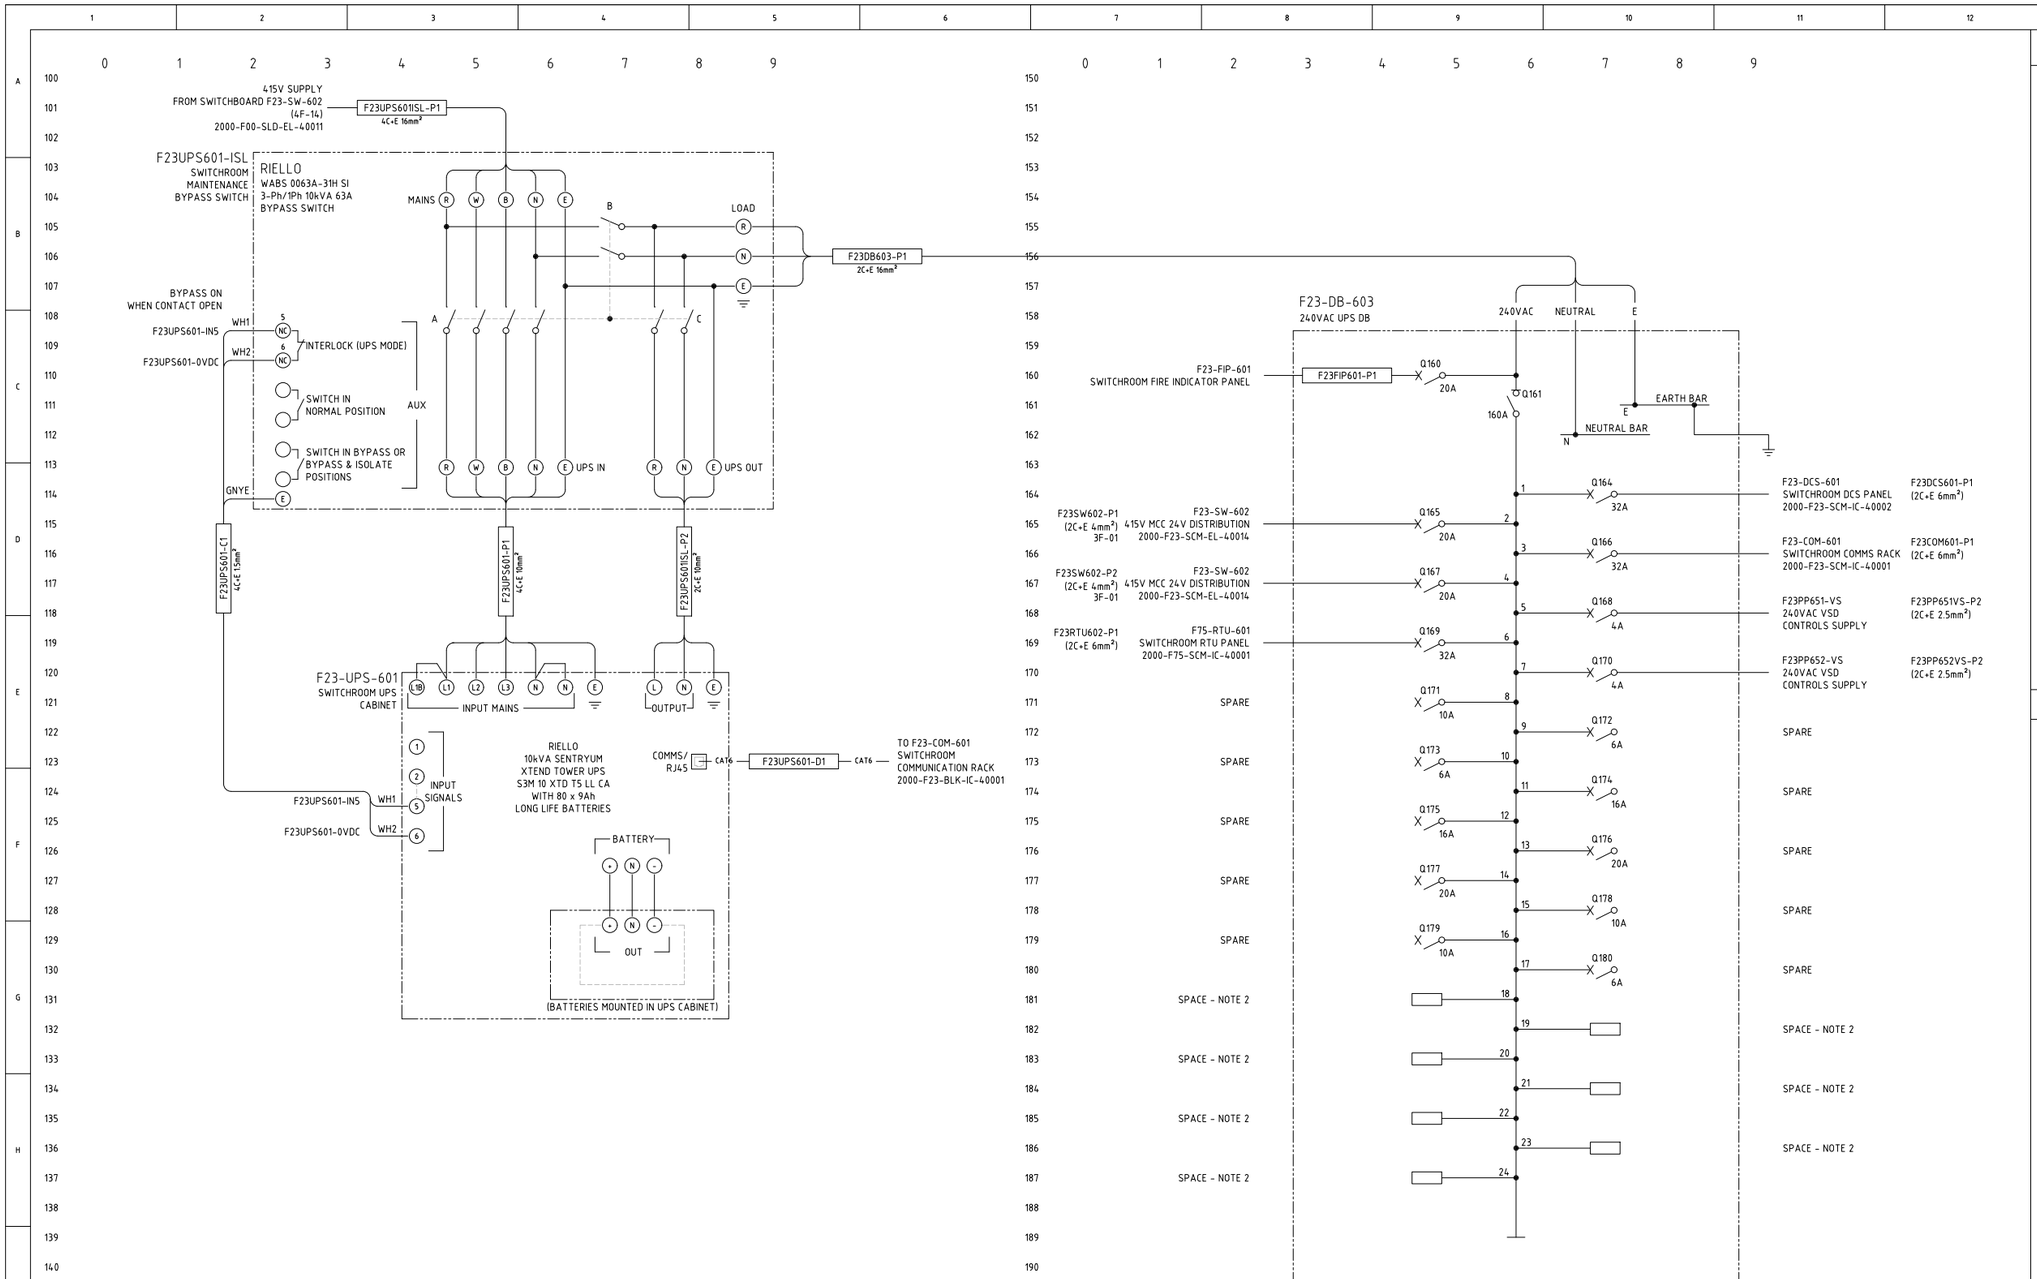

NOTES

1. CIRCUIT BREAKERS SHALL BE PAD-LOCKABLE IN THE 'OFF' POSITION ONLY, VIA LOCK-DOGS OR SIMILAR, LOCKING TO ESCUTCHEON SHALL NOT BE ACCEPTABLE.
2. ALL SPARE SPACE SHALL BE FILLED WITH DUMMY CIRCUIT BREAKERS, ESCUTCHEON POLE FILLERS SHALL NOT BE ACCEPTABLE.
3. EQUIPOTENTIAL BONDING CONDUCTOR SHALL BE INSTALLED FROM DB EARTH BAR TO SWITCHROOM EARTH BAR OR NEAREST EARTHED STRUCTURE VIA 35mm² Cu GNYE/PVC OR AS PER CABLE SCHEDULE.
4. AS-BUILT CIRCUIT SCHEDULE SHALL BE KEPT INTERNAL TO DISTRIBUTION BOARD AT ALL TIMES.
5. MINIMUM 20% SPARE CIRCUIT BREAKERS AND ADDITIONAL 20% SPARE SPACE SHALL BE PROVIDED FOR FUTURE LOADS.
6. DISTRIBUTION BOARD SHALL BE CONSTRUCTED IN ACCORDANCE WITH STANDARD - 2000-F00-STS-EL-10007. LOW VOLTAGE DISTRIBUTION BOARDS SPECIFICATION.
7. UPS MAINTENANCE BYPASS SWITCH SHALL BE OF THE ROTARY 3-POSITION TYPE. POSITIONS AS FOLLOWS:
 NORMAL MODE: SWITCH A & C CLOSED
 BYPASS MODE: SWITCH A & B CLOSED
 BYPASS & ISOLATE MODE: SWITCH B CLOSED
8. REFER TO FIM III BOOSTER STATION ELECTRICAL EQUIPMENT LIST 2000-F23-LST-EL-40002 FOR EQUIPMENT AND UPS DETAILS.
9. REFER TO FIM III BOOSTER STATION CABLE SCHEDULE 2000-F23-LST-EL-40003 FOR CABLE DETAILS.

LEGEND

- MCC TERMINAL
- VSD TERMINAL
- FIELD TERMINAL
- PLC OR I/O TERMINAL
- MARSHALLING TERMINAL
- DISTRIBUTION BOARD TERMINAL
- DEVICE TERMINAL
- INDICATION LAMP cc = COLOUR
- DUMMY CIRCUIT BREAKER NOTE 2

AS BUILT

REFERENCES	DWG No	REV	DATE	REVISION	DRN	CHK	TECH APP	APP
FIM III BOOSTER STATION RTU CABINET SCHEMATIC DIAGRAM	2000-F75-SCM-IC-40001							
FIM III BOOSTER STATION 24VDC DISTRIBUTION SCHEMATIC DIAGRAM	2000-F23-SCM-EL-40014							
FIM III BOOSTER STATION DCS CABINET SCHEMATIC DIAGRAM	2000-F23-SCM-IC-40002							
FIM III BOOSTER STATION CONTROL SYSTEM & COMMUNICATIONS BLOCK DIAGRAM	2000-F23-BLK-IC-40001							
F23-DB-601 HV/LV SWITCHROOM AND AREA L&SP DB THREE-LINE DIAGRAM	2000-F23-TLD-EL-40011	1	30.MAR.26	AS BUILT FOR FIM III TSF	[redacted]	MC		
GENERAL NOTES AND STANDARD DRAWING INDEX	2000-F00-SLD-EL-10001	0	17.JAN.25	ISSUED FOR CONSTRUCTION		KVN		

NORTHERN STAR RESOURCES LIMITED

DRA PACIFIC (PTY) LIMITED

[redacted]	T. [redacted] O	02.DEC.2024
CHECKED	[redacted] NAMEN	19.DEC.2024
DESIGNED	[redacted] OOM	20.NOV.2024
TECH APP	[redacted]	20.DEC.2024
[redacted] APP	[redacted]	17.JAN.2025
CLIENT APP		

PROJECT: KCGM
FIM TSF PROJECT

TITLE: FIM III BOOSTER STATION
F23-DB-603 HV/LV SWITCHROOM 240VAC UPS DB
THREE-LINE DIAGRAM

[redacted] SCALE NTS | DRG No. 2000-F23-TLD-EL-40013 | REV 1