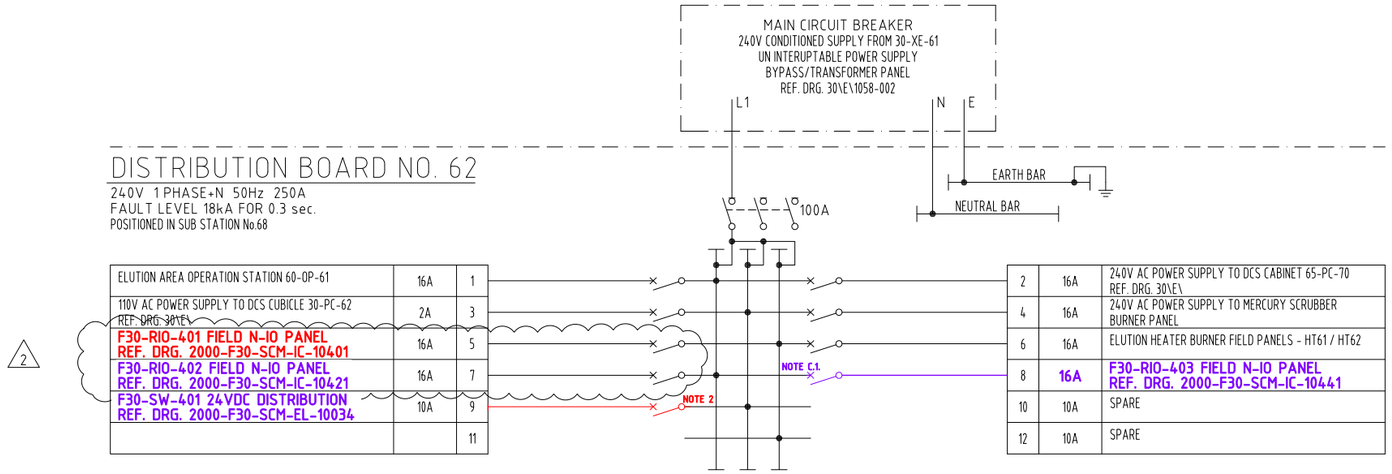


KCGM GROWTH PROJECT CONSTRUCTION NOTES

C.1. INSTALL NEW 16A MCB INTO DISTRIBUTION BOARD SPARE POLE 8.

THIS DRAWING SUPERCEDES 30\E\404

LEGEND

- STAGE 1 - NEW
- STAGE 1 - REMOVE
- STAGE 1 - DECOMMISSIONED (OTHERS)
- STAGE 2 - NEW
- STAGE 2 - REMOVE
- STAGE 2 - DECOMMISSIONED (OTHERS)

KCGM GROWTH PROJECT


DRAWING NO.
2000-F30-TLD-EL-10001

REV	DATE	DESCRIPTION	CHECK	TECH APP
0	07/04/25	APPROVED FOR CONSTRUCTION	[redacted]	DM

LEGEND

LOCATION

SUB STATION 68
30-DB-62

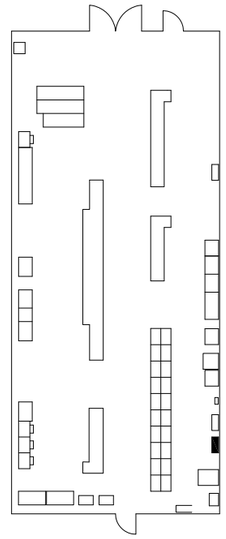

NOTES

1. CIRCUIT BREAKERS SHALL BE TERRASAKI DIN-T 9kA RATED.
2. EXISTING INSTALL (BY OTHERS).

MK	DATE	REVISION	BY	CKD	APP
4	24-6-10	30SW62 POWER SUPPLY ADDED	[redacted]	AM	
3	13-7-06	ELUTION HEATER BURNER PANEL DETAILS ADDED.	[redacted]	SMc	
2	14-2-06	MERCURY SCRUBBER DETAILS ADDED.	[redacted]	SMc	
1	8/97	'AS BUILT' FIMISTON PLANT 1997 CONTRACT# 700746	[redacted]		

REFERENCE DRAWINGS	DWG NO.
SUB STATION No.68 MCC 30-SW-61 SINGLE LINE DIAGRAM SHEET 2	30\E\1058-002
SUB STATION No.68 MCC 30-SW-61 SINGLE LINE DIAGRAM SHEET 1	30\E\1058-001
SUB STATION No.68 MCC 30-SW-61, 62, 63, 64 DRIVE PANEL GENEARL LAYOUT	30\E\1040 - 1043
SUB STATION No.68 MCC AND GENERAL EQUIPMENT LAYOUT	30\E\1039

SCALE	NTS
DRAWN	[redacted] 4/8/97
DESIGNED	[redacted] 4/8/97
CHECKED	
APPROVED	
PROJ.APP	
PROJ. FILE #.	

FIMISTON PLANT
CARBON IN LEACH [redacted] 3)
240V INSTRUMENT DISTRIBUTION [redacted] No.62
POWER SCHEMATIC

SIZE	DRAWING NUMBER	REV
A1	30\E\1045-002	4

KALGOORLIE CONSOLIDATED GOLD MINES PTY. LTD. ACN 009 377 619