
F00-SR-001
PLANT 33kV HV DISTRIBUTION SWITCHROOM

F00-SW-010
PLANT 33kV HV DISTRIBUTION SWITCHBOARD

CONT'D FROM SHEET 3 DRG 2000-F00-SLD-EL-10004

CONT'D ON SHEET 5 DRG 2000-F00-SLD-EL-10006

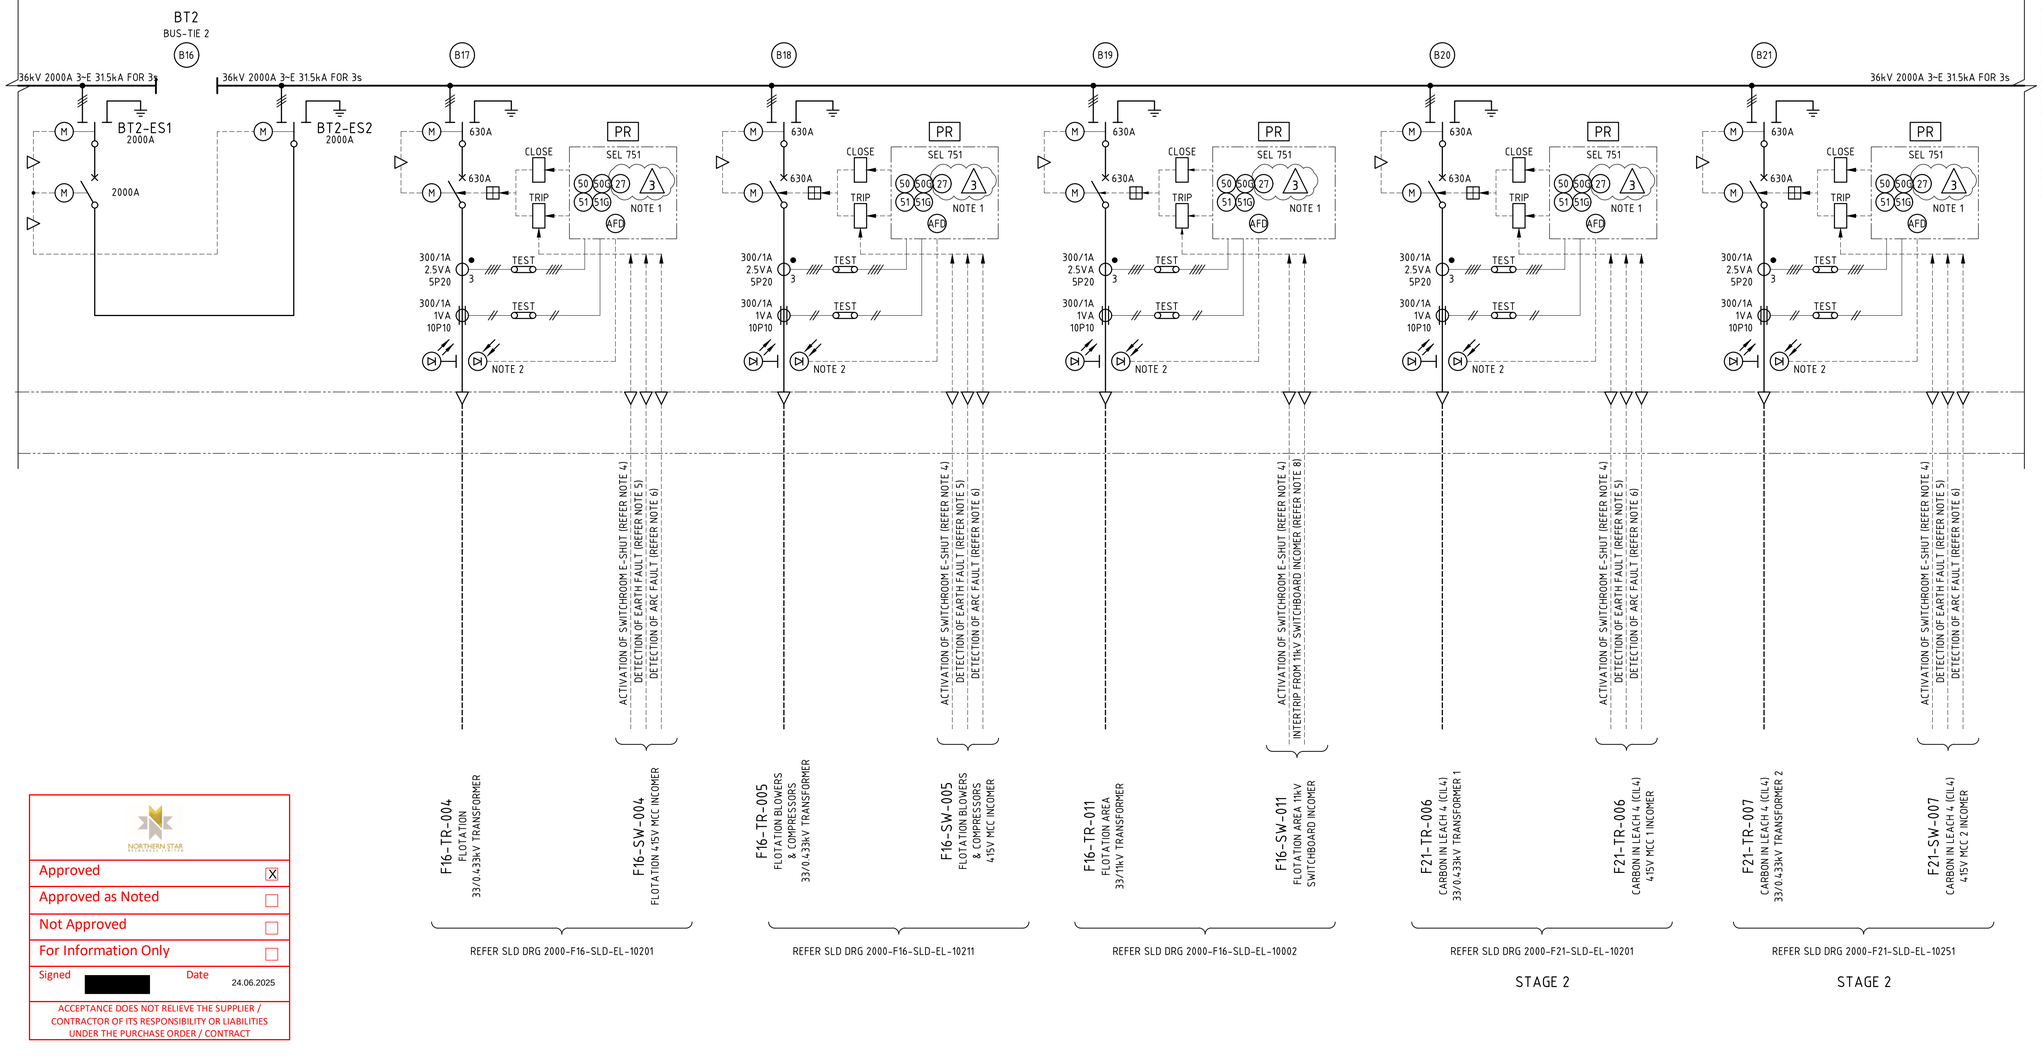


## NOTES

1. THE FEEDER PROTECTION RELAY VOLTAGE INPUT SHALL BE WIRED FROM THE CORRESPONDING INCOMER BUS VT.
2. ARC FLASH POINT DETECTORS SHALL BE PLACED IN CABLE ZONES AND CONNECTED DIRECTLY TO THE SEL PROTECTION RELAYS IN EACH PANEL.
3. SWITCHBOARD SHALL BE EXTENSIBLE FOR FUTURE EXPANSION AND SUPPLIED WITH ONE SPARE TIER PER BUS SECTION AS SHOWN.
4. (3) TRANSFORMER 33KV FEEDER SHALL BE TRIPPED ON THE ACTIVATION OF THE SWITCHROOM EMERGENCY SHUTDOWN (E-SHUT) PUSHBUTTON VIA A CONTACT HARDWIRED DIRECT TO SHUNT TRIP THE CIRCUIT BREAKER.
5. TRANSFORMER 33kV FEEDER SHALL BE TRIPPED ON THE EARTH FAULT DETECTION OF THE DOWNSTREAM MCC INCOMER ACB.
6. TRANSFORMER 33kV FEEDER SHALL BE TRIPPED ON THE ARC FAULT DETECTION OF THE DOWNSTREAM MCC INCOMER ACB.
7. TRANSFORMER INSTRUMENTATION ALARM & TRIP CONTACTS SHALL BE HARDWIRED TO THE TRANSFORMER FEEDER PROTECTION RELAY.
8. THE INTERTRIP OF THE 33kV FEEDER SHALL BE HARDWIRED FROM THE 11kV SWITCHBOARD INCOMER PROTECTION RELAY EITHER ON A TRANSFORMER TRIP, EARTH FAULT DETECTION OR ARC FAULT DETECTION.
9. (3) THE ACTIVATION OF THE PLANT 33KV DISTRIBUTION SWITCHROOM F00-SR-001 EMERGENCY SHUTDOWN (E-SHUT) PUSHBUTTON VIA A CONTACT HARDWIRED DIRECT TO SHUNT TRIP ALL THREE INCOMER CIRCUIT BREAKERS AND THE CORRESPONDING UPSTREAM POLE MOUNTED RECLOSERS.
10. PROTECTION TRIP FROM THE INCOMER CIRCUIT BREAKER SHALL INTERTRIP THE UPSTREAM POLE MOUNTED RECLOSER.

## LEGEND

- PR — INCOMER / FEEDER PROTECTION RELAY NOTES 1 & 2
- PQM — POWER QUALITY AND REVENUE METERING
- ARC FLASH SENSOR (POINT TYPE) NOTE 2
- CAPACITIVE VOLTAGE INDICATION
- MECHANICAL OR ELECTRICAL INTERLOCK DEVICE
- 27 — UNDER-VOLTAGE
- 50 — INSTANTANEOUS OVERCURRENT
- 50G 50N — INSTANTANEOUS EARTH/NEUTRAL OVERCURRENT
- 51 — TIMED OVERCURRENT
- 51G 51N — TIMED EARTH/NEUTRAL OVERCURRENT
- 64 — EARTH FAULT
- 67 67G — DIRECTIONAL OVERCURRENT/EARTH FAULT
- AFD — ARC FLASH DETECTION

NORTHERN STAR RESOURCES LIMITED

| | |
|---|---|
| Approved | X |
| Approved as Noted | |
| Not Approved | |
| For Information Only | |

Signed [redacted] Date 24.06.2025

ACCEPTANCE DOES NOT RELIEVE THE SUPPLIER / CONTRACTOR OF ITS RESPONSIBILITY OR LIABILITIES UNDER THE PURCHASE ORDER / CONTRACT

| DRG No. | REFERENCES |
|---|---|
| 2000-F00-DRG-EL-10001 | F00-SR-001 33kV PLANT HV DISTRIBUTION SWITCHROOM ELECTRICAL EQUIPMENT LAYOUT |
| 2000-F00-DRG-EL-10054 | F00-SW-010 33kV PLANT HV DISTRIBUTION SWITCHBOARD INTERLOCKING SLD SHEET 4 OF 5 |
| 2000-F00-SLD-EL-10006 | F00-SW-010 33kV PLANT HV DISTRIBUTION SWITCHBOARD SINGLE LINE DIAGRAM SHEET 5 |
| 2000-F00-SLD-EL-10004 | F00-SW-010 33kV PLANT HV DISTRIBUTION SWITCHBOARD SINGLE LINE DIAGRAM SHEET 3 |
| 2000-F00-SLD-EL-10001 | OVERALL SITEWIDE SINGLE LINE DIAGRAM |
| 2000-F00-STD-EL-10001 | GENERAL NOTES AND STANDARD DRAWINGS INDEX |

| REV | DATE | DESCRIPTION |
|---|---|---|
| 3 | 30MAY25 | FAT REDLINES INCORPORATED |
| 2 | 24MAY24 | TIER ORDER REVISED. |
| 1 | 05APR24 | TIER ORDER REVISED. REISSUED FOR CONSTRUCTION |
| 0 | 07MAR24 | APPROVED FOR CONSTRUCTION |

| DRAW | CHECK | DESIGN | TECH APP | PROJ APP |
|---|---|---|---|---|
| [redacted] | | | | |

NORTHERN STAR RESOURCES LIMITED

PRIMERO
primero.com.au | DESIGN | CONSTRUCT | OPERATE

PRIMERO PROJECT NUMBER: 23517

INFORMATION AND REPRESENTATIONS ON THIS DRAWING ARE THE INTELLECTUAL PROPERTY OF PRIMERO UNLESS SPECIFICALLY IDENTIFIED OTHERWISE. ALL RIGHTS INCLUDING USE RESERVED

PROJECT: NORTHERN STAR RESOURCES LTD
KCGM GROWTH PROJECT

TITLE: GENERAL FIMISTON SITE
F00-SW-010 33kV SWITCHBOARD
SINGLE LINE DIAGRAM SHEET 4

| SHEET | SCALE | DRG No. | REVISION |
|---|---|---|---|
| A1 | NONE | 2000-F00-SLD-EL-10005 | 3 |

O:\CAD PROJECTS\235 NORTHERN STAR RESOURCES LTD\23517 KCGM GROWTH PROJECT\03 DELIVERABLES\EL\F00 - GENERAL FIMISTON SITE\2000-F00-SLD-EL-10005.DWG 03JUN25 6:30AM SANDRA CULL