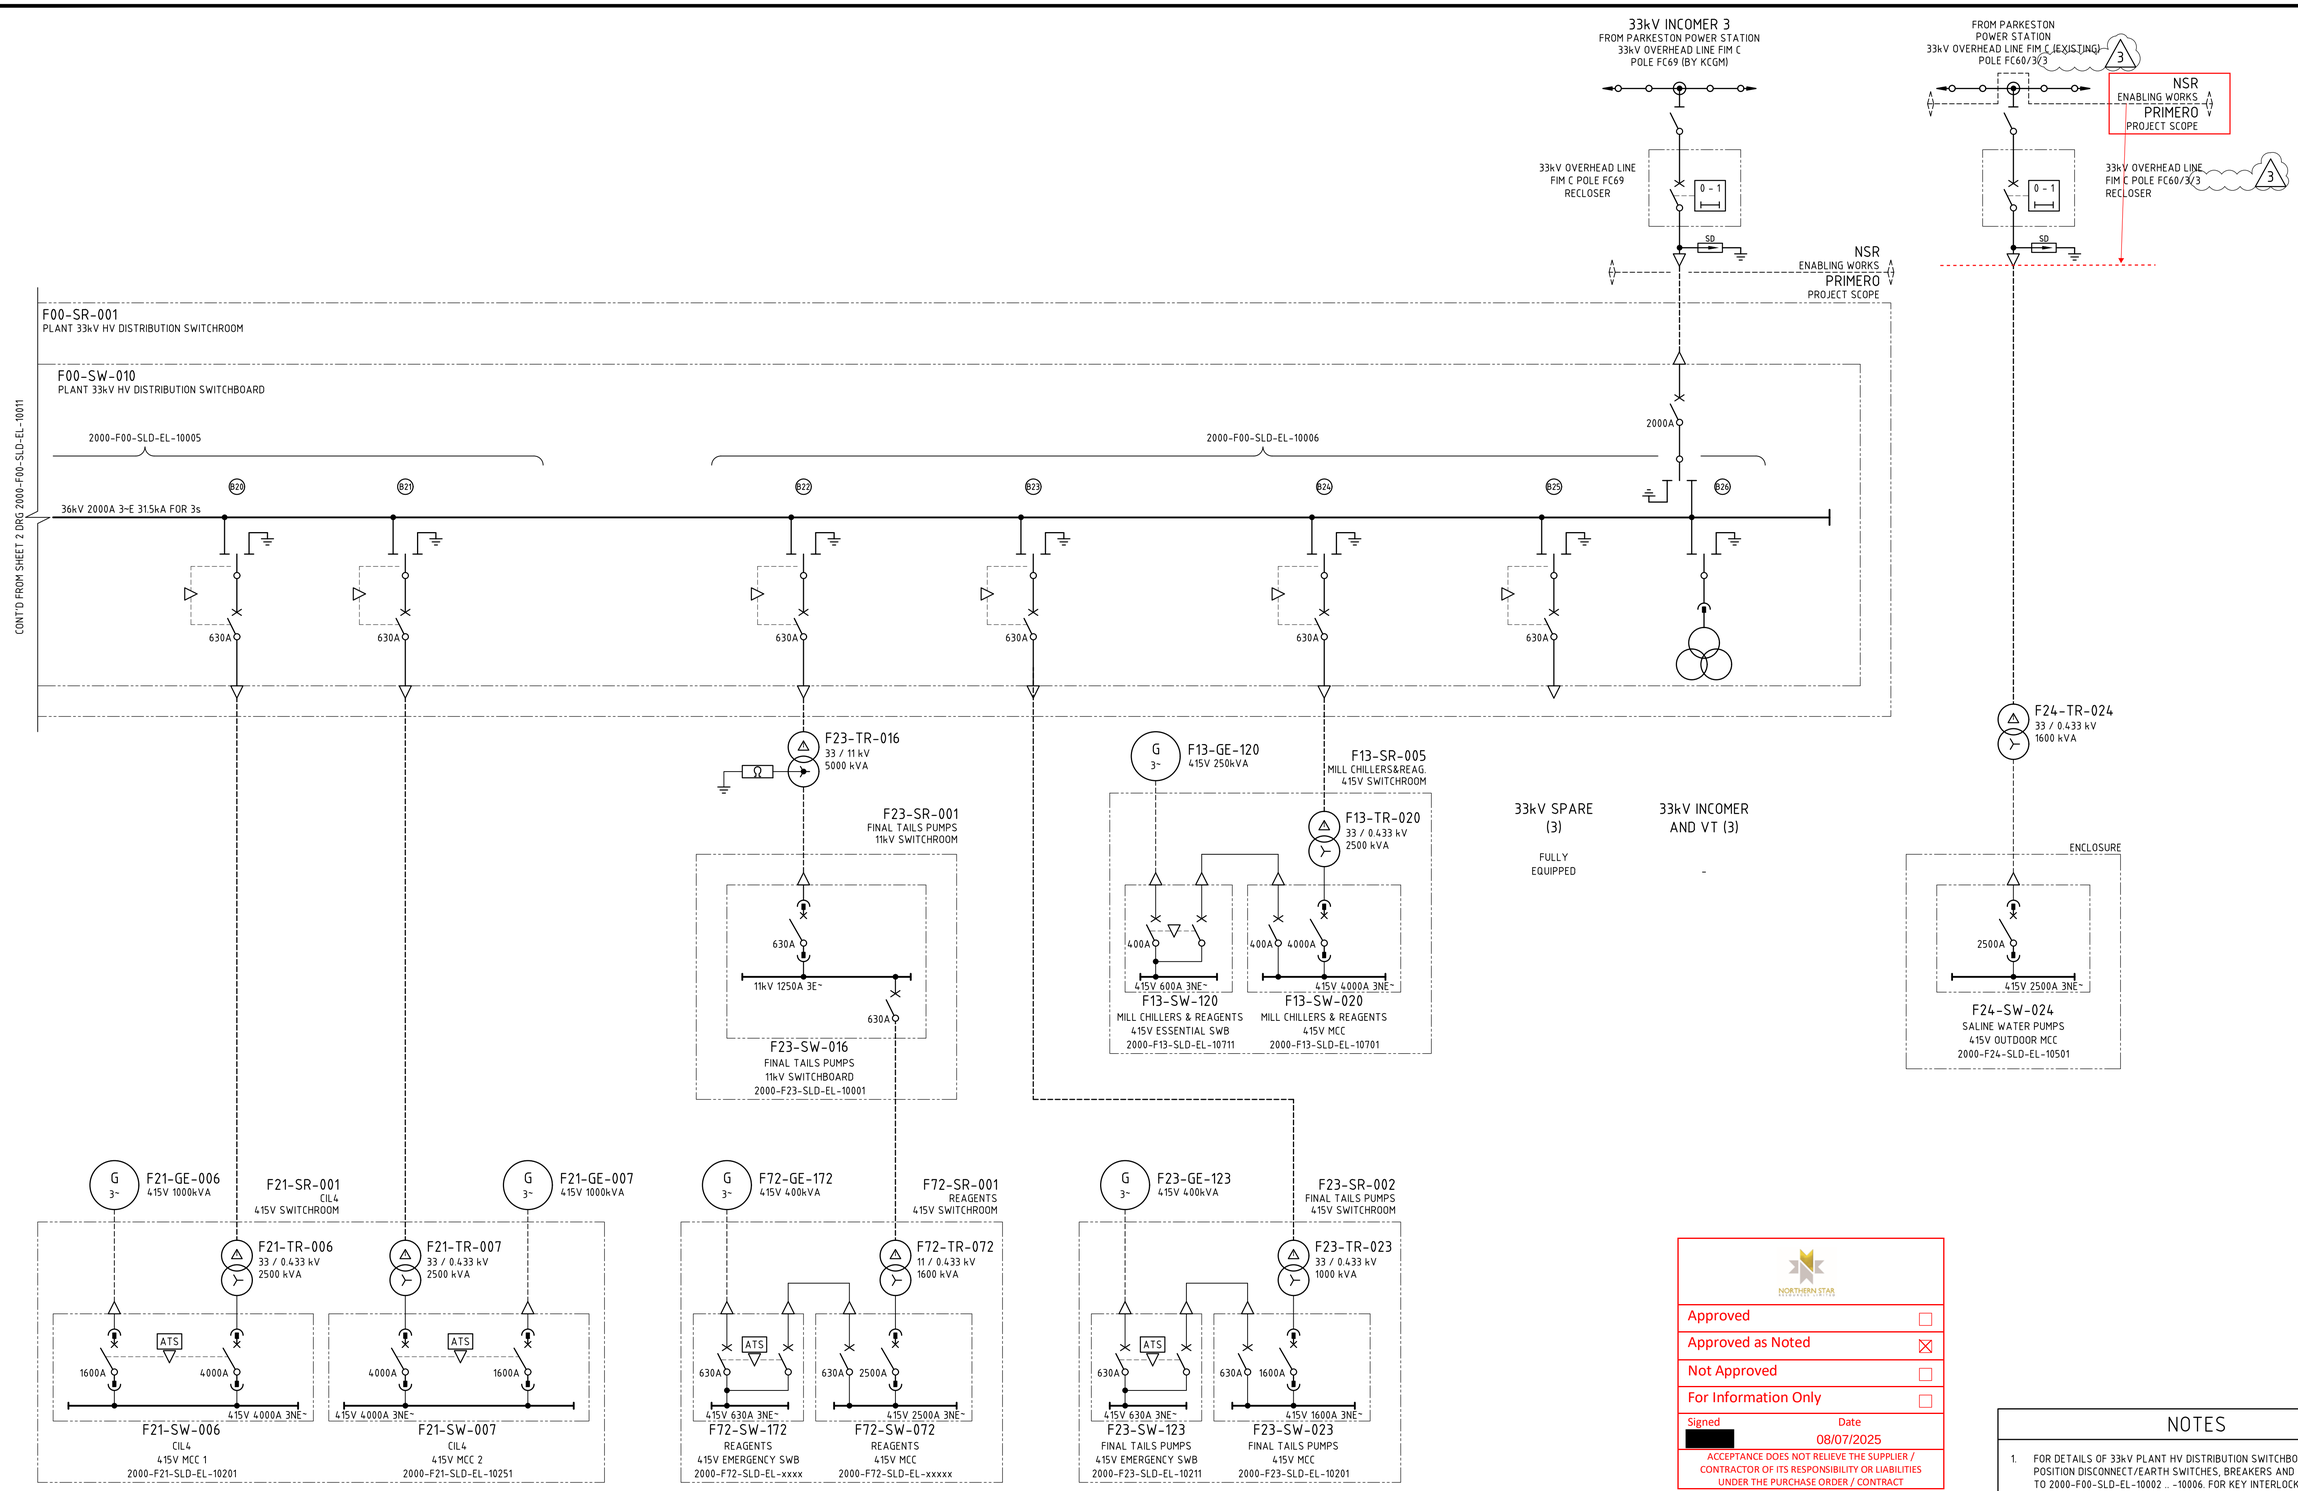


Approved	☐
Approved as Noted	☒
Not Approved	☐
For Information Only	☐
Signed [redacted]	Date 08/07/2025

ACCEPTANCE DOES NOT RELIEVE THE SUPPLIER / CONTRACTOR OF ITS RESPONSIBILITY OR LIABILITIES UNDER THE PURCHASE ORDER / CONTRACT

NOTES

1. FOR DETAILS OF 33kV PLANT HV DISTRIBUTION SWITCHBOARD THREE POSITION DISCONNECT/EARTH SWITCHES, BREAKERS AND BUS TIES REFER TO 2000-F00-SLD-EL-10002 .. -10006. FOR KEY INTERLOCKING, REFER TO KEY INTERLOCKING DIAGRAMS 2000-F00-SLD-EL-10051 .. -10055

DRG No.	REFERENCES
2000-F00-BLK-IC-10001	OVERALL SITEWIDE FIBRE OPTIC COMMUNICATIONS BLOCK DIAGRAM
2000-F00-SLD-EL-10006	F00-SW-010 PLANT 33kV DISTRIBUTION SWITCHBOARD SINGLE LINE DIAGRAM SHEET 5
2000-F00-SLD-EL-10005	F00-SW-010 PLANT 33kV DISTRIBUTION SWITCHBOARD SINGLE LINE DIAGRAM SHEET 4
2000-F00-SLD-EL-10004	F00-SW-010 PLANT 33kV DISTRIBUTION SWITCHBOARD SINGLE LINE DIAGRAM SHEET 3
2000-F00-SLD-EL-10003	F00-SW-010 PLANT 33kV DISTRIBUTION SWITCHBOARD SINGLE LINE DIAGRAM SHEET 2
2000-F00-SLD-EL-10002	F00-SW-010 PLANT 33kV DISTRIBUTION SWITCHBOARD SINGLE LINE DIAGRAM SHEET 1
2000-F00-SLD-EL-10001	OVERALL SITEWIDE 33kV DISTRIBUTION SINGLE LINE DIAGRAM SHEET 1
2000-F00-STD-EL-10001	GENERAL NOTES AND STANDARD DRAWINGS INDEX

REV	DATE	DESCRIPTION	DRAW	CHECK	DESIGN	TECH APP	PROJ APP
3	22JUL25	33kV OVERHEAD LINE POLE NUMBERS REVISED	AD	GD	KT	MB	DM
2	30MAY25	FAT REDLINES INCORPORATED	SC	AD	JL	MB	DM
1	05NOV24	F23-SR-001 REVISED & ADDED F72-SR-001 REAGENTS 415V SWBD	WS	CB	JL	MB	DM
0	26SEP24	APPROVED FOR CONSTRUCTION	KW	CB	KT	MB	DM

NORTHERN STAR RESOURCES LIMITED

PRIMERO
primero.com.au | DESIGN | CONSTRUCT | OPERATE

PRIMERO PROJECT NUMBER: 23517

INFORMATION AND REPRESENTATIONS ON THIS DRAWING ARE THE INTELLECTUAL PROPERTY OF PRIMERO UNLESS SPECIFICALLY IDENTIFIED OTHERWISE. ALL RIGHTS INCLUDING USE RESERVED

PROJECT: NORTHERN STAR RESOURCES LTD
KCGM GROWTH PROJECT

TITLE: GENERAL FIMISTON SITE
OVERALL SITEWIDE 33kV DISTRIBUTION
SINGLE LINE DIAGRAM SHEET 3

SHEET	SCALE	DRG No.	REVISION
A1	NONE	2000-F00-SLD-EL-10012	3

O:\CAD PROJECTS\235 NORTHERN STAR RESOURCES LTD\23517 KCGM GROWTH PROJECT\03 DELIVERABLES\EL\F00 - GENERAL FIMISTON SITE\2000-F00-SLD-EL-10012.DWG 22JUL25 12:17PM ANTONY.DECAPRIO