
F13-SR-005
415V MILL CHILLERS & REAGENTS SWITCHROOM

F13-SW-020
MILL CHILLERS & REAGENTS 415V MOTOR CONTROL CENTRE

CONTINUED ON SHT 2
2000-F13-SLD-EL-10702

CONTINUED ON SHT 4
2000-F13-SLD-EL-10704

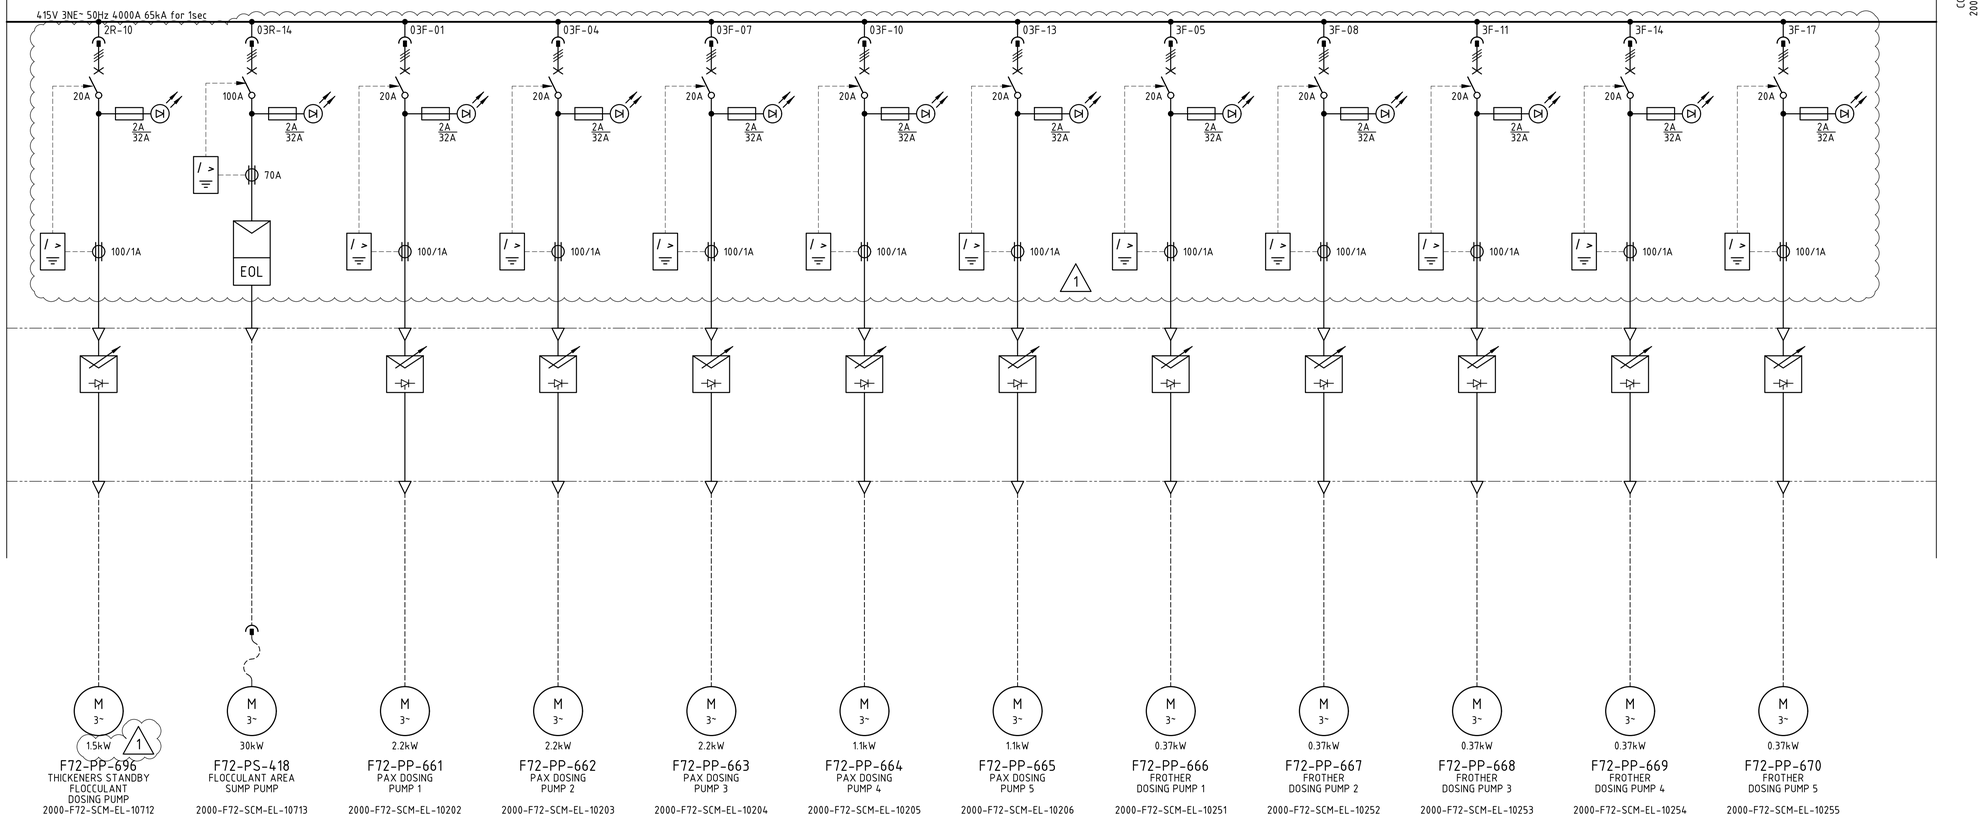

NOTES

1. REFER TO SHEET 1.

LEGEND

1. REFER TO SHEET 1.

NORTHERN STAR RESOURCES LIMITED

Approved	X
Approved as Noted	
Not Approved	
For Information Only	

Signed [redacted] Date 24.06.2025

ACCEPTANCE DOES NOT RELIEVE THE SUPPLIER / CONTRACTOR OF ITS RESPONSIBILITY OR LIABILITIES UNDER THE PURCHASE ORDER / CONTRACT

DRG No.	REFERENCES
2000-F13-SCM-EL-10703	F13-SW-020 415V MCC ARC FLASH SYSTEM SCHEMATIC DIAGRAM
2000-F13-SCM-EL-10702	F13-SW-020 415V MCC 24VDC DISTRIBUTION SCHEMATIC DIAGRAM
2000-F13-SCM-EL-10701	F13-SW-020 415V MCC INCOMER SCHEMATIC DIAGRAM
2000-F13-DRG-EL-10121	F13-SR-005 415V SWITCHROOM ELECTRICAL EQUIPMENT LAYOUT
2000-F13-BLK-EL-10341	F13-SR-005 415V SWITCHROOM AND REMOTE I/O COMMUNICATIONS BLOCK DIAGRAM
2000-F13-SLD-EL-10701	F13-SW-020 415V MCC SINGLE LINE DIAGRAM SHEET 1
2000-F00-SLD-EL-10002	F00-SW-010 33kV SWITCHBOARD SINGLE LINE DIAGRAM SHEET 1 OF 5
2000-F00-STD-EL-10001	GENERAL NOTES AND STANDARD DRAWINGS INDEX

REV	DATE	DESCRIPTION	DRAW	CHECK	DESIGN	TECH APP	PROJ APP
1	29MAY25	FAT REDLINES INCORPORATED	[redacted]				
0	25MAR24	APPROVED FOR CONSTRUCTION					

NORTHERN STAR RESOURCES LIMITED

PRIMERO
primero.com.au | DESIGN | CONSTRUCT | OPERATE

PRIMERO PROJECT NUMBER: 23517

INFORMATION AND REPRESENTATIONS ON THIS DRAWING ARE THE INTELLECTUAL PROPERTY OF PRIMERO UNLESS SPECIFICALLY IDENTIFIED OTHERWISE. ALL RIGHTS INCLUDING USE RESERVED

PROJECT: NORTHERN STAR RESOURCES LTD
KCGM GROWTH PROJECT

TITLE: MILLING & CLASSIFICATION
F13-SW-020 415V MCC
SINGLE LINE DIAGRAM SHEET 3

SHEET	SCALE	DRG No.	REVISION
A1	NONE	2000-F13-SLD-EL-10703	1

O:\CAD PROJECTS\235 NORTHERN STAR RESOURCES LTD\23517 KCGM GROWTH PROJECT\03 DELIVERABLES\EL\F13 - MILLING & CLASSIFICATION\2000-F13-SLD-EL-10703.DWG 30MAY25 8:08AM SANDRA CULL