
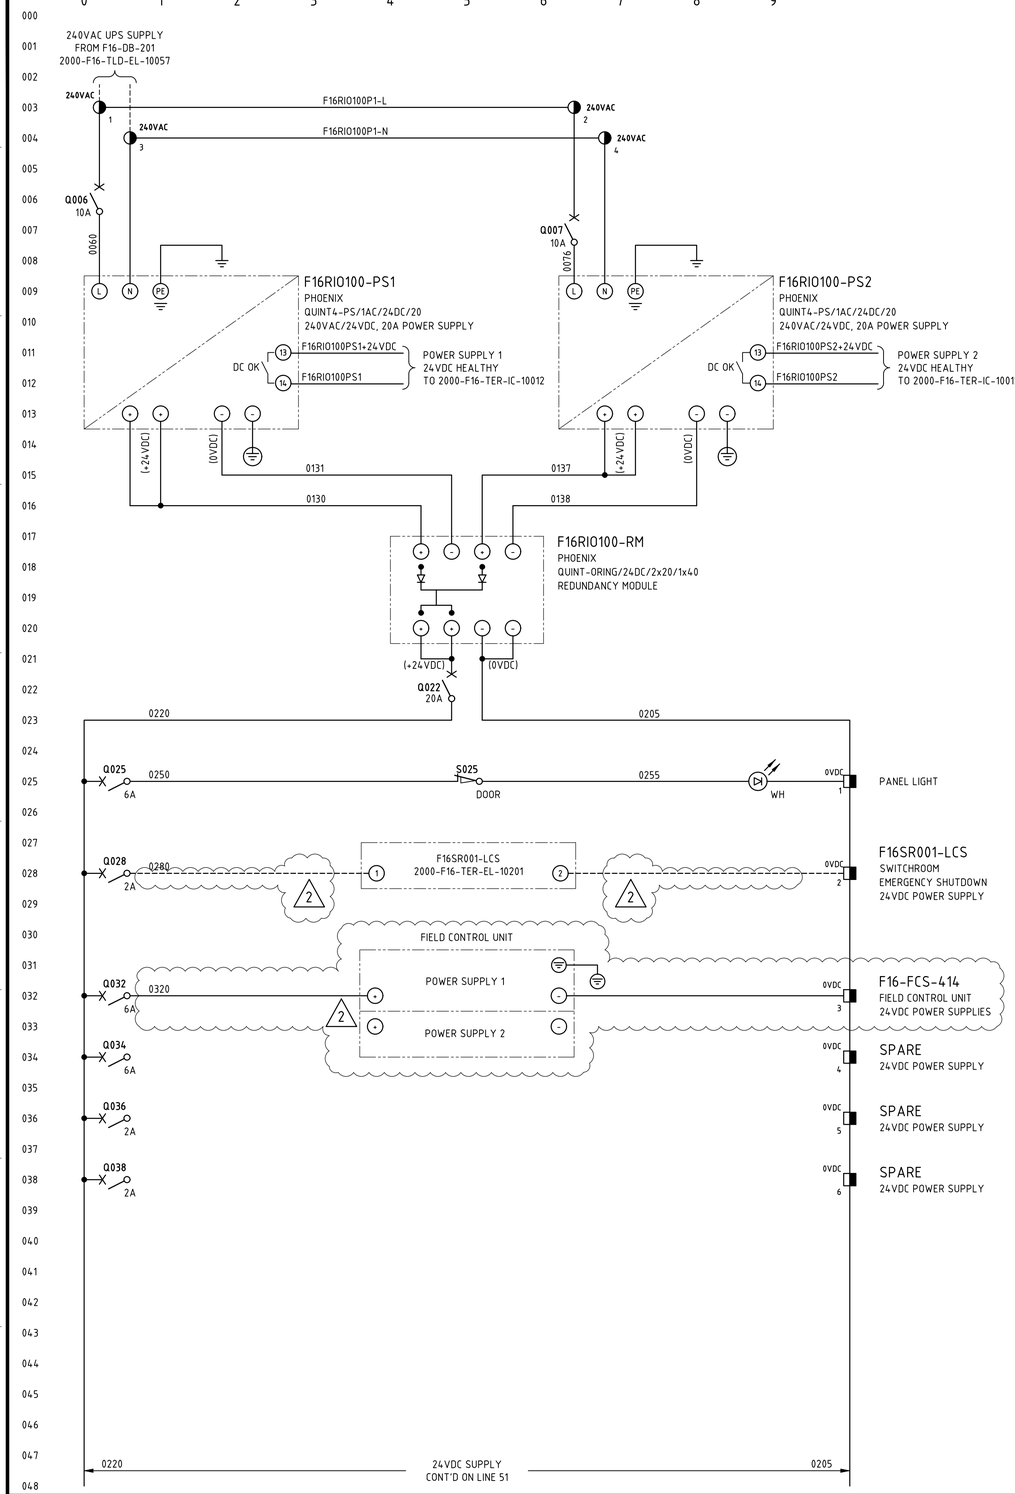


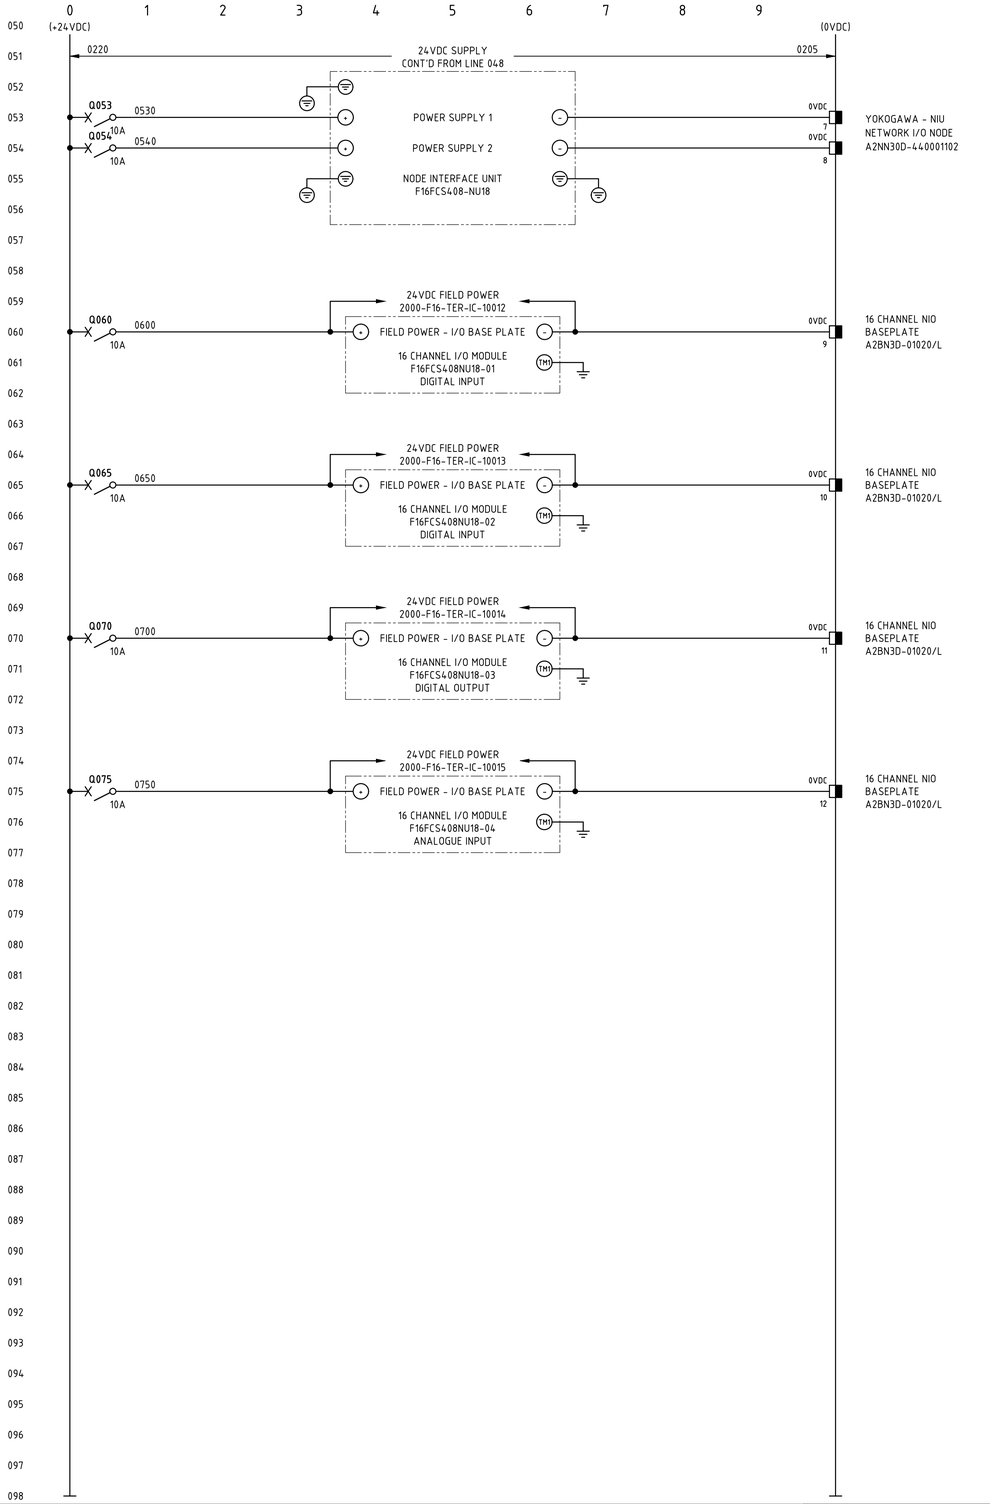

NOTES

1. TERMINALS ON TERMINAL STRIPS ABOVE 50VAC SHALL HAVE A SEPARATE PERSPEX SHROUD AND SHALL BE LABELLED "DANGER xxxVAC".
2. WIRE NUMBER FERRULES ON TERMINAL STRIP SHALL BE PREFIXED WITH EQUIPMENT NUMBER e.g. F16RIO100-xxxx.
3. EACH WIRE SHALL BE IDENTIFIED AT BOTH ENDS WITH FERRULES.
4. FOR NETWORK CONNECTION & BUS CABLING DETAILS REFER TO RIO PANEL COMMUNICATIONS TERMINATION DIAGRAMS.
5. INSTRUMENT EARTH BAR TO BE BONDED TO MAIN EARTH BAR WITH SOLID COPPER LINK.

LEGEND

- FIELD TERMINAL
- DCS OR I/O TERMINAL
- 0VDC TERMINAL FOR 24VDC (2)
- DEVICE TERMINAL
- EARTH BAR
- INSTRUMENT EARTH BAR

NIO BASEPLATE

DRG No.	REFERENCES
2000-F16-TLD-EL-10057	F16-SR-001 11KV SWITCHROOM 415VAC UPS F16-DB-201 THREE LINE DIAGRAM
2000-F16-DRG-IC-10011	F16-RIO-100 11KV SWITCHROOM N-IO PANEL GENERAL ARRANGEMENT
2000-F16-TER-IC-10011	F16-RIO-100 11KV SWITCHROOM N-IO PANEL COMMUNICATIONS TERMINATION DIAGRAM
2000-F16-TER-IC-10012	F16-RIO-100 11KV SWITCHROOM N-IO PANEL TERMINATION DIAGRAM SHEET 1 (TO SHEET 3 - 10014)
2000-F16-STD-EL-10001	GENERAL NOTES AND STANDARD DRAWINGS INDEX

REV	DATE	DESCRIPTION
2	13JUN25	FAT REDLINES INCORPORATED - FCS POWER SUPPLY ADDED
1	12DEC24	REVISED E-SHUT LCS
0	10OCT24	APPROVED FOR CONSTRUCTION

DRAW	CHECK	DESIGN	TECH APP	PROJ APP
[redacted]				

NORTHERN STAR RESOURCES LIMITED

PRIMERO
primero.com.au | DESIGN | CONSTRUCT | OPERATE

PRIMERO PROJECT NUMBER: 23517

INFORMATION AND REPRESENTATIONS ON THIS DRAWING ARE THE INTELLECTUAL PROPERTY OF PRIMERO UNLESS SPECIFICALLY IDENTIFIED OTHERWISE. ALL RIGHTS INCLUDING USE RESERVED

PROJECT: NORTHERN STAR RESOURCES LTD
KCGM GROWTH PROJECT

TITLE: ROUGHER & SCAVENGER FLOTATION - F16-SR-001
F16-RIO-100 11KV SWITCHROOM N-IO PANEL
SCHEMATIC DIAGRAM

SHEET	SCALE	DRG No.	REVISION
A1	NONE	2000-F16-SCM-IC-10011	2

O:\CAD PROJECTS\235 NORTHERN STAR RESOURCES LTD\23517 KCGM GROWTH PROJECT\03 DELIVERABLES\IC\F16 - ROUGHER & SCAVENGER FLOTATION\2000-F16-SCM-IC-10011.DWG 14-JUL-25 10:24 AM ANTONY.DECAPRIO