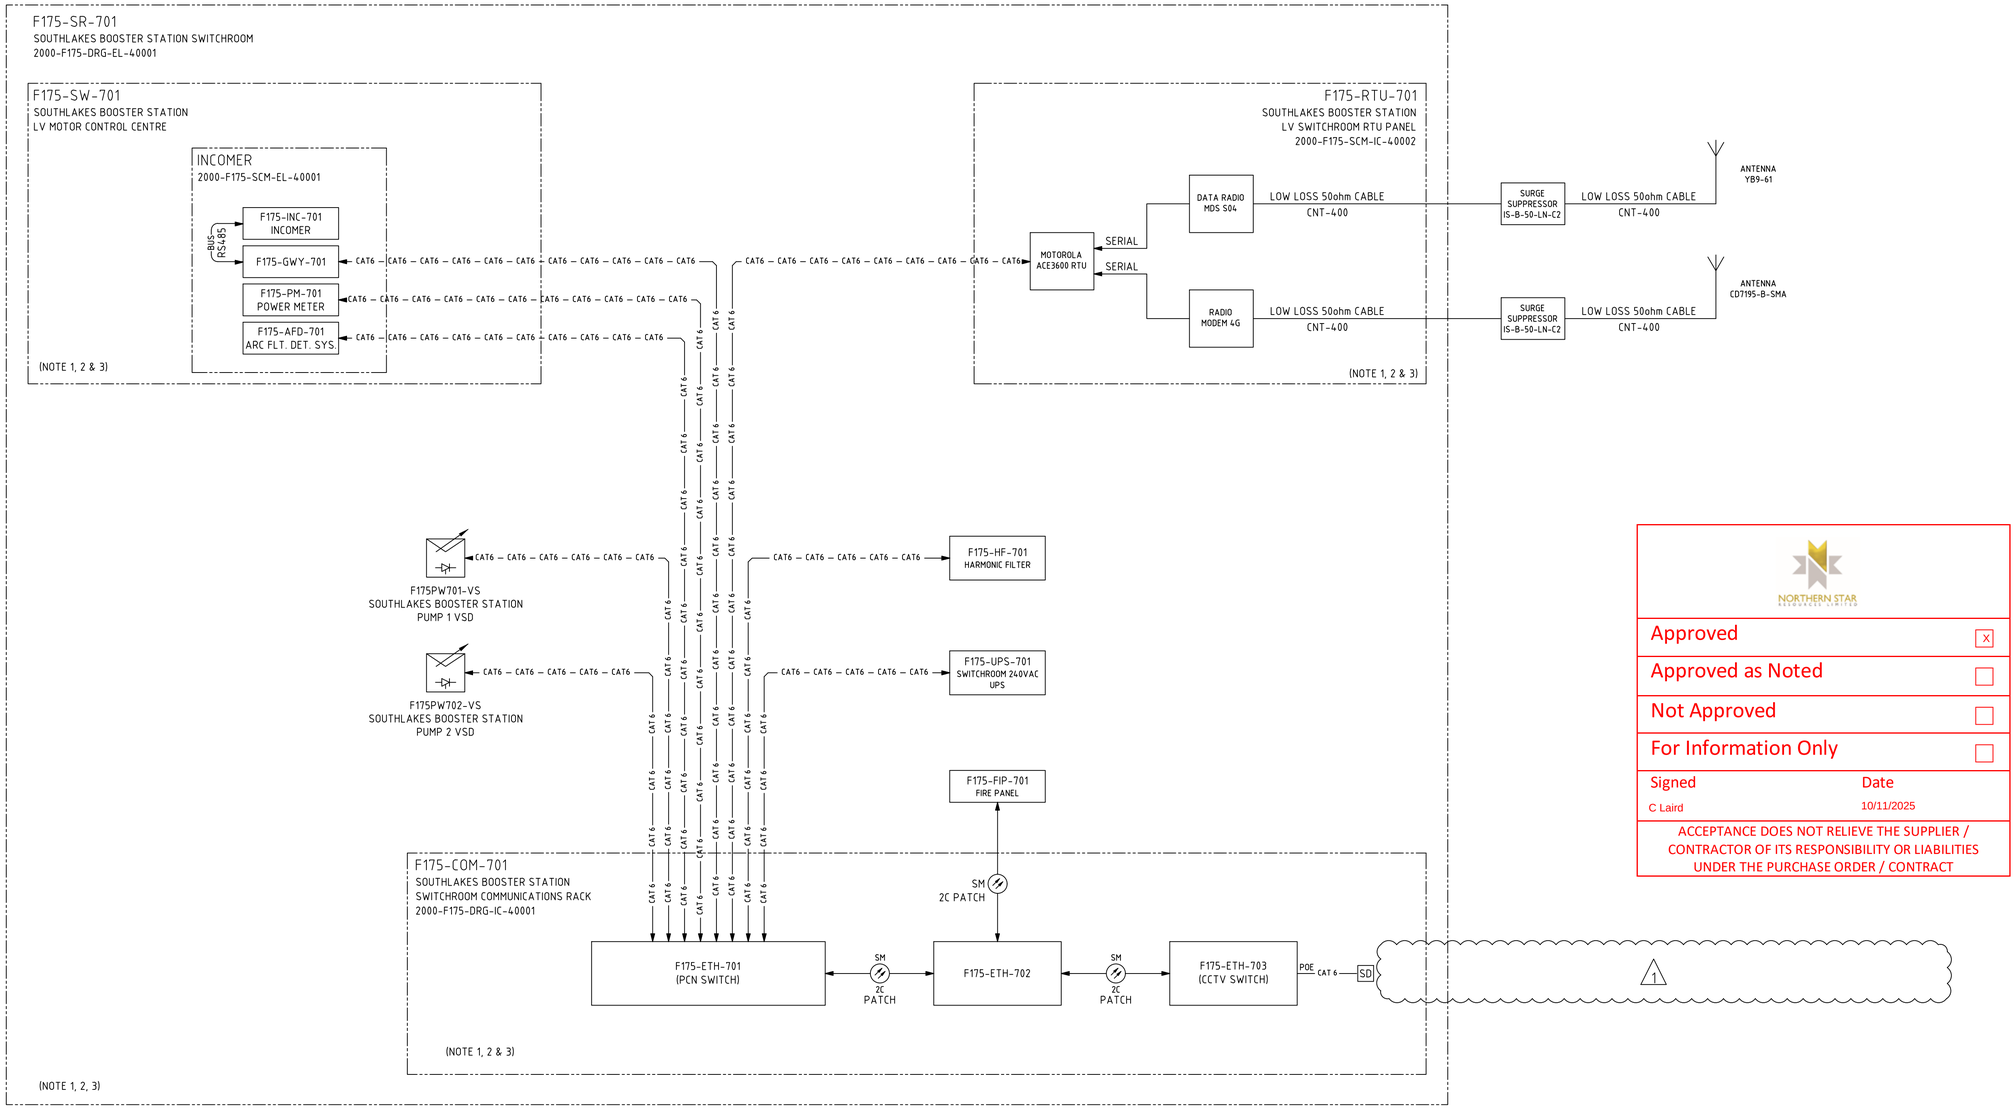



## NOTES

1. FOR INTERNAL FIBRE OPTIC, CAT6 PATCH LEAD (& STACK CABLING IN SWITCHROOM COMMS CABINETS) EQUIPMENT CONNECTION DETAILS REFER TO SPECIFIC TERMINATION DIAGRAMS.
2. REFER TO SPECIFIC COMMUNICATIONS TERMINATION DRAWINGS FOR EXTERNAL EQUIPMENT CONNECTION DETAIL.
3. COMMS CABINET, RTU PANEL, MCC & SWITCHBOARD HARDWARE/INTERCONNECTIONS (E.G. NIO NODE) & INTER-FOBOT PATCHING NOT SHOWN FOR CLARITY. REFER TO SPECIFIC COMMUNICATIONS TERMINATION DRGS FOR DETAIL.
4. CABLES RUN INDIVIDUALLY, REFER TO CABLE SCHEDULE 2000-F175-LST-EL-40003.

## LEGEND

- FOB — FIBRE OPTIC BREAK OUT TRAY
- ETH — ETHERNET SWITCH HIRSCHMANN = DCS NETWORKS CISCO = ALL OTHER NETWORKS
- FCS — YOKOGAWA FIELD CONTROL UNIT
- xxxFCS4xx-NJxx [U/D] — YOKOGAWA NODE INTERFACE UNIT (DUAL OPTICAL ESB PORTS: U = UPLINK, D = DOWNLINK) TAG RELATED TO PARENT FCS
- GWY — COMMUNICATIONS GATEWAY ANYBUS ABC3028
- MC — FIBRE TO CAT6 MEDIA CONVERTER
- xxx — EQUIPMENT OR VENDOR PACKAGE PANELS AS NOTED WITHIN BLOCK.
- EOL — MCC MODULE DOL INTELLIGENT ELECTRONIC DEVICE/OVERLOAD
- UPS — UNINTERRUPTIBLE POWER SUPPLY
- VSD - VARIABLE SPEED DRIVE
- MULTI CORE FIBRE OPTIC CABLE OR DUPLEX PATCH LEAD
- CAT6 – CAT6 — CAT6 ETHERNET CABLE CONNECTION
- xxx-CAM-xxx PTZ — CCTV CAMERA; Z = FIXED (ZOOM ONLY); PTZ = PAN/TILT/ZOOM
- SD — COMMS SURGE DIVERTER DEVICE
- POE — POWER OVER ETHERNET PORT

NORTHERN STAR RESOURCES LIMITED

| | |
|---|---|
| Approved | X |
| Approved as Noted | |
| Not Approved | |
| For Information Only | |

Signed: C Laird — Date: 10/11/2025

ACCEPTANCE DOES NOT RELIEVE THE SUPPLIER / CONTRACTOR OF ITS RESPONSIBILITY OR LIABILITIES UNDER THE PURCHASE ORDER / CONTRACT

APPROVED FOR CONSTRUCTION

| REFERENCES | DWG No | REV | DATE | REVISION | DRN | CHK | TECH APP | APP |
|---|---|---|---|---|---|---|---|---|
| GENERAL NOTES AND STANDARD DRAWINGS INDEX | 2000-F00-STD-EL-10001 | 1 | 22.OCT.25 | RE-APPROVED FOR CONSTRUCTION | TG | DS | DS | DS |
| | | 0 | 15.MAY.25 | APPROVED FOR CONSTRUCTION | | | | |

NORTHERN STAR RESOURCES LIMITED

DRA PACIFIC (PTY) LIMITED

| | | |
|---|---|---|
| [redacted] | T.GROOM | 13.MAR.2025 |
| CHECKED | C. BUBB | 14.APR.2025 |
| DESIGNED | C. BUBB | 14.APR.2025 |
| TECH APP | K. VAN NAMEN | 14.APR.2025 |
| [redacted] APP | T HAMDORF | 15.MAY.2025 |
| CLIENT APP | | |

PROJECT: KCGM FIM TSF PROJECT

TITLE: SOUTHLAKES BOOSTER STATION F175-SR-701 LV SWITCHROOM COMMUNICATIONS BLOCK DIAGRAM

A1 | SCALE NTS | DRG No. 2000-F175-BLK-IC-40001 | REV 1