02F 1 | 01F 1 | 00F 1 | 1F 1 | 1F 2 | 2F 1 | 2F 2

415V 3 PHASE 50Hz 2500A FORM 4 FAULT LEVEL 50kA FOR 1 sec.

INTEGRAL C.B. 800A

INTEGRAL C.B. 1000A

2500/5 3

S A 0-3000A

kW / mA 4-20mA TO PROCESS CONTROL CUBICLE

6A S V 0-500V

AFS

INTEGRAL C.B. 3200A

VAMP 221 ARC FLASH RELAY NOTE 1

NEUTRAL EARTH 500/5

ROGOWSKI COILS

INTERTRIP FROM 66SW62

NOTE 2

INTEGRAL C.B. ~~630A~~ 400A

10A

INTEGRAL C.B. 630A (BY OTHERS)

415/110V 3000VA A N

10A 32A L1 N1 32A L1 N1

35-CP-62 30-PC-61

CONTINUED ON DRAWING 20\E\0403

20-CP-41
MAIN C/B & RECLOSER REMOTE ISOLATION
DWG. 20\E\1142-003

20-TR-62
33kV/433V
1500 kVA
Dyn11

HV EARTH SUBSTATION MV EARTH BAR EARTH GRID

F66-SW-402

20-SW-01
SUB 5 415V SUPPLY
MCC 20-SW-01 FEEDER
REF. DWG. 20\E\0805-002

66-SW-62
FEEDER TO MCC
REF. DWG. ?

TO SOUTH SWITCHYARD (E1)
80-CB-45 RECLOSER
REF. DWG. 180\E\3045

11

33kV 3Ph SUPPLY
FROM SOUTH SWITCHYARD (E1)
80-CB-45 RECLOSER
REF. DWG. 180\E\3045

~~SPARE~~
~~415V SUPPLY~~
~~SPARE~~
~~REF DWG.?~~

F66-SW-402
415V SUPPLY
2000-F66-SLD-EL-10101

110V SUPPLY FED TEIR 2F\2
REF. DWG. 20\E\1403

MCC 110V SUPPLY
REF. DWG. 20\E\

PROCESS CONTROL CUBICLE
30-PC-61
REF. DWG. 20\E\1422

SPARE

CONTROL TRANSFORMER SUPPLY
FED FROM TEIR 3F\6

110V SUPPLY TO 35-CP-62
FED TO TEIR 1F/2
REF. DWG. 20\E\0402

02R 1 | 01R 1 | 0R 1 | 1R 1 | 2R 1

415V 3 PHASE 50Hz 2500A FORM 4 FAULT LEVEL 50kA FOR 1 sec.

CONTINUED ON DRAWING 20\E\0403

AFS

REAR OF FEEDER 20-SW-01

REAR OF FEEDER 66-SW-62

REAR OF INCOMER

REAR OF FEEDER 66-SW-62

REAR OF FEEDER 66-SW-62

NORTHERN STAR RESOURCES LIMITED

Approved [X]

Approved as Noted [ ]

Not Approved [ ]

For Information Only [ ]


Signe [redacted] 7/04/25

ACCEPTANCE DOES NOT RELIEVE THE SUPPLIER / CONTRACTOR OF ITS RESPONSIBILITY OR LIABILITIES UNDER THE PURCHASE ORDER / CONTRACT

LEGEND

LOCATION

SUB STATION 35
20-SW-62

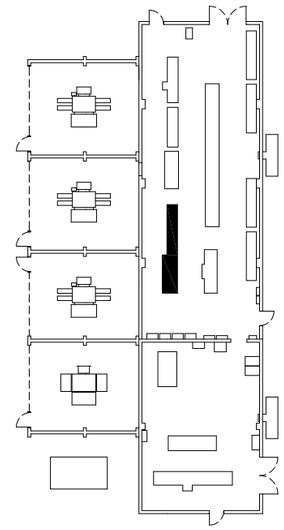

NOTES

1. ALL AFS (ARC FLASH SENSORS) ARE CONNECTED TO THE ARC FLASH RELAY VIA I/O UNITS
2. TIER 1F SPARE FEEDER RE-PURPOSED FOR KCGM GROWTH PROJECT. MCCB TRIP UNIT TO BE SET AT 400A.

LEGEND
- STAGE 1 - NEW
- STAGE 1 - REMOVE
- STAGE 1 - DECOMMISSIONED (OTHERS)
- STAGE 2 - NEW
- STAGE 2 - REMOVE
- STAGE 2 - DECOMMISSIONED (OTHERS)

KCGM GROWTH PROJECT

DRAWING NO. 2000-F20-SLD-EL-10102

REV	DATE	DESCRIPTION	CHECK	TECH APP
0	14/03/25	APPROVED FOR CONSTRUCTION	[redacted]	MB/DM

MK	DATE	REVISION	BY	CKD	APP
10	16/08/19	2019 S.L.D. UPDATE PROJECT "AS BUILT"	BH	RH	EB
9	19/06/19	2019 S.L.D UPDATE PROJECT " AS BUILT "	[redacted]	RH	[redacted]
8	13/11/17	ARC FLASH SENSOR INSTALLED		JMR	
7	08/10/15	GOLD ROOM RETORT INSTALLATION		JM	
6	21/07/14	APPROVED FOR CONSTRUCTION		HY	MD/JM
5A	17/06/14	TIER 2F-1 REVISED TO FEED 66-SW-62 INCOMER		SE	WJ/JM

MK	DATE	REVISION	BY	CKD	APP
5	10/12/98	AS BUILT & REDRAWN TO KCGM STANDARDS	CV		
4	4/95	20-SW-01, 66-SW-61 CB SWAP	[redacted]		
3	11/94	AS BUILT - PERTH		JAM	[redacted]
2	9/94	REVISED AS NOTED		JAM	[redacted]
11	26/10/21	RECLOSER PROJECT AS BUILT		RH	MM
0	7/94	APPROVED FOR TENDER	[redacted]	JAM	

REFERENCE DRAWINGS | DWG NO.

SCALE	NTS		
DRAWN	[redacted]	1994	
DESIGNED		1994	
CHECKED		1994	
APPROVED	MRD/JM	03/07/14	
PROJ.APP	MINPROC	1994	
PROJ. FILE #.			

FIMISTON PLANT
FIMISTON RECYCLE CRUSHING
SUBSTATION No.35 415V MCC 20-SW-62
SINGLE LINE DIAGRAM SHEET 1

[redacted] | DRAWING NUMBER | REV
A1 | 20\E\0402 | 11

KALGOORLIE CONSOLIDATED GOLD MINES PTY. LTD. ABN 009 377 619 003