
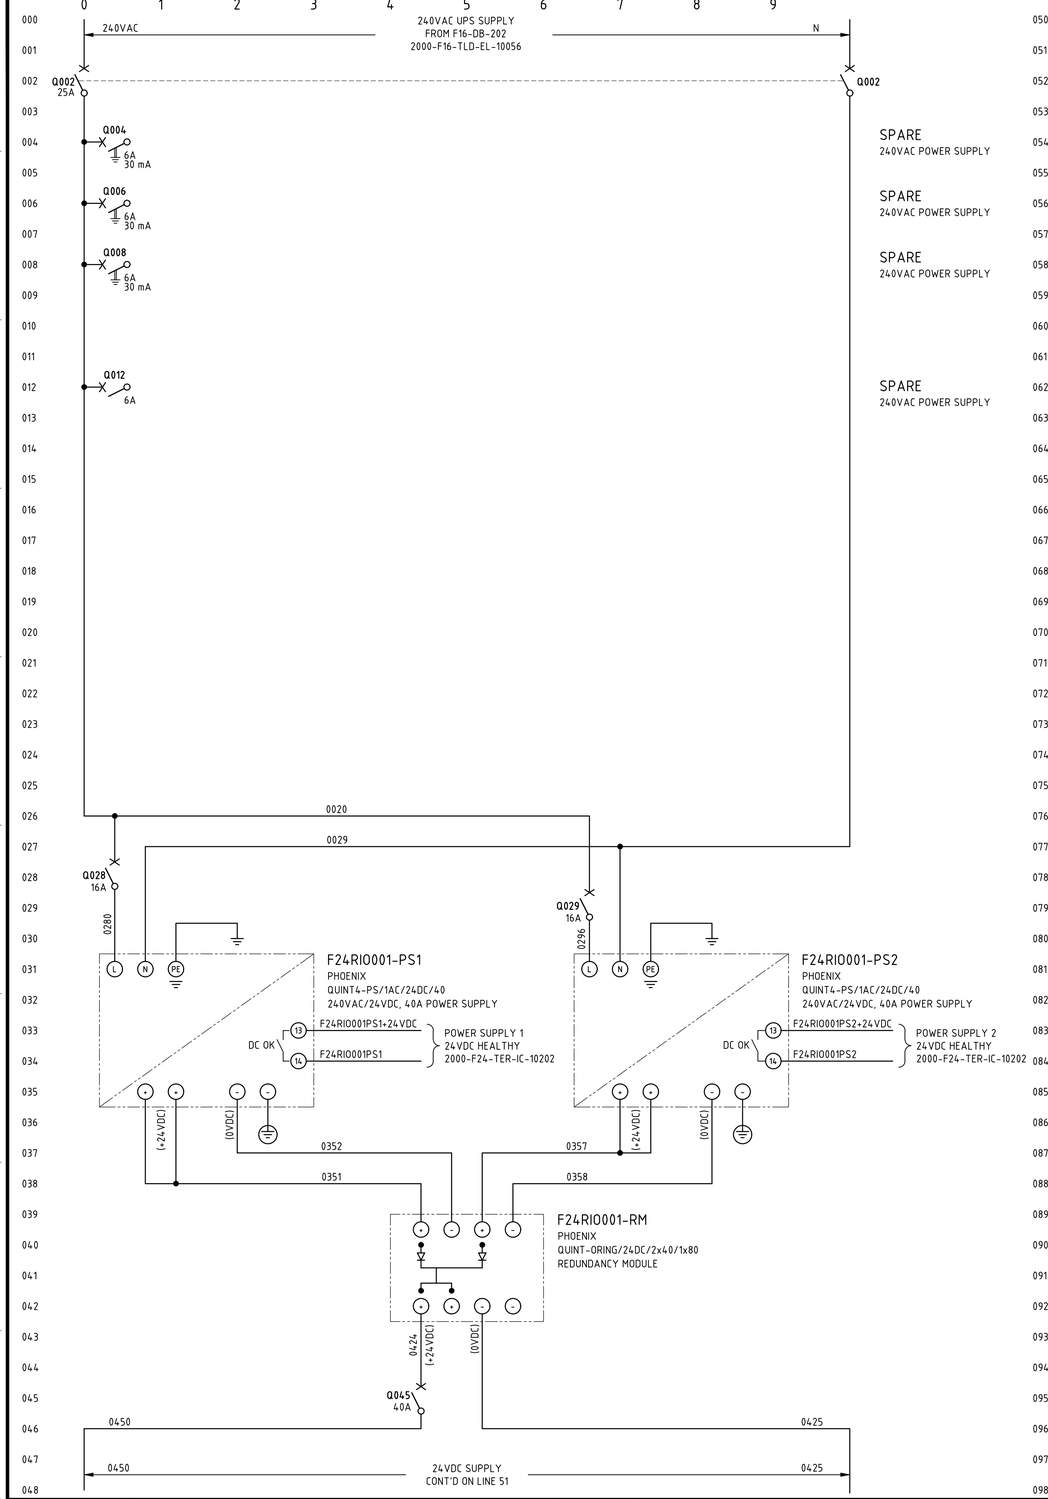


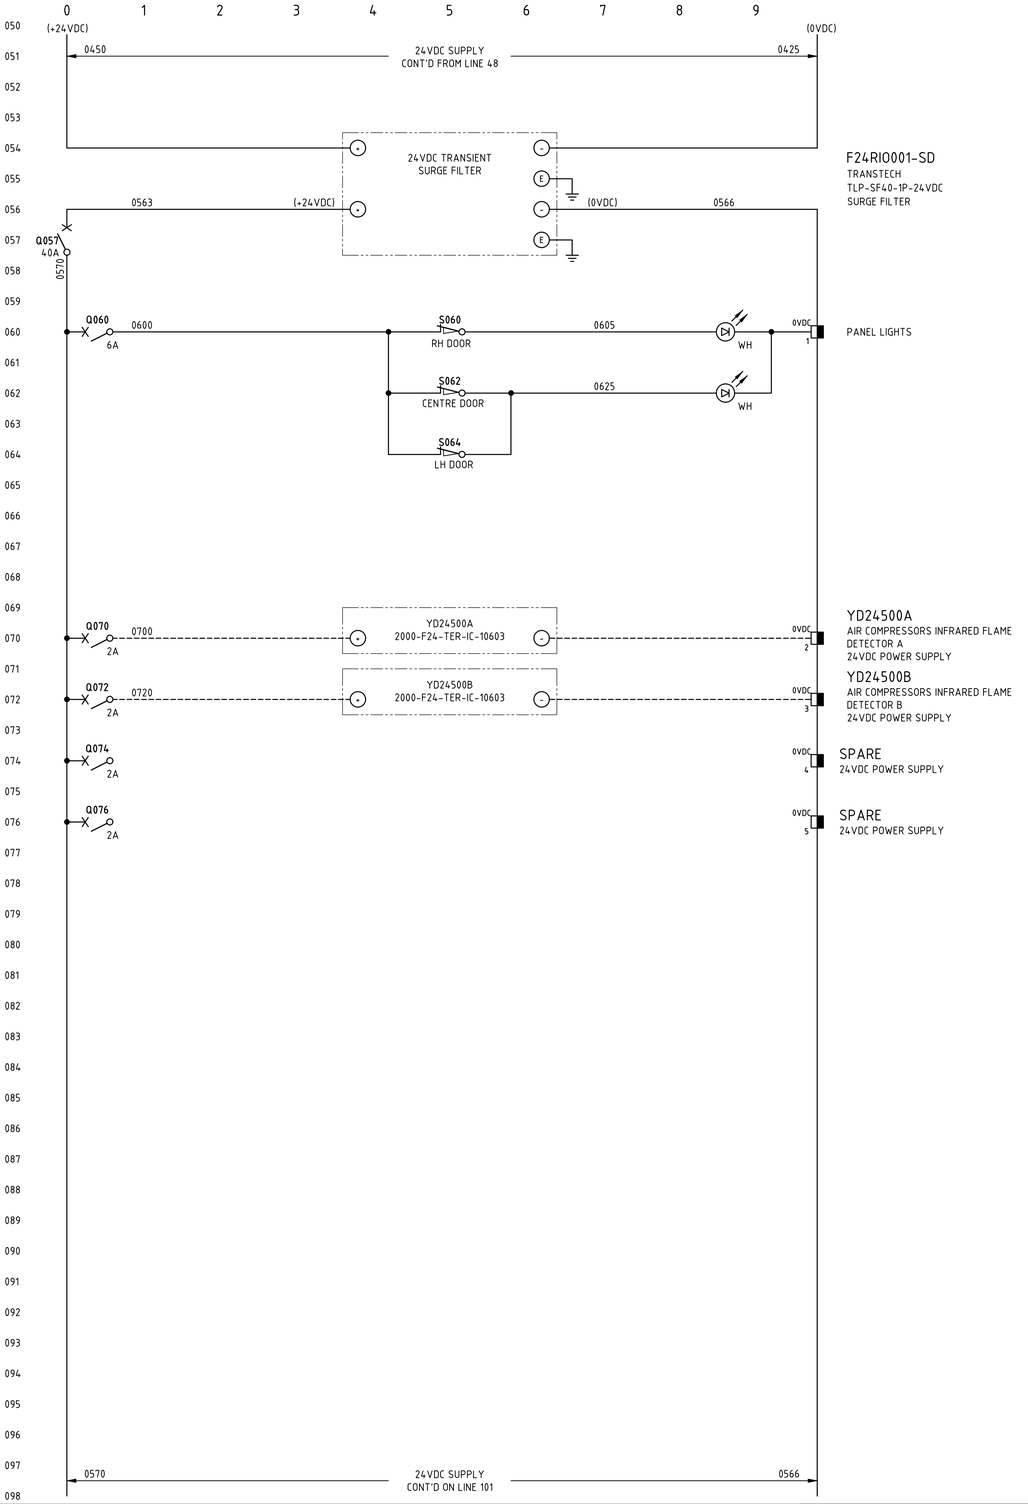

NOTES

1. TERMINALS ON TERMINAL STRIPS ABOVE 50VAC SHALL HAVE A SEPARATE PERSPEX SHROUD AND SHALL BE LABELLED "DANGER xxxVAC".
2. WIRE NUMBER FERRULES ON TERMINAL STRIP SHALL BE PREFIXED WITH EQUIPMENT NUMBER e.g. F24RIO001-xxxx.
3. EACH WIRE SHALL BE IDENTIFIED AT BOTH ENDS WITH FERRULES.
4. FOR NETWORK CONNECTION & BUS CABLING DETAILS REFER TO RIO PANEL COMMUNICATIONS TERMINATION DIAGRAMS.
5. INSTRUMENT EARTH BAR TO BE BONDED TO MAIN EARTH BAR WITH SOLID COPPER LINK.

LEGEND

- FIELD TERMINAL
- DCS OR I/O TERMINAL
- MARSHALLING TERMINAL
- DEVICE TERMINAL
- INDICATION LAMP, cc = COLOUR
- EARTH BAR
- INSTRUMENT EARTH BAR

AS CONSTRUCTED

CHANGE: ☐ NO CHANGE: ☒

SIGNATURE: J. Hamilton
NAME: J. Hamilton
DATE: 29/01/2026

ENGINEER SIGN OFF

SIGNATURE: Akmal
NAME: Mohd Akmal Bin Ismail
DATE: 05/02/2026

DRG No.	REFERENCES
2000-F16-TLD-IC-10056	F16-DB-202 SWITCHROOM 240V UPS DB THREE LINE DIAGRAM
2000-F24-DRG-IC-10601	F24-RIO-001 FIELD N-IO PANEL GENERAL ARRANGEMENT
2000-F24-SCM-IC-10602	F24-RIO-001 FIELD N-IO PANEL SCHEMATIC DIAGRAM SHEET 2
2000-F24-TER-IC-10600	F24-RIO-001 FIELD N-IO PANEL COMMUNICATIONS TERMINATION DIAGRAM SHEET 1 (TO SHEET 2 - 10601)
2000-F24-TER-IC-10602	F24-RIO-001 FIELD N-IO PANEL TERMINATION DIAGRAM SHEET 1 (TO SHEET 12 - 10613)
2000-F00-STD-EL-10001	GENERAL NOTES AND STANDARD DRAWINGS INDEX

REV	DATE	DESCRIPTION	DRAW	CHECK	DESIGN	TECH APP	PROJ APP
0RL1	05FEB26	AS CONSTRUCTED	[redacted]				
0	04MAR25	APPROVED FOR CONSTRUCTION					

NORTHERN STAR RESOURCES LIMITED

PRIMERO
primero.com.au | DESIGN | CONSTRUCT | OPERATE

PRIMERO PROJECT NUMBER: 23517

INFORMATION AND REPRESENTATIONS ON THIS DRAWING ARE THE INTELLECTUAL PROPERTY OF PRIMERO UNLESS SPECIFICALLY IDENTIFIED OTHERWISE. ALL RIGHTS INCLUDING USE RESERVED

PROJECT: NORTHERN STAR RESOURCES LTD
KCGM GROWTH PROJECT

TITLE: AIR & WATER SERVICES - PLANT AIR
F24-RIO-001 AIR SERVICES FIELD N-IO PANEL
SCHEMATIC DIAGRAM SHEET 1

SHEET	SCALE	DRG No.	REVISION
A1	NONE	2000-F24-SCM-IC-10601	0RL1

O:\CAD PROJECTS\235 NORTHERN STAR RESOURCES LTD\23517 KCGM GROWTH PROJECT\03 DELIVERABLES\IC\F24 - AIR & WATER SERVICES\2000-F24-SCM-IC-10601.DWG 04MAR25 2:13PM SANDRA CULL