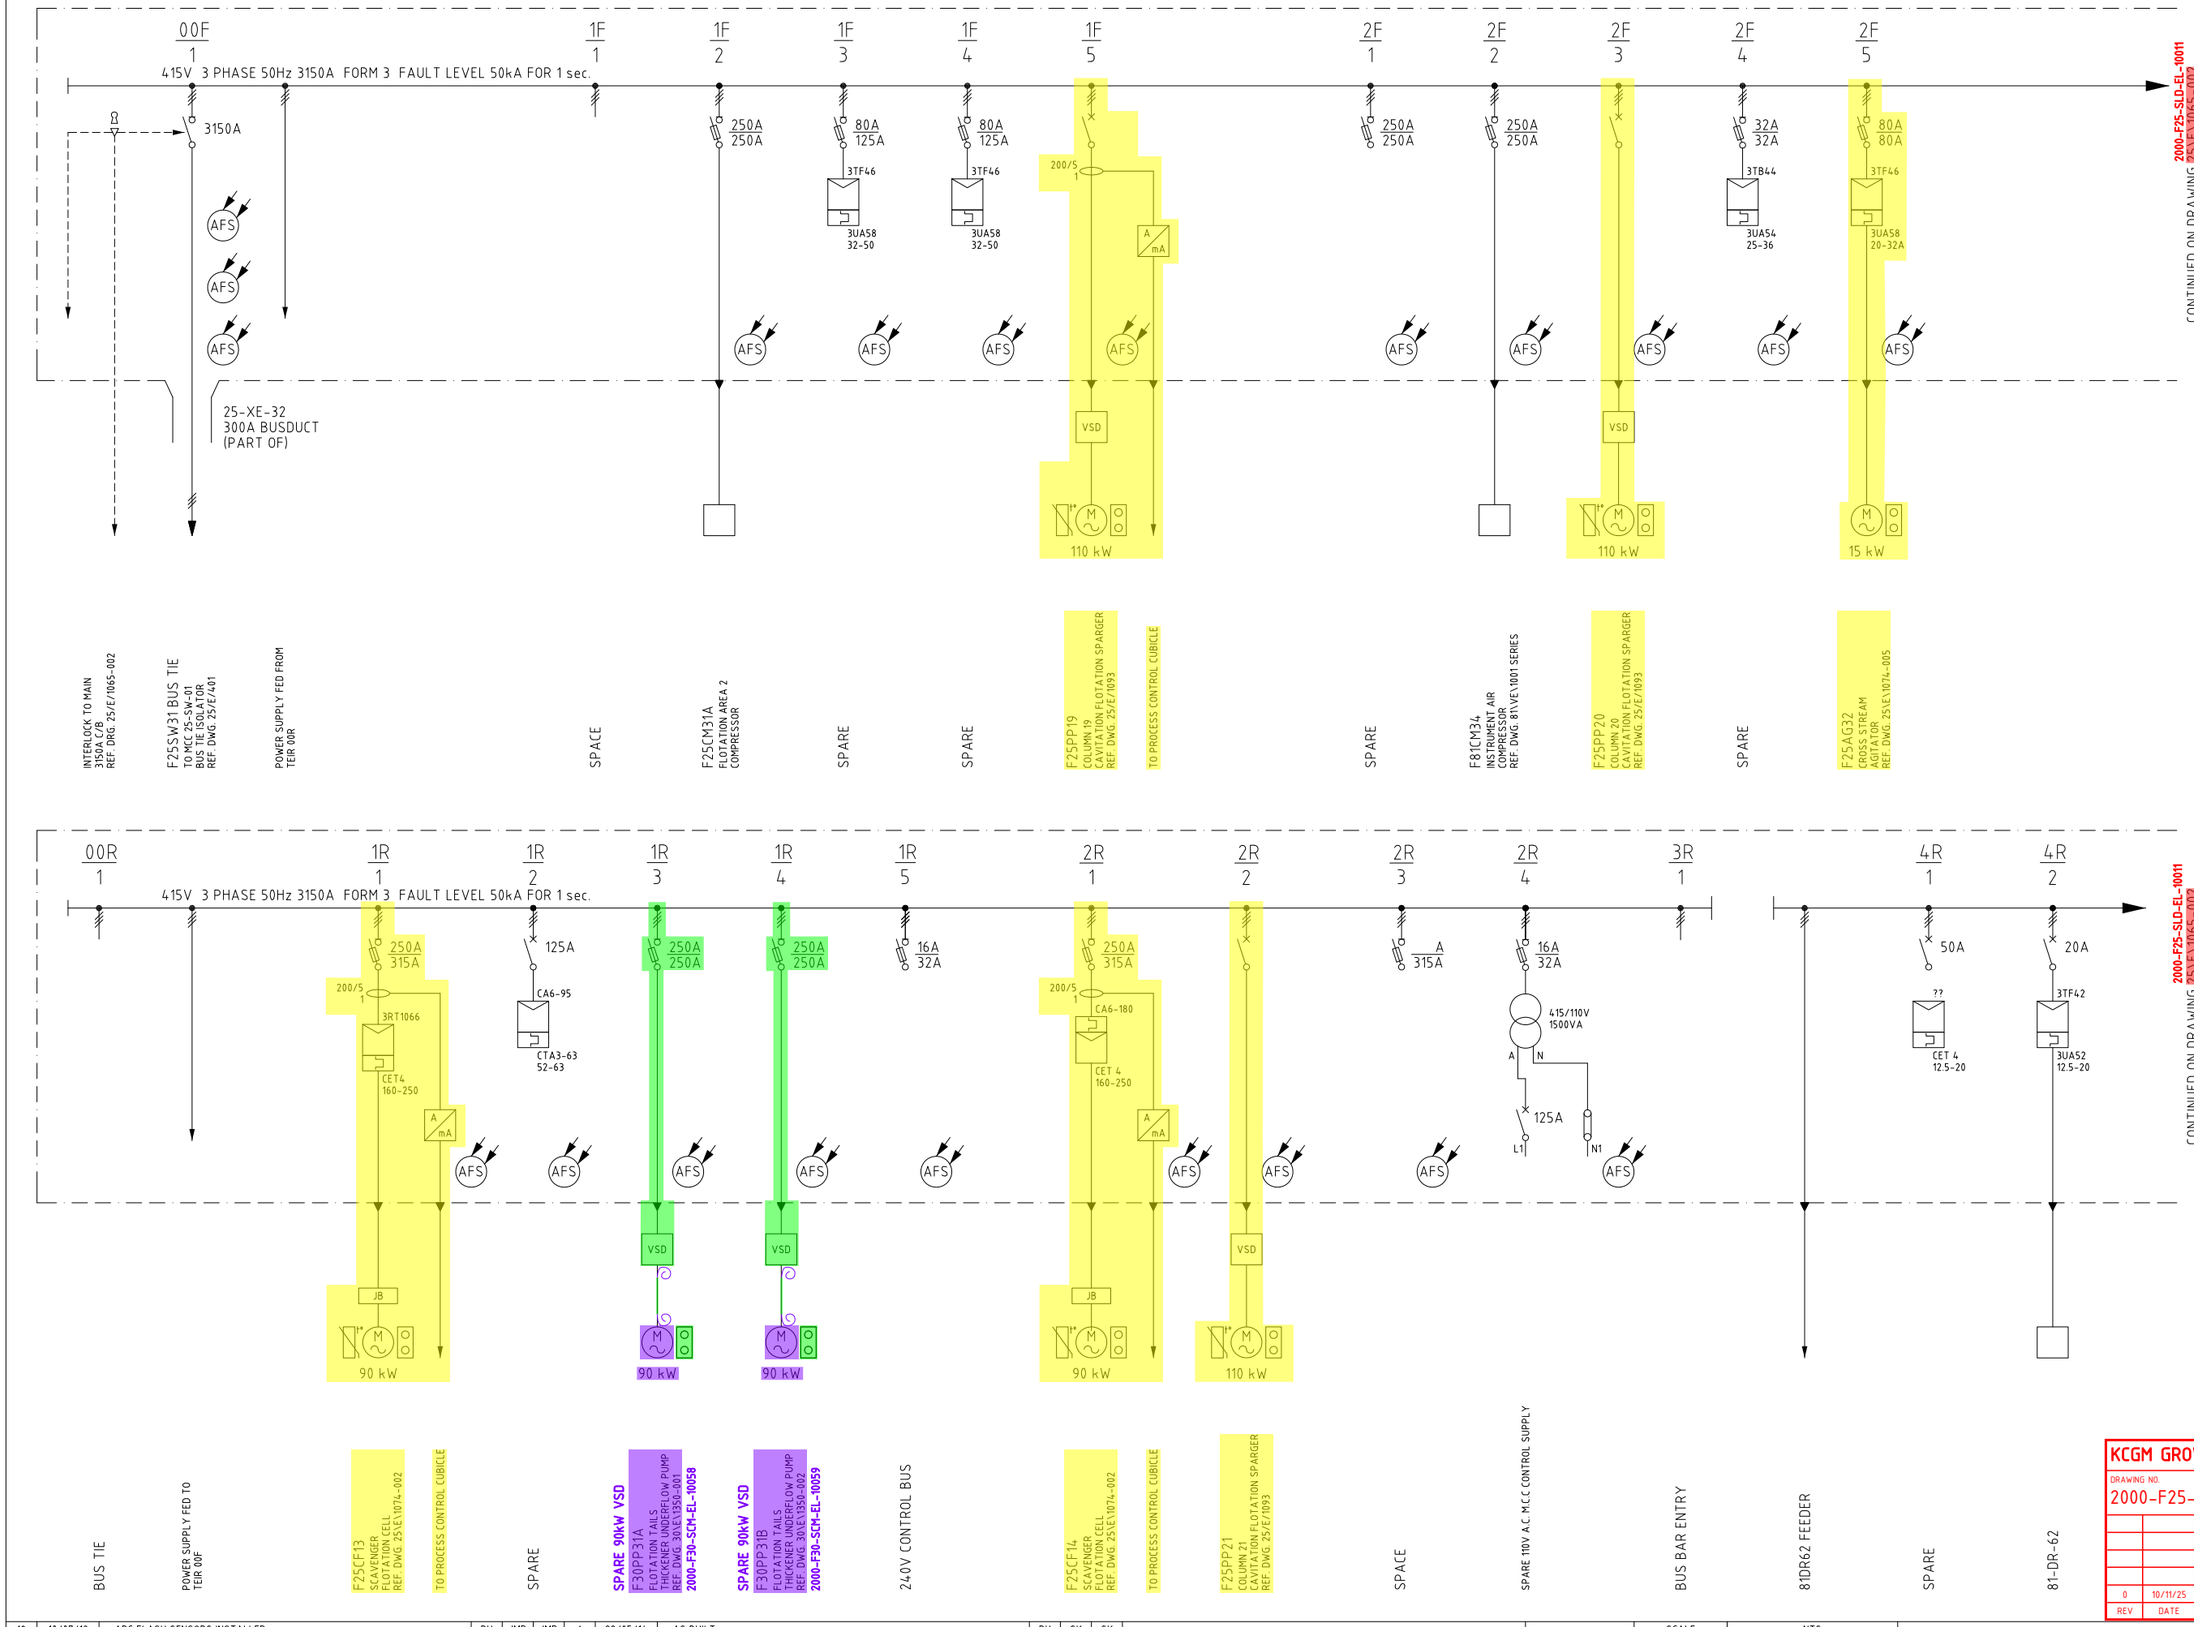



## LEGEND

NORTHERN STAR RESOURCES LIMITED

| | |
|---|---|
| Approved | X |
| Approved as Noted | |
| Not Approved | |
| For Information Only | |


Signed: C Laird — Date: 20/11/2025

ACCEPTANCE DOES NOT RELIEVE THE SUPPLIER / CONTRACTOR OF ITS RESPONSIBILITY OR LIABILITIES UNDER THE PURCHASE ORDER / CONTRACT

## LOCATION

SUB STATION 6

25-SW-31

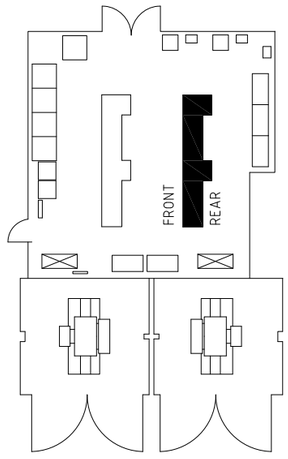


## NOTES

1. ALL AFS (ARC FLASH SENSORS) ARE CONNECTED TO THE ARC FLASH RELAY VIA I/O UNITS

LEGEND

- EXISTING
- NON-EXISTENT
- STAGE 1 - NEW
- STAGE 1 - REMOVE
- STAGE 1 - DECOMMISSIONED (OTHERS)
- STAGE 2 - NEW
- STAGE 2 - REMOVE
- STAGE 2 - DECOMMISSIONED (OTHERS)

**KCGM GROWTH PROJECT**

DRAWING NO. 2000-F25-SLD-EL-10010

| REV | DATE | DESCRIPTION | CHECK | TECH APP |
|---|---|---|---|---|
| 0 | 10/11/25 | APPROVED FOR CONSTRUCTION | | DM |

| MK | DATE | REVISION | BY | CKD | APP |
|---|---|---|---|---|---|
| 12 | 10/07/18 | ARC FLASH SENSORS INSTALLED | RH | JMR | JMR |
| 11 | 11/04/16 | AS BUILT | | SK | |
| 10 | 02/09/15 | AS BUILT | | SK | |
| 9 | 30/10/14 | FLOTATION COLUMN 19,20 & 21 CAVITATION SPARGER PUMPS INFO UPDATED | | SK | |
| 8 | 21/10/14 | 25CM31B RELOCATED FROM 2F/1 TO 4F/3 DURING SHUTDOWN | | SK | |
| 7 | 08/07/14 | FLOTATION COLUMN 19,20 & 21 CAVITATION SPARGER PUMPS INSTALLED | | SK | |
| 6 | 22/05/14 | AS BUILT | | SK | |
| 5 | 27/09/12 | GENERAL INFORMATION UPDATED | | RH | |
| 16 | 07/11/22 | 30PP31A & 31B DRAWING NUMBERS UPDATED | | MB | |
| 15 | 11/07/22 | 81CM34 REF. DWG. ADDED | | JM | |
| 14 | 08/10/19 | 2019 S.L.D. UPDATE PROJECT "AS BUILT" | | RH | |
| 13 | 08/08/19 | 2019 S.L.D. UPDATE PROJECT "AS BUILT"- FIELD REVIEW | | RH | |

REFERENCE DRAWINGS — DWG NO.

| | | |
|---|---|---|
| SCALE | NTS | |
| DRAWN | | 01/10/00 |
| DESIGNED | KCGM | 01/10/00 |
| CHECKED | KCGM | 01/10/00 |
| APPROVED | KCGM | 01/10/00 |
| PROJ.APP | KCGM | 01/10/00 |
| PROJ. FILE #. | | |

FIMISTON PLANT
FLOTATION
SUBSTATION No.6 415V MCC 25SW31
SINGLE LINE DIAGRAM

| SIZE | DRAWING NUMBER | REV |
|---|---|---|
| A1 | 25\E\1065-001 | 16 |

KALGOORLIE CONSOLIDATED GOLD MINES PTY. LTD. ABN 009 377 619 003