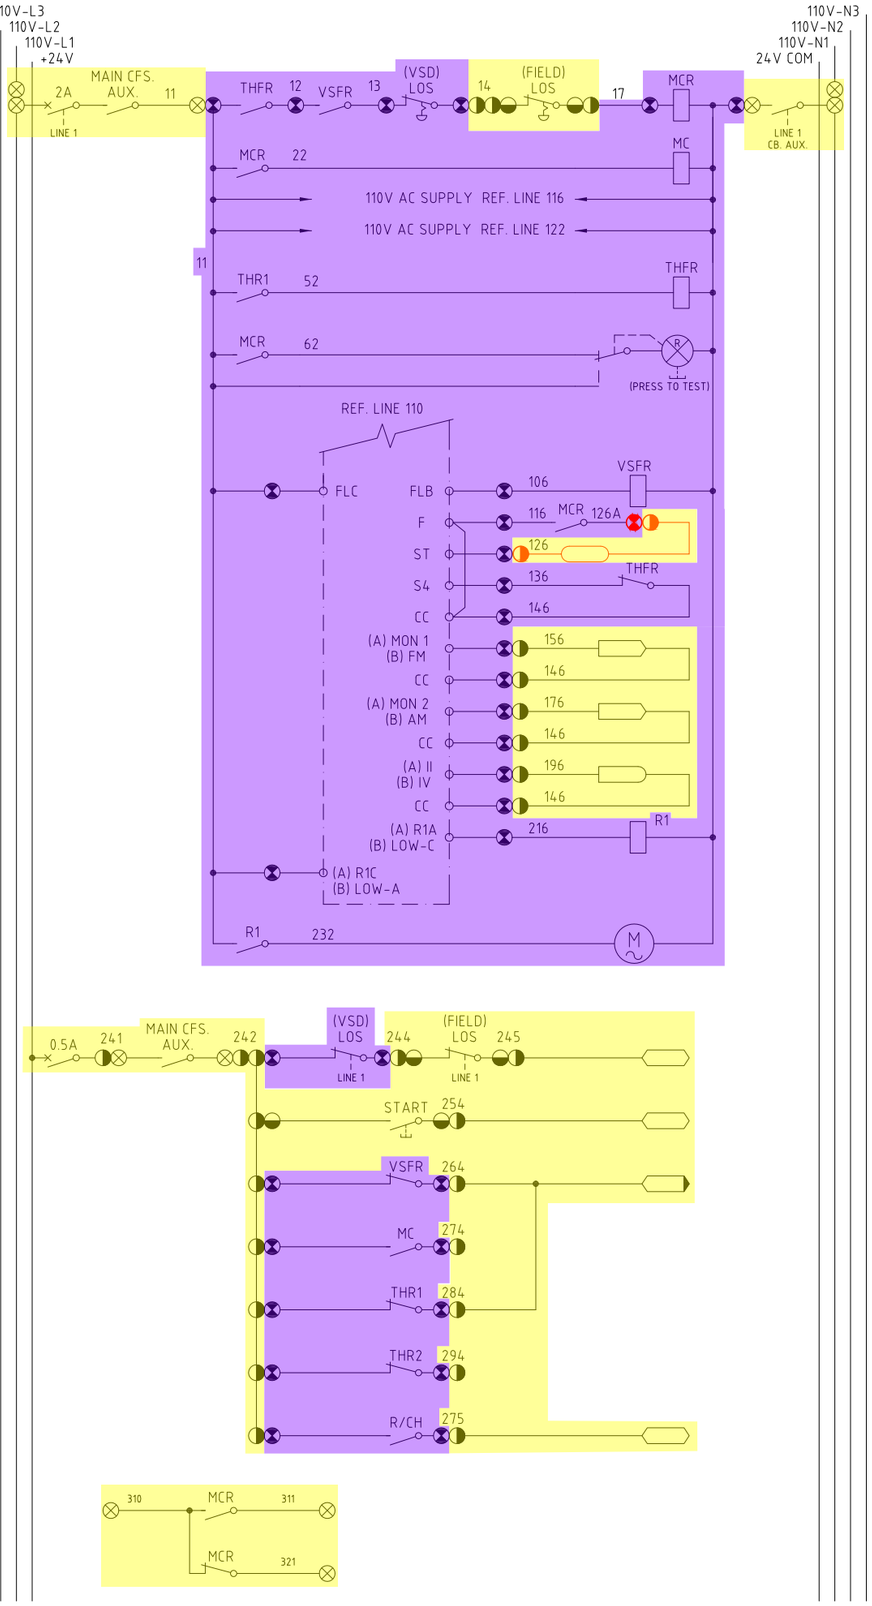



START RELAY

MAIN CONTACTOR RELAY

MAIN CONTACTOR

TO THERMISTOR RELAY 1 (TRIP)

TO THERMISTOR RELAY 2 (ALARM)

THERMISTOR FAULT RELAY

VSD SUPPLY AVAILABLE

VSD FAULT RELAY

MAIN CONTACTOR RELAY

**DRIVE START OUTPUT**

THERMISTOR FAULT RELAY

REMOTE SPEED INPUT

REMOTE CURRENT INPUT

REMOTE SPEED OUTPUT

COOLING FAN RELAY

COOLING FAN


STOP INPUT

START INPUT

VSD FAULT INPUT

RUN INPUT

## POWER LAYOUT

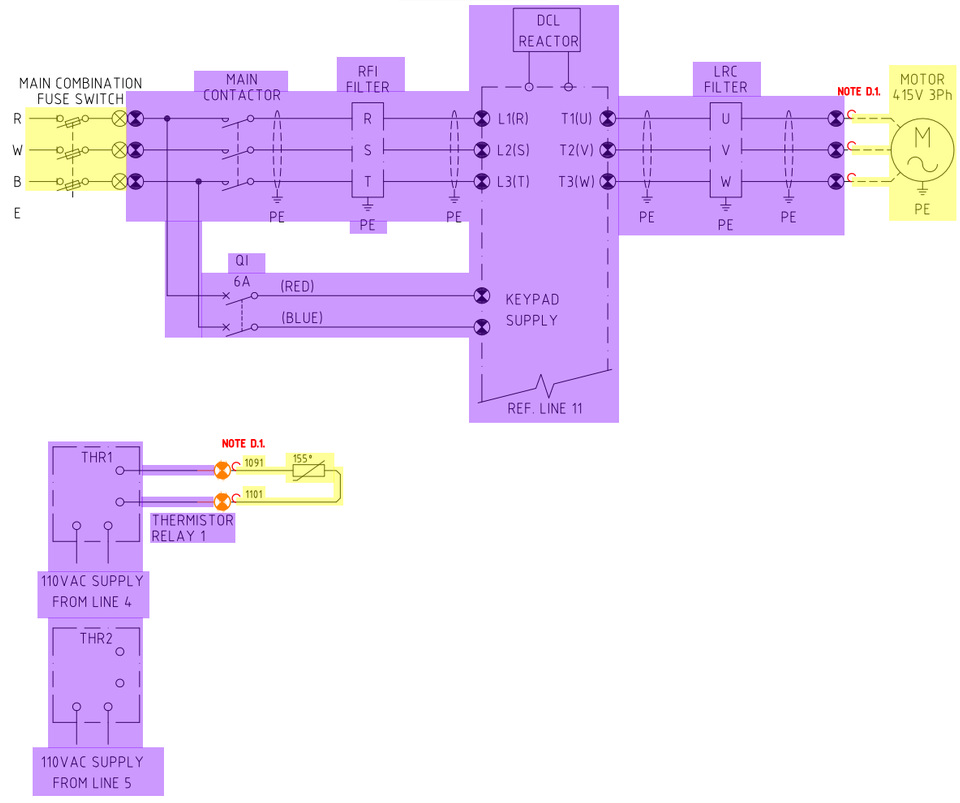


| EQUIPMENT NUMBER | DESCRIPTION | MODULE NUMBER | FERRULE PREFIX | | DCS START OUTPUT | DCS STOP INPUT | DCS START INPUT | DCS VSD FAULT INPUT |
|---|---|---|---|---|---|---|---|---|
| SPARE 30-PP-61A | FLOTATION TAILS THICKENER 3 U/FLOW PUMP "A" | 3F/1 | PP61A | | %Z055225 | %Z053414 | %Z053415 | %Z053416 |
| SPARE 30-PP-61B | FLOTATION TAILS THICKENER 3 U/FLOW PUMP "B" | 3F/2 | PP61B | | %Z055229 | %Z054105 | %Z054106 | %Z054107 |

| EQUIPMENT NUMBER | DCS RUN INPUT | DCS REM SPEED ANALOG OUTPUT | DCS MTR AMPS ANALOG INPUT | VSD UNIT NUMBER | DB NUMBER | PANEL NUMBER | 24V C/B NUMBER | | |
|---|---|---|---|---|---|---|---|---|---|
| SPARE 30-PP-61A | %Z054108 | 2000-F30-SCM-IC-10470 | 2000-F30-SCM-IC-10470 | 30VS61A | 30PC62 | DF | 1/8 | | |
| SPARE 30-PP-61B | %Z054108 | 2000-F30-SCM-IC-10470 | 2000-F30-SCM-IC-10470 | 30VS61B | 30PC62 | DF | 1/9 | | |

LEGEND
- EXISTING
- NON-EXISTENT
- STAGE 1 - NEW
- STAGE 1 - REMOVE
- STAGE 1 - DECOMMISSIONED (OTHERS)
- STAGE 2 - NEW
- STAGE 2 - REMOVE
- STAGE 2 - DECOMMISSIONED (OTHERS)

**KCGM GROWTH PROJECT DEMOLITION NOTES**

D.1. VSD OUTGOING FIELD CABLES CABLES TO BE DISCONNECTED AND MADE SAFE AT BOTH ENDS.

**KCGM GROWTH PROJECT**

DRAWING NO. 2000-F30-SCM-EL-10052

| REV | DATE | DESCRIPTION | CHECK | TECH APP |
|---|---|---|---|---|
| 0 | 10/11/25 | APPROVED FOR CONSTRUCTION | [redacted] | |

## LEGEND

TERMINALS
- MOTOR CONTROL CENTRE (MCC)
- FIELD
- PROCESS CONTROL CUBICLE
- LINE CONDITIONER
- SOFT STARTER TERMINAL
- VARIABLE SPEED DRIVE
- DISTRIBUTION BOARD
- HV MOTOR CONTROL CENTRE
- MISC. ELECTRICAL DEVICE REFER NOTES FOR SPECIFIC DESC.

DIGITAL FUNCTIONS
- DCS INPUT
- DCS INPUT WITH ALARM FUNCTION
- DCS OUTPUT

ANALOGUE FUNCTION
- 4-20mA INPUT
- 4-20mA OUTPUT

ANCILLARY EQUIPMENT
- CIRCUIT BREAKER
- COMBINATION FUSE SWITCH
- ISOLATOR
- PUSH BUTTON
- LOS (LOCK OFF STOP)
- PULL WIRE SWITCH
- NORMALLY CLOSED CONTACT
- LIMIT SWITCH
- CONTACTOR CONTACT
- NORMALLY OPEN CONTACT
- TIMER CONTACT
- FUNCTION CONTACT
  - P - PRESSURE
  - T° - TEMPERATURE
  - F - FLOW
  - L - FLOAT
- SIREN
- HORN
- RELAY
- LINK
- THERMISTOR
- INDICATION LAMP (R - RED, G - GREEN, A - AMBER)

VOLTAGES ON CONTROL BUS
- +24V - 24V DC DCS SUPPLY BUS
- 110V-L1 - 110V AC MCC CONTROL BUS
- 110V-L2 - 110V AC CONDITIONED BUS
- 110V-L3 - 110V AC NON CONDITIONED BUS

## NOTES

1. ALL WIRES EXCEPT CONTROL SUPPLIES & THOSE WITHIN FORM 4 MODULES SHALL BE FERRULED WITH PREFIX LISTED IN ABOVE TABLE.

| MK | DATE | REVISION | BY | CKD | APP |
|---|---|---|---|---|---|
| 1 | 24-10-03 | AS BUILT | [redacted] | | |

REFERENCE DRAWINGS

DWG NO.

PROJ. FILE #.

| | |
|---|---|
| SCALE | NTS |
| DRAWN | [redacted] 24-10-03 |
| DESIGNED | |
| CHECKED | |
| APPROVED | |
| PROJ.APP | |

FIMISTON PLANT
FLOTATION AREA TAILS THICKENER
FLOTATION TAILS THICKENER 3 U/FLOW [redacted] A&B
CONTROL SCHEMATIC

| SIZE | DRAWING NUMBER | REV |
|---|---|---|
| A1 | 30/E/0449 | 1 |

KALGOORLIE CONSOLIDATED GOLD MINES PTY. LTD. ACN 009 377 619