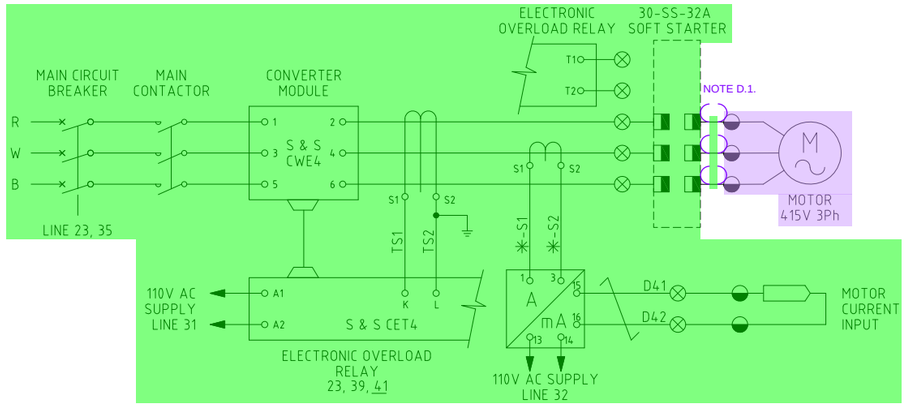


DRIVE No.	NAME	MODULE No.	FERRULE PREFIX	DCS START OUTPUT	DCS STOP INPUT	DCS START INPUT	DCS PRE-ALARM INPUT	DCS FAULT INPUT	PLC RUN INPUT
F340B-F30TK32A-PP01	TANK TK32A OXYGEN INJECTION PUMP	4R/1	32APP01	%Z051417	%Z051224	%Z051225	%Z051226	%Z051227	%Z051228


DRIVE No.	MOTOR CURRENT INPUT	MOTOR CURRENT TAG No.	DB No	DCS PANEL	24V CB No
F340B-F30TK32A-PP01	REFER LOOP 30-E-0497	IT30344	30-PC-62	DF	B21

KCGM GROWTH PROJECT DEMOLITION NOTES

D.1. MOTOR AND THERMISTOR CABLES TO BE DISCONNECTED AND MADE SAFE.

CONTINUED FROM FME-30-E-430

240V-L4 240V AC CONTROL BUS
110V-L7 110V AC NON CONDITIONED BUS
110V-L2 110V AC CONDITIONED BUS
110V-L1 110V AC MCC CONTROL BUS
+24V 24V DC DCS SUPPLY BUS
240V-N4
110V-N7
110V-N2
110V-N1
24V COM

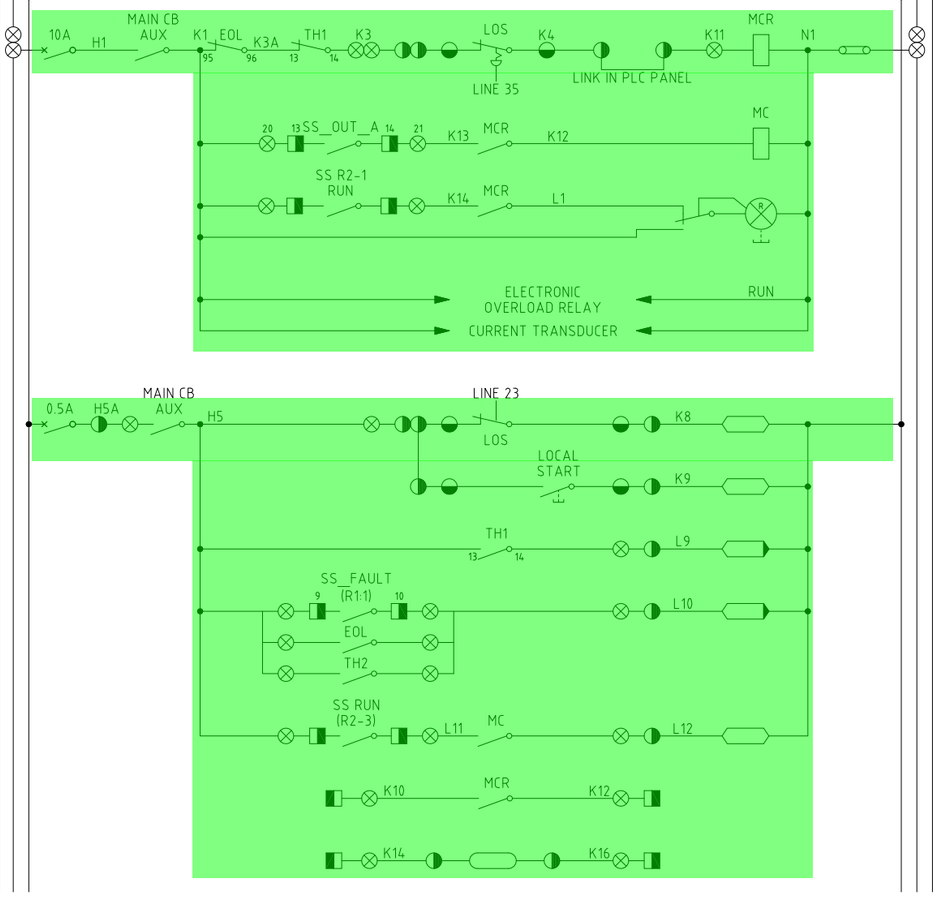

MAIN CONTACTOR HEALTHY 26, 45, 47

MAIN CONTACTOR 43

RUN INDICATION (PRESS TO TEST)

RUN RELAY 26,43 SUPPLY TO ELECT. OVERLOAD RELAY & CURRENT TRANSDUCER REFER ABOVE 3 LINE DIAGRAM

STOP INPUT


START INPUT


PRE-ALARM INPUT (CLOSE ON FAULT)

FAULT INPUT

RUN INPUT

DCS START OUTPUT

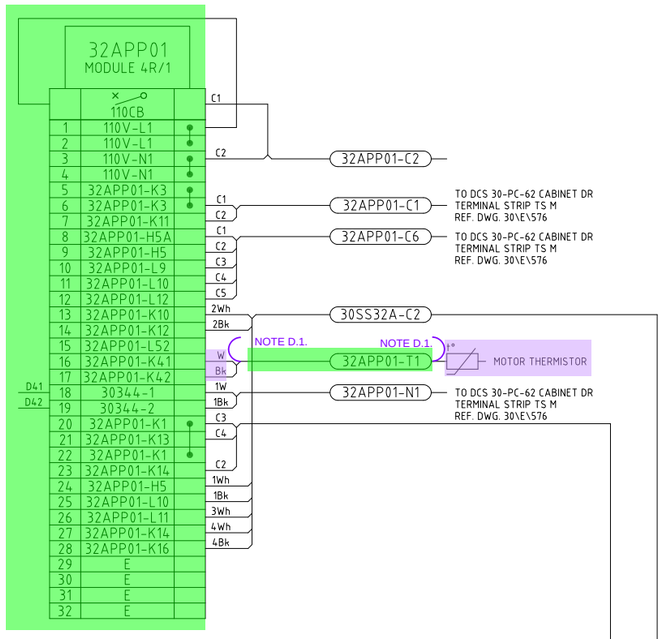

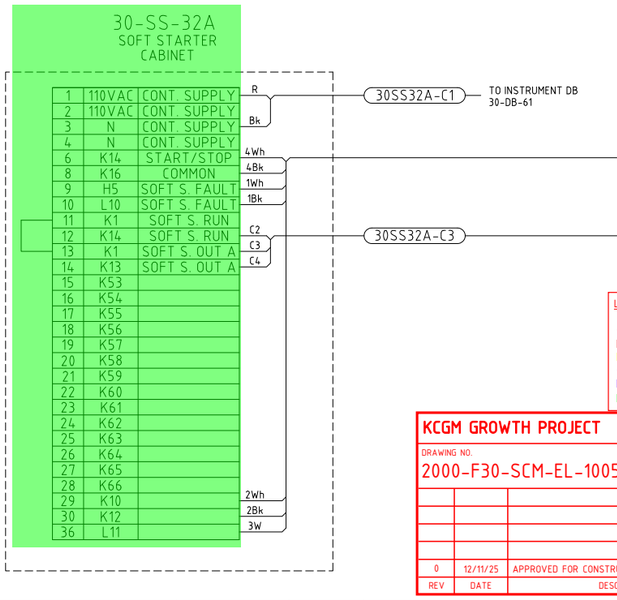

LEGEND

TERMINALS
- MOTOR CONTROL CENTRE (MCC)
- FIELD
- PROCESS CONTROL CUBICLE (30-PC-62)
- LINE CONDITIONER
- VARIABLE SPEED DRIVE
- DISTRIBUTION BOARD
- SOFT STARTER TERMINAL

DIGITAL FUNCTIONS
- DCS INPUT
- DCS INPUT WITH ALARM FUNCTION
- DCS OUTPUT

ANALOGUE FUNCTION
- 4-20mA INPUT
- 4-20mA OUTPUT

ANCILLARY EQUIPMENT
- CONTACT - NORMALLY CLOSED
- CONTACT - NORMALLY OPEN
- LIMIT SWITCH
- CONTACTOR
- PUSH BUTTON
- LOS (LOCK OFF STOP)
- RELAY
- LINK
- CIRCUIT BREAKER
- THERMISTOR
- INDICATION LAMP R RED, G GREEN, A AMBER
- SIREN
- HORN
- TRANSDUCER

LEGEND
- STAGE 1 - NEW
- STAGE 1 - REMOVE
- STAGE 1 - DECOMMISSIONED (OTHERS)
- STAGE 2 - NEW
- STAGE 2 - REMOVE
- STAGE 2 - DECOMMISSIONED (OTHERS)

NOTES

1. ALL WIRES EXCEPT CONTROL SUPPLIES & THOSE WITHIN FORM 4 MODULES SHALL BE FERRULED WITH PREFIX LISTED IN ABOVE TABLE.

KCGM GROWTH PROJECT

DRAWING NO. 2000-F30-SCM-EL-10054

REV	DATE	DESCRIPTION	CHECK	TECH APP
0	12/11/25	APPROVED FOR CONSTRUCTION	[redacted]	MB/DM

MK	DATE	REVISION	BY	CKD	APP
1	08.03.22	AS BUILT	[redacted]	GB	[redacted]
0	12.10.21	ISSUED FOR CONSTRUCTION	[redacted]	CV	

REFERENCE DRAWINGS

DWG NO.

	SCALE	NTS	
	DRAWN	[redacted]	12.10.21
	DESIGNED	[redacted]	12.10.21
	CHECKED	[redacted]	12.10.21
	APPROVED	[redacted]	12.10.21
	PROJ.APP		
	PROJ. FILE #.		

FIMISTON PLANT
CARBON IN LEACH (C.I.L. 3)
30-SW-62 32APP01
SCHEMATIC DIAGRAM

SIZE	DRAWING NUMBER	REV
A1	30\E\0438-003	1

KALGOORLIE CONSOLIDATED GOLD MINES PTY. LTD. ACN 009 377 619