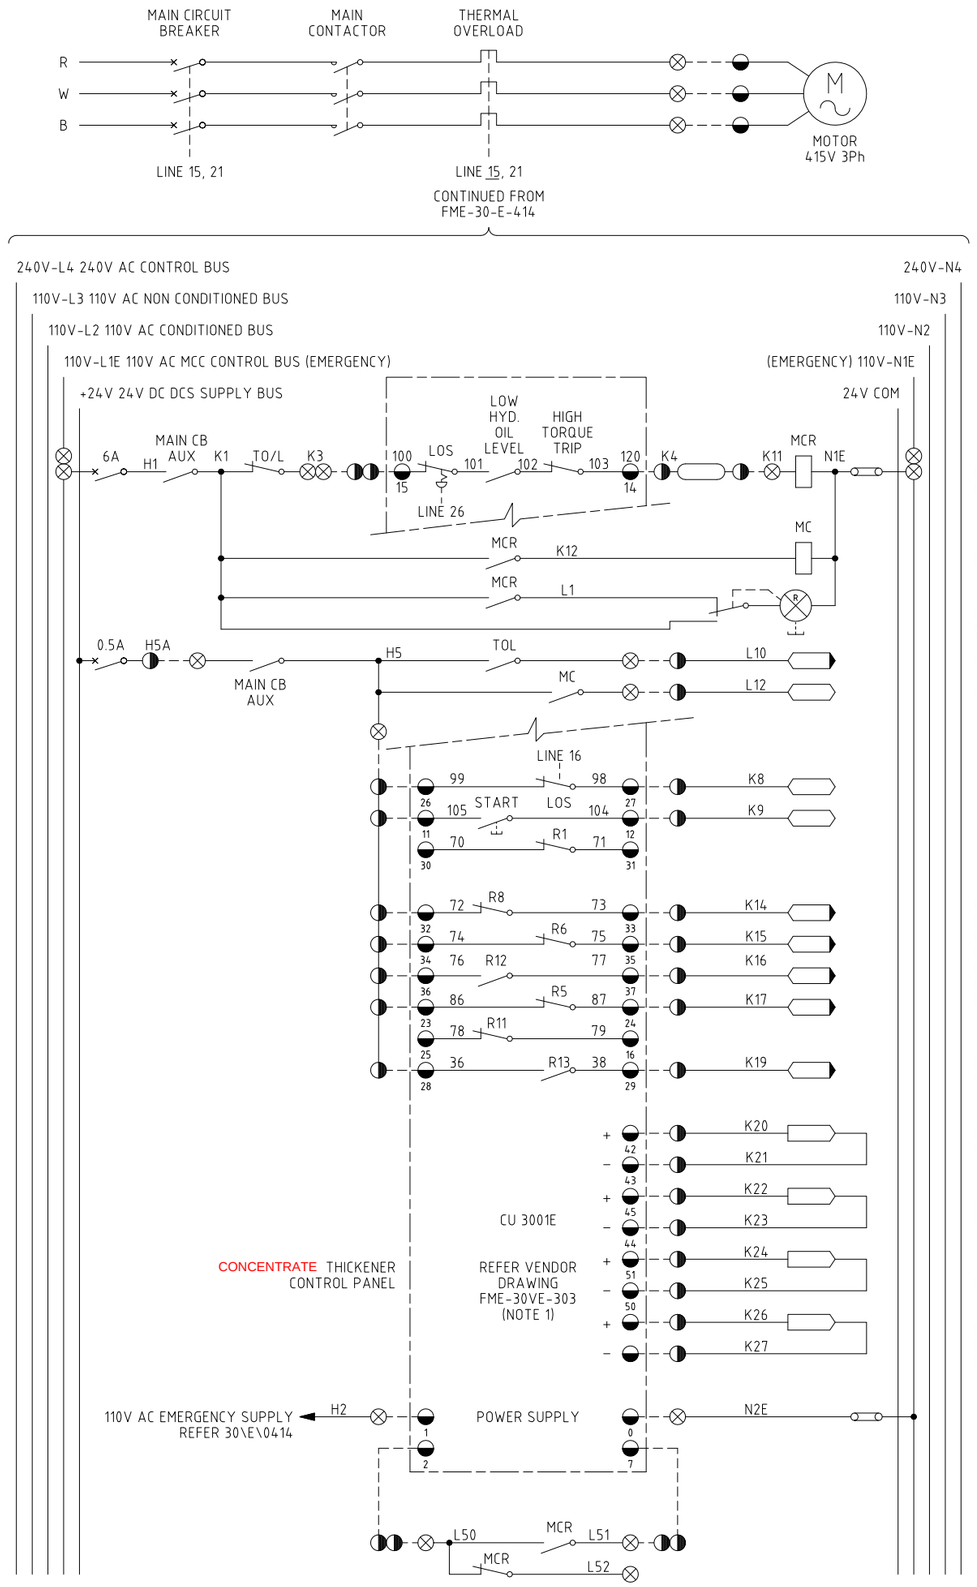


DRIVE No.	NAME	MODULE No.	FERRULE PREFIX	DCS START OUTPUT	DCS STOP INPUT	DCS START INPUT	DCS FAULT INPUT	DCS RUN INPUT
30-TH-61	FLOTATION TAILINGS THICKENER No.3		TH61	%Z055221	%Z053401	%Z053402	%Z053403	%Z053404
	CONCENTRATE THICKENER							

DRIVE No.	RAKE FULLY LOWERED INPUT	RAKE FULLY RAISED INPUT	LOW HYD. OIL LEVEL INPUT	HI TORQUE TRIP INPUT	LOW G/BOX OIL LEVEL INPUT	BED LEVEL INPUT	BED PRESSURE INPUT	TORQUE VALUE INPUT	RAKE POSITION INPUT
30-TH-61	%Z053405	%Z053406	%Z053408	%Z053407	%Z053409	REFER LOOP 30\E\0470	REFER LOOP 30\E\0470	REFER LOOP 30\E\0470	REFER LOOP 30\E\0471

MAIN CONTACTOR RELAY
18, 19, 49, 50

MAIN CONTACTOR
22

RUN INDICATION
(PRESS TO TEST)

FAULT INPUT

RUN INPUT

DRIVE No.	DB No	DCS PANEL	24V CB No
30-TH-61	30-PC-62	DF	B19

STOP INPUT

START INPUT

RAKE FULLY LOWERED INPUT
RAKE FULLY RAISED INPUT
LOW HYD. OIL LEVEL INPUT
HIGH TORQUE TRIP INPUT

LOW G/BOX OIL LEVEL ALARM

ALL INPUTS OPEN ON ALARM

BED LEVEL INPUT

BED PRESS INPUT

TORQUE VALUE INPUT

RAKE POSITION INPUT
NOTE 3

START RELAY

110V-L1E	•
110V-L1E	•
110V-N1E	•
110V-N1E	•
H2	
N2E	
K3	•
K3	•
K11	
H5	
H5A	
L10	
L12	
L50	
L51	
L52	

MCC TERMINAL ARRANGEMENT

LEGEND
- STAGE 1 - NEW
- STAGE 1 - REMOVE
- STAGE 1 - DECOMMISSIONED (OTHERS)
- STAGE 2 - NEW
- STAGE 2 - REMOVE
- STAGE 2 - DECOMMISSIONED (OTHERS)

KCGM GROWTH PROJECT

DRAWING NO.
2000-F30-SCM-EL-10065

REV	DATE	DESCRIPTION	CHECK	TECH APP
0	10/11/25	APPROVED FOR CONSTRUCTION	RF	MB/DM

LEGEND

TERMINALS
- MOTOR CONTROL CENTRE (MCC)
- FIELD
- PROCESS CONTROL CUBICLE (30-PC-62)
- LINE CONDITIONER
- VARIABLE SPEED DRIVE
- DISTRIBUTION BOARD

DIGITAL FUNCTIONS
- DCS INPUT
- DCS INPUT WITH ALARM FUNCTION
- DCS OUTPUT

ANALOGUE FUNCTION
- 4-20mA INPUT
- 4-20mA OUTPUT

ANCILLARY EQUIPMENT
- CONTACT - NORMALLY CLOSED
- CONTACT - NORMALLY OPEN
- LIMIT SWITCH
- CONTACTOR
- PUSH BUTTON
- LOS (LOCK OFF STOP)
- RELAY
- LINK
- CIRCUIT BREAKER
- THERMISTOR
- INDICATION LAMP R RED G GREEN A AMBER
- SIREN
- HORN

NOTES

1. 30-TH-61 WAS PREVIOUSLY FINAL TAILS THICKENER 30-RK-32.
2. ALL WIRES EXCEPT CONTROL SUPPLIES & THOSE WITHIN FORM 4 MODULES SHALL BE FERRULED WITH PREFIX LISTED IN ABOVE TABLE.
3. RAKE POSITION TO BE RETROFITTED TO EXISTING THICKENER ON SITE.

CLIENT APPROVED for CONSTRUCTION

DATE: 14.02.95 SIGNED: [redacted]

COPYRIGHT ©
This drawing remains the property of MINPROC ENGINEERS LIMITED and may not be copied in any way without prior written approval from this company.

MINPROC ENGINEERS LIMITED
A.C.N. 008 992 694
22, STIRLING HIGHWAY, NEDLANDS WA 6009
PHONE (09) 347 4777

No.	BY	DATE	REVISION	CHECKED	APPROV
3	GTP	8/2/96	AS BUILTS BY LYCOPODIUM		
2	AH	8/05/95	DCS ADDRESSES ADDED	J.A.M.	PF
1	AH	27/01/95	APPROVED FOR CONSTRUCTION	J.A.M.	P.S.J.
0	GMB	12/10/94	APPROVED FOR TENDER	J.A.M.	P.S.J.

	BY	DATE
PROJECT APPR.	[redacted]	13/02/95
DESIGN APPR.	[redacted]	7/02/95
DESIGNED	[redacted]	17/10/94
CHECKED	[redacted]	13/10/94
DRAWN	[redacted]	20/09/94

CLIENT: KALGOORLIE CONSOLIDATED GOLD MINES

SIZE: A1

SCALE: N.T.S.

TITLE: FIMISTON EXPANSION 1994/95
CIL 3 AREA MAIN 415V MCC 30-SW-62
SCHEMATIC DIAGRAM SHEET 1

REV. No.: 0

DRAWING No.: 30\E\0415

DRAWING No.	REFERENCE DRAWINGS
FME-30-E-404	415V MCC 30-SW-62 SINGLE LINE DIAGRAM SHT 2