
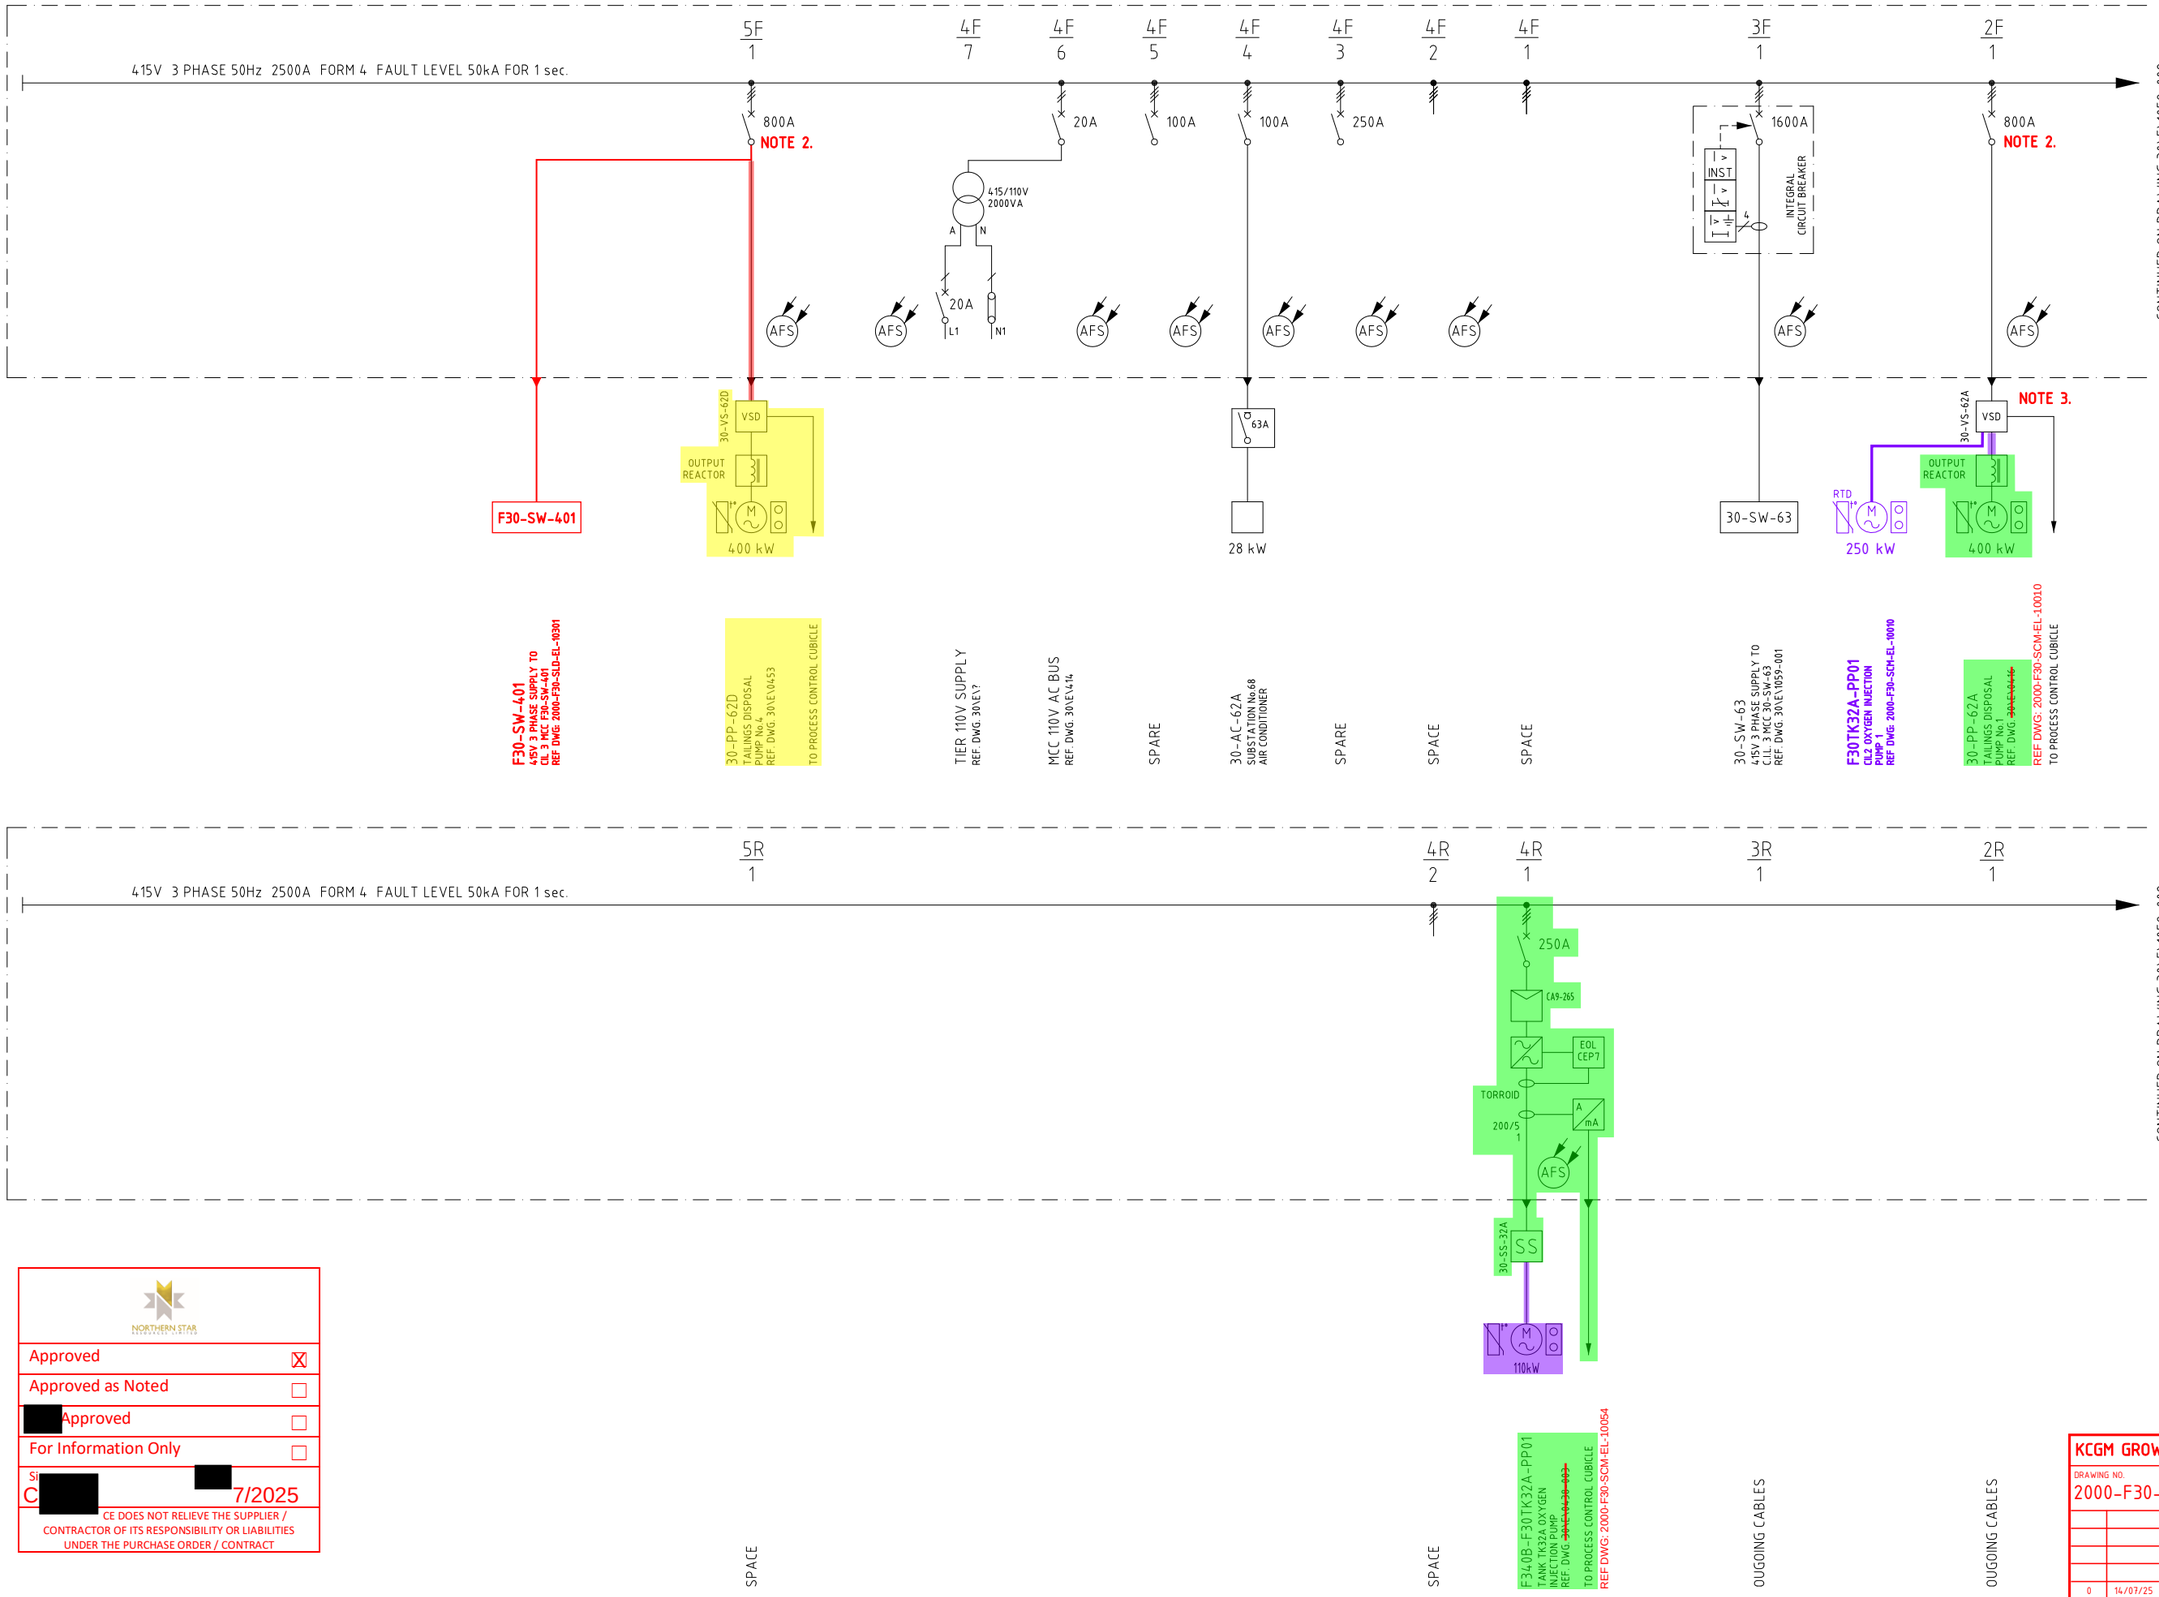


LEGEND

LOCATION

SUB STATION 68

30-SW-62

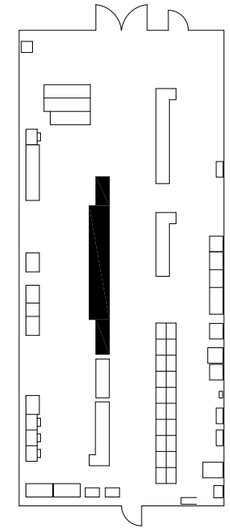

NOTES

1. ALL AFS (ARC FLASH SENSORS) ARE CONNECTED TO THE ARC FLASH RELAY VIA I/O UNITS
2. MCC FEEDER RE-PURPOSED AS PART OF THE KCGM GROWTH PROJECT.
3. VSD RE-PURPOSED AS PART OF THE KCGM GROWTH PROJECT.

LEGEND

- STAGE 1 - NEW
- STAGE 1 - REMOVE
- STAGE 1 - DECOMMISSIONED (OTHERS)
- STAGE 2 - NEW
- STAGE 2 - REMOVE
- STAGE 2 - DECOMMISSIONED (OTHERS)

NORTHERN STAR

Approved	X
Approved as Noted	
[redacted] Approved	
For Information Only	

Si[redacted]

C[redacted] 7/2025

CE DOES NOT RELIEVE THE SUPPLIER / CONTRACTOR OF ITS RESPONSIBILITY OR LIABILITIES UNDER THE PURCHASE ORDER / CONTRACT

KCGM GROWTH PROJECT

DRAWING NO.
2000-F30-SLD-EL-10101

REV	DATE	DESCRIPTION	CHECK	TECH APP
0	14/07/25	APPROVED FOR CONSTRUCTION	[redacted]	MB/DM

MK	DATE	REVISION	BY	CKD	APP
9	12/03/21	ISSUED FOR CONSTRUCTION - OXYGEN INJECTION PROJECT	AAM	CV	BH
8	16/09/20	2019 S.L.D. UPDATE PROJECT "AS BUILT"	[redacted]	RA	[redacted]
7A	23/08/19	2019 S.L.D. UPDATE PROJECT "AS BUILT"- FIELD REVIEW	[redacted]	RH	[redacted]
6	20/03/18	EQUIPMENT ON DRAWING REPOSITIONED & ARC FLASH PROTECTION INSTALLED	[redacted]	JMR	[redacted]
5	22/10/14	SCOPE REVISION. NO CHANGE FROM REV 4.	[redacted]	PI	[redacted]
4C	03/04/14	ADDED FEED TO 30-SW-62 & NOTES, REINSTATED FEEDERS 5F/1 & 3F/1	[redacted]	BW	WJ/JM

MK	DATE	REVISION	BY	CKD	APP
4B	26/11/13	APPROVED FOR TENDER PURPOSES ONLY	PDW		WJ/TB
4A	15/10/13	ISSUED FOR INTERNAL REVIEW	[redacted]		WJ/TB
4	01/12/06	GENERAL REVISION	[redacted]		
3	21/04/04	30PP62D FEEDER ADDED	[redacted]		
11	11/03/22	AS BUILT	[redacted]	GB	[redacted]
10	12/10/21	RE-ISSUED FOR CONSTRUCTION	CV	JB	

REFERENCE DRAWINGS	DWG NO.

SCALE	NTS	
DRAWN	[redacted]	09/07/97
DESIGNED	[redacted]	09/07/97
CHECKED		
APPROVED		
PROJ.APP		
PROJ. FILE #.		

FIMISTON PLANT
CARBON IN LEACH (C.I.L. 3)
SUBSTATION No.68 MCC 30-SW-62
SINGLE LINE DIAGRAM

SIZE	DRAWING NUMBER	REV
A1	30\E\1058-001	11

KALGOORLIE CONSOLIDATED GOLD MINES PTY. LTD. ABN 009 377 619 003