415V 3Ph + N SUPPLY FROM
415V MCC 30-SW-62
REF. DWG. 30\E\1058=001
2000-F30-SLD-EL-10102

TO SUB STATION LV EARTH BAR
REF. DWG. 30\E\0409

415V 3 PHASE 50Hz 1200A FORM 4 FAULT LEVEL 50kA FOR 1 sec.

NEUTRAL BAR
EARTH BAR

00F 1	1F 1	1F 2	2F 1	2F 2	2F 3	2F 4	2F 5	2F 6	2F 7	2F 8	2F 9	3F 1	3F 2	3F 3	3F 4	3F 5	3F 6
	250A	250A	10A	10A	63A NOTE 1	63A NOTE 1	8A	32A	63A	63A		100A	20A	5A	50A	50A	
	CA6-140E	CA6-140E	CA3-37N	CA3-37N	ELR TZS-MC	ELR TZS-MC	CA3-37N	CA3-37N	CA3-43N	CA7-43		CA6-85	CA3-37	CA3-37		CA3-43	
	EOL CET4	EOL CET4	CT3-12 ?-?				CT3-12 6 - 9.5	CT3-42 25 - 32	CT3-52 40 - 52	CT7-45 30 - 45		CTA3-63 54A	CT3-12 10.5A	CT3-12 10.5A		CT3-32 26A	
	TORROID 300/5 1	TORROID 300/5 1								50/5 1							
	110 kW	110 kW	? kW	4 kW	?A	5 63A		7.5 kW	5.5 kW	18.5 kW		30 kW			15 kW		
	75-PW-17A BORE WATER DAM PUMP No.1 REF. DWG. 30\E\1436	75-PW-17B BORE WATER DAM PUMP No.2 REF. DWG. 30\E\1436	30-SC-66 PLANT SPILLAGE VIBRATING SCREEN	75-PW-68B GLAND WATER BOOSTER PUMP No.2 REF. DWG. 30\E\1431-002	30-CP-61 CIL 3 PRESSURE CLEANER	30-WO-62 THICKENER WELDING OUTLET	SPARE	75-PS-61 BORE WATER DAM PUMPS AREA SUMP PUMP REF. DWG. 30\E\0587	30-PS-64 FINAL TAILS AREA WASHDOWN PUMP REF. DWG. 30\E\435	30-PS-70 LAST CHANCE POND SUMP PUMP REF. DWG. 30\E\0455	SPACE	30-PP-69 PLANT SPILLAGE TRANSFER PUMP REF. DWG. 30\E\0437	SPARE	SPARE	30-PS-66 SPILLAGE SILT TRAP SUMP PUMP	SPARE	SPACE
	TO PROCESS CONTROL CUBICLE	TO PROCESS CONTROL CUBICLE		TO PROCESS CONTROL CUBICLE						TO PROCESS CONTROL CUBICLE							

00R 1	00R 2	1R 1	1R 2	1R 3	1R 4	1R 5	1R 6	2R 1	2R 2	2R 3	2R 4	2R 5	2R 6	2R 7	2R 8	2R 9	3R 1	3R 2	3R 3
		8A	20A	20A	100A	20A		10A	10A	10A	10A	20A	10A	32A	100A NOTE 1	63A			250A
		CA3-16	CA3-37N	CA3-37N	CA6-85			CA3-37N	CA3-37N	CA3-37N	CA3-37N	CA3-43	CA3-43		ELR TZS-MC	CA3-37-N-11			CA6-140E
		CT3-12 1.8 - 2.7	CT3-12 2.5 - 4	CT3-12 2.5 - 4	CTA3-63 52-63			CT3-12 6 - 9.5	CT3-12 6 - 9.5	CT3-12 6 - 9.5	CT3-12 6 - 9.5	CT3-12 8.5 - 12.5	CT3-12 6 - 9.5			CT3-42			CT6-150 105-150
		CT3-12 1.8 - 2.7	CT3-12 2.5 - 4	CT3-12 2.5 - 4	75/5	415/110V 3000VA										NOTE D.1			200/5
			2.2 kW	2.2 kW	30 kW	20A L1	20A N1	4 kW	4 kW	4 kW	4 kW				5 63A	18.5 kW			75 kW
			30-SC-64A FINE CARBON DEWATERING SCREEN No.1 REF. DWG. 30\E\1432	30-SC-64B FINE CARBON DEWATERING SCREEN No.2 REF. DWG. 30\E\1432	F30-SC-62A CIL 3 TANK A CARBON SAFETY SCREEN REF. DWG. 30\E\0588-002	MCC 110V AC BUS REF. DWG. 30\E\1420 TIER 110V SUPPLY REF. DWG. 30\E\1420	PROCESS CONTROL CUBICLE CIL 3 30-PC-62 REF. DWG. 30\E\1430	30-SL-61A CARBON SAFETY SCREEN No.1 REF. DWG. 30\E\1433	30-SL-61B CARBON SAFETY SCREEN No.2 REF. DWG. 30\E\1433	30-SL-61C CARBON SAFETY SCREEN No.3 REF. DWG. 30\E\1433	30-SL-61D CARBON SAFETY SCREEN No.4 REF. DWG. 30\E\1433	SPARE	SPARE	SPARE	30-WO-?? CIL 3 TANK G WELDING OUTLET	SPARE 18.5kW STARTER F30-PP-65A-1 CIL 3 TANK A CARBON TRANSFER PUMP REF. DWG. 30\E\0588-003 2000-F30-SCM-EL-10045	SPACE	SPACE	F30-AG-62G CIL TANK G AGITATOR REF. DRG. 30\E\0588-001
		SPACE	SPACE	SPARE		TO PROCESS CONTROL CUBICLE													

12

Approved	X
Approved as Noted	
Not Approved	
For Information Only	


Signed: C Laird
Date: 20/11/2025

ACCEPTANCE DOES NOT RELIEVE THE SUPPLIER / CONTRACTOR OF ITS RESPONSIBILITY OR LIABILITIES UNDER THE PURCHASE ORDER / CONTRACT

LEGEND

LOCATION

SUB STATION 68
30-SW-64

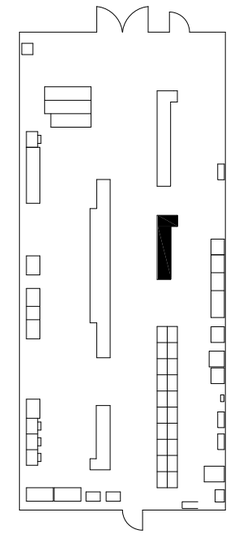

NOTES

1. EARTH LEAKAGE CIRCUIT BREAKERS SHALL HAVE 300mA SENSITIVITY FOR WELDING OUTLETS.

KCGM GROWTH PROJECT DEMOLITION NOTES

D.1. F30-PP-65A-1 CABLING TO BE DISCONNECTED AND MADE SAFE AT BOTH ENDS.

LEGEND
- STAGE 1 - NEW
- STAGE 1 - REMOVE
- STAGE 1 - DECOMMISSIONED (OTHERS)
- STAGE 2 - NEW
- STAGE 2 - REMOVE
- STAGE 2 - DECOMMISSIONED (OTHERS)

KCGM GROWTH PROJECT

DRAWING NO.
2000-F30-SLD-EL-10105

REV	DATE	DESCRIPTION	CHECK	TECH APP
0	10/11/25	APPROVED FOR CONSTRUCTION	[redacted]	

SUPERCEDES 30\E\0410

MK	DATE	REVISION	BY	CKD	APP
12	10/07/24	ISSUED FOR CONSTRUCTION	PM	CL	RH
11	08/11/23	AS BUILT	[redacted]	KVN	[redacted]
10A	23/08/19	2019 S.L.D. UPDATE PROJECT "AS BUILT"- FIELD REVIEW	[redacted]	RH	[redacted]
9	19/04/12	75PW68B VSD INSTALLED	[redacted]	AM	[redacted]
8	3/03/09	ADDED 75PS06 PUMP DETAILS	[redacted]	MS	MS
7	14/7/08	ADDED 30-PS-70 LAST CHANCE POND SUMP PUMP	TW	MS	MS
6	3-5-07	30PS66 & 30PS67 DRIVE MADE REDUNDANT	BJ		
5	1-12-06	GENERAL REVISION	[redacted]		
4	2/4/02	AGITATOR ADDED TO 30-PS-66		IGC	
3	26/07/99	NEW PLANT SPILLAGE TIERS 5F/1-5	CV	PRL	[redacted]
2	1/07/99	TIER 2F/1 75-PW-68A NOW SPARE	CV	RB	[redacted]
1	7/97	'AS BUILT' FIMISTON PLANT 1997 CONTRACT# 700746	[redacted]		

REFERENCE DRAWINGS	DWG NO.
SUB STATION No.68 MCC 30-SW-61, 62, 63, 64 DRIVE PANEL GENEARL LAYOUT	30\E\1040 - 1043
SUB STATION No.68 MCC AND GENERAL EQUIPMENT LAYOUT	30\E\1039

SCALE	NTS
DRAWN	[redacted] 9/7/97
DESIGNED	9/7/97
CHECKED	
APPROVED	
PROJ.APP	
PROJ. FILE #.	

FIMISTON PLANT
CARBON IN LEACH (C.I.L. 3)
SUB STATION No.68 MCC 30-SW-64
SINGLE LINE DIAGRAM SHEET 1

SIZE	DRAWING NUMBER	REV
A1	30\E\1061-001	12

KALGOORLIE CONSOLIDATED GOLD MINES PTY. LTD. ACN 009 377 619