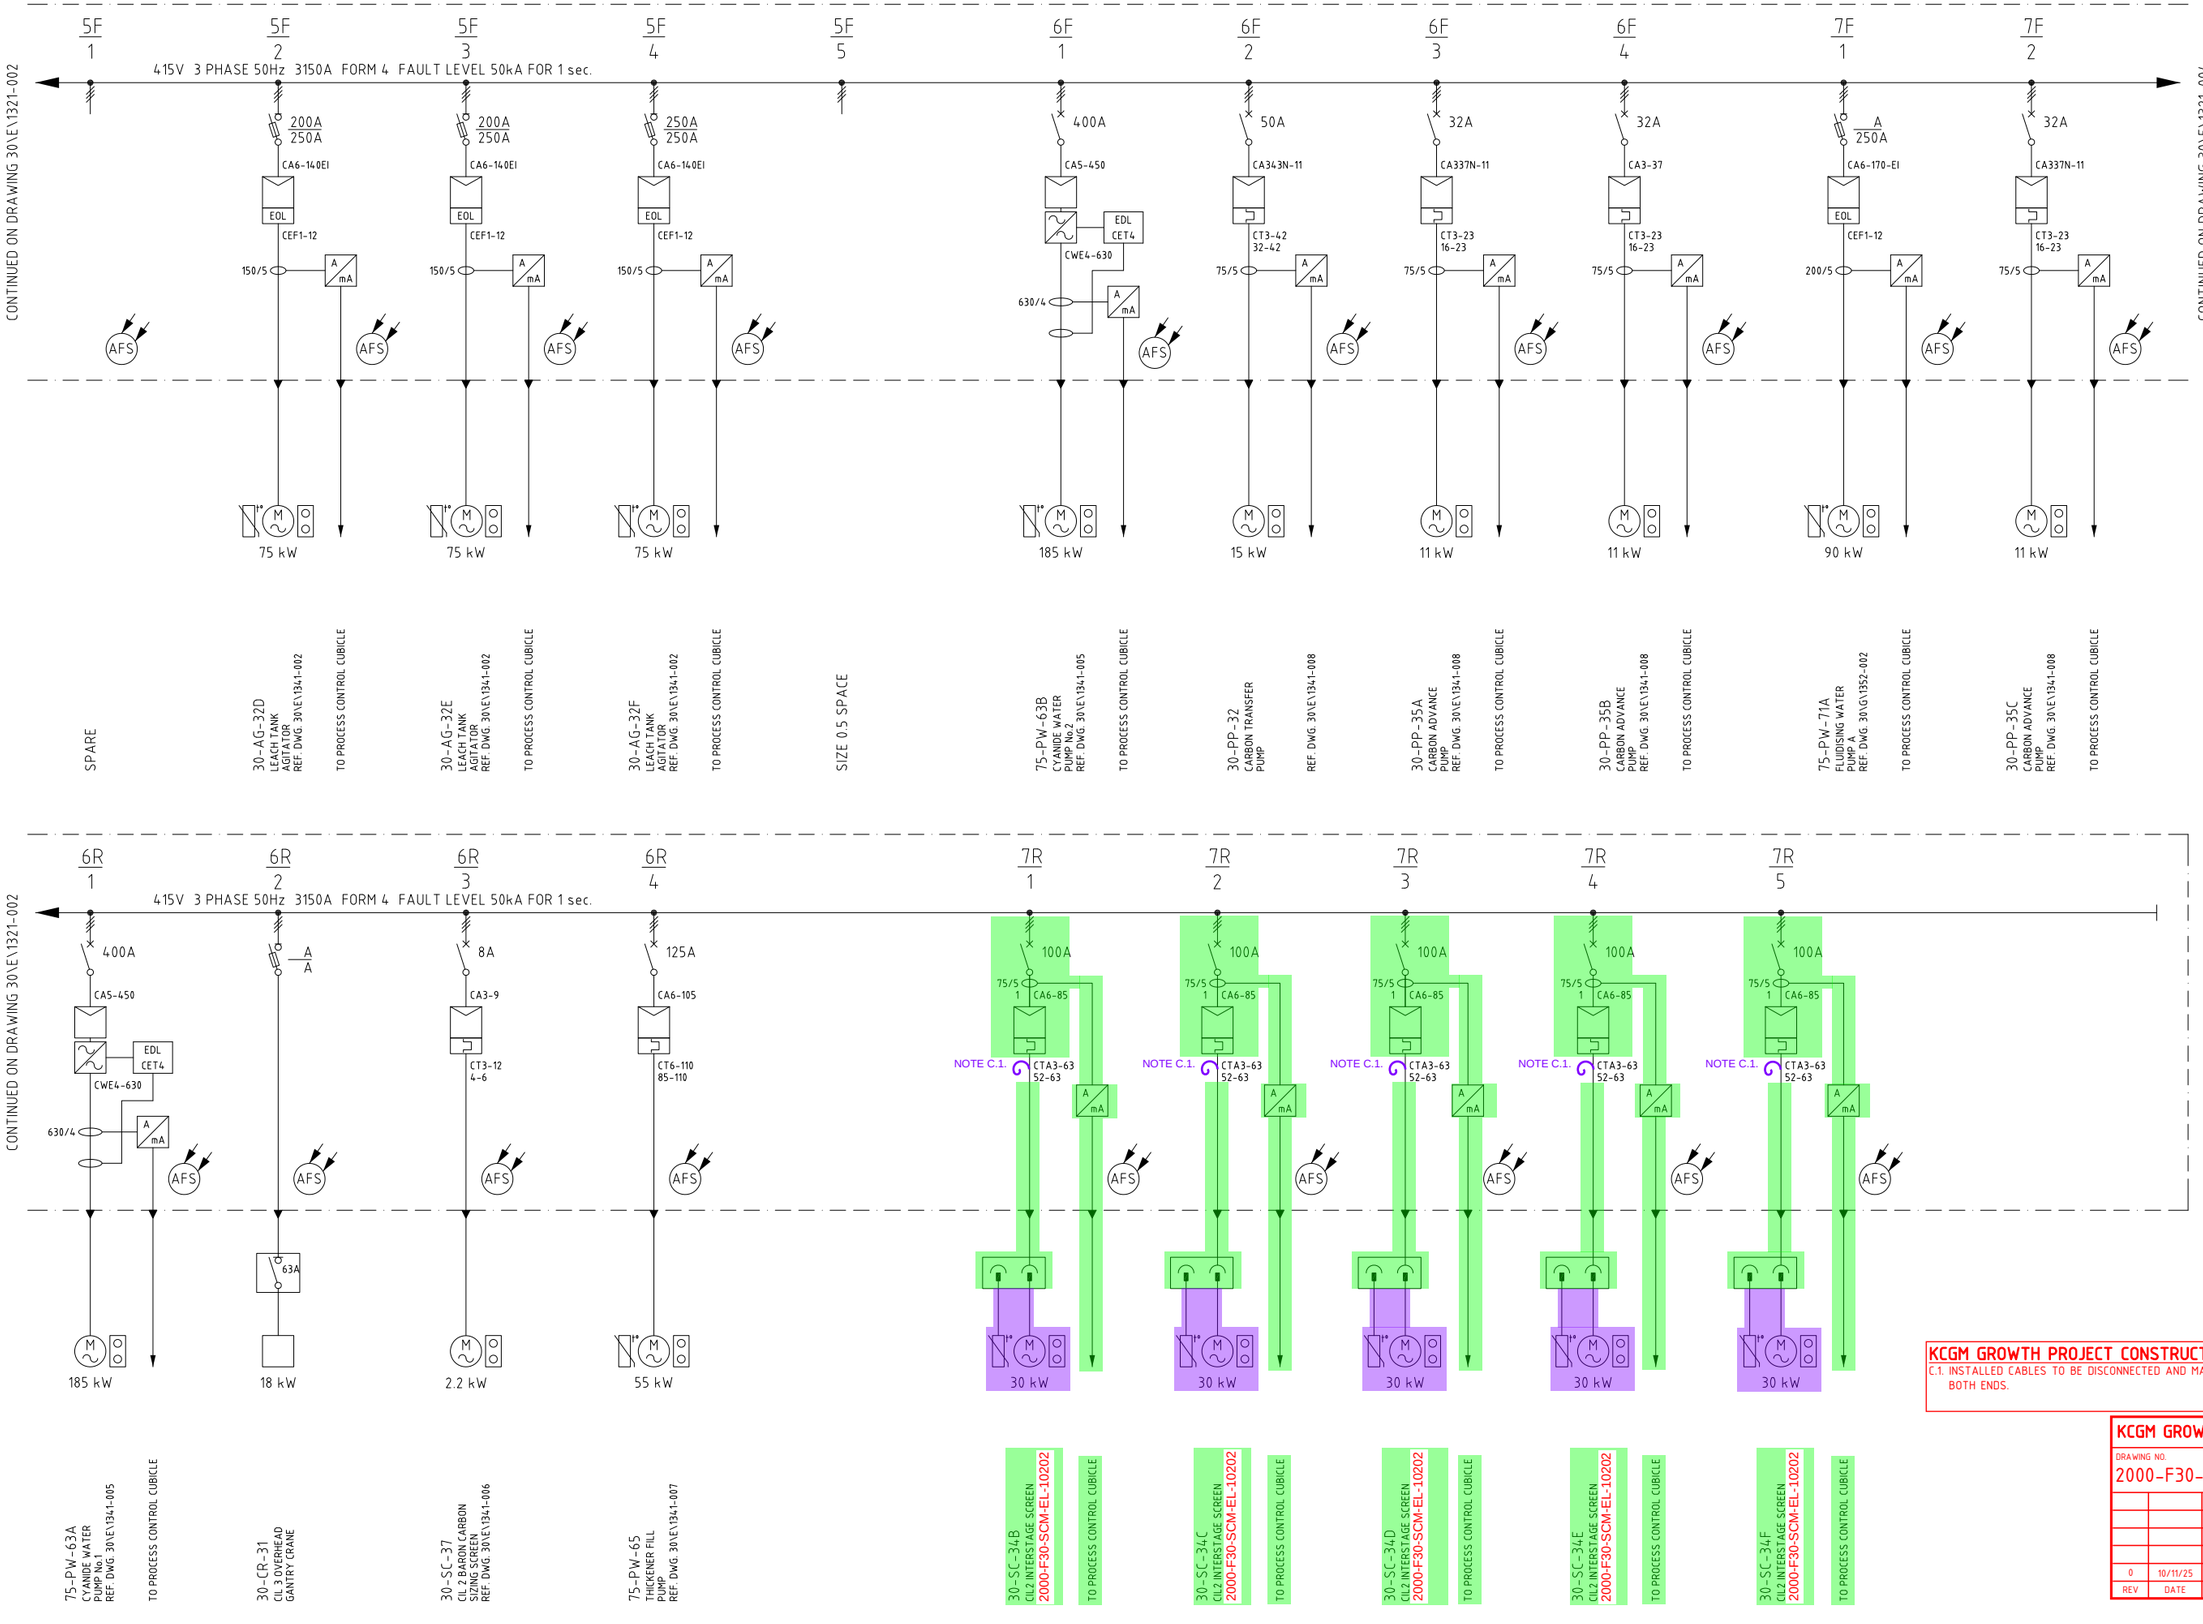


LEGEND

NORTHERN STAR RESOURCES LIMITED


Approved	X
Approved as Noted	
Not Approved	
For Information Only	

Signed: C Laird — Date: 20/11/2025

ACCEPTANCE DOES NOT RELIEVE THE SUPPLIER / CONTRACTOR OF ITS RESPONSIBILITY OR LIABILITIES UNDER THE PURCHASE ORDER / CONTRACT

LOCATION

SUB STATION 38
30-SW-31

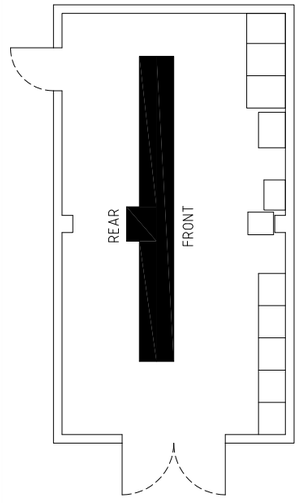

NOTES

1. WHERE DRIVES & FEEDERS REQUIRE 2 OFF CIRCUIT BREAKER AUXILLARIES THEN AN ADDITIONAL POLE SPACE IS REQUIRED.
   No. OF POLES USED SHOWN IN BRACKETS.
2. FUSES TO BE RATED FOR TYPE 2 SHORT CIRCUIT CO-ORDINATION.
3. ALL AFS (ARC FLASH SENSORS) ARE CONNECTED TO THE ARC FLASH RELAY VIA I/O UNITS

KCGM GROWTH PROJECT CONSTRUCTION NOTES

C.1. INSTALLED CABLES TO BE DISCONNECTED AND MADE SAFE AT BOTH ENDS.

LEGEND

- EXISTING
- NON-EXISTENT
- STAGE 1 - NEW
- STAGE 1 - REMOVE
- STAGE 1 - DECOMMISSIONED (OTHERS)
- STAGE 2 - NEW
- STAGE 2 - REMOVE
- STAGE 2 - DECOMMISSIONED (OTHERS)

KCGM GROWTH PROJECT

DRAWING NO.
2000-F30-SLD-EL-10201

REV	DATE	DESCRIPTION	CHECK	TECH APP
0	10/11/25	APPROVED FOR CONSTRUCTION		DM

SUPERSEDES 30\E\1036-003

MK	DATE	REVISION	BY	CKD	APP
7A	22/08/19	2019 S.L.D. UPDATE PROJECT "AS BUILT"- FIELD REVIEW	[redacted]	RH	[redacted]
6	24/07/18	ARC FLASH SENSORS INSTALLED	RH	JMR	JMR
5	29/12/04	75-PW-72A DETAILS ADDED	[redacted]		
4	07/04/04	GRAVITY CCT PROJECT - ISSUED FOR CONSTRUCTION	[redacted]	DBG	[redacted]
3	17/03/04	GRAVITY CCT PROJECT - ISSUED FOR MCC CONSTRUCTION	[redacted]	DBG	
2	03/03/04	ISSUED FOR TENDER	[redacted]	MGM	[redacted]
1	01/09/01	ASBUILD MODIFICATIONS ADDED	[redacted]	AB	

REFERENCE DRAWINGS

DWG NO.

SCALE	NTS	
DRAWN	[redacted]	01/09/01
DESIGNED	KCGM	01/09/01
CHECKED	KCGM	01/09/01
APPROVED	KCGM	01/09/01
PROJ.APP	KCGM	01/09/01
PROJ. FILE #.		

FIMISTON PLANT
LEACH ADSORPTION & THICKENING
SUBSTATION No. 38 MCC 30-SW-31
SINGLE LINE DIAGRAM

SIZE	DRAWING NUMBER	REV
A1	30\E\1321-003	7A

KALGOORLIE CONSOLIDATED GOLD MINES PTY. LTD. ABN 009 377 619 003